

NARRATIVE

THIS SURVEY WAS PERFORMED AT THE REQUEST OF BOB KIMBERLING. THE PURPOSE OF THIS SURVEY WAS TO SUBDIVIDE SECTION 33 AND MONUMENT THE NE, NW, AND SE CORNERS OF THE NE1/4SE1/4 AND THE NE AND NW CORNERS OF THE SE1/4NE1/4.


A SEARCH WAS MADE OF THE AVAILABLE RECORDS PERTAINING TO THIS SURVEY. MY RESEARCH DISCLOSED THAT THIS SECTION WAS ORIGINALLY SURVEYED IN JULY 1869 BY JOHN B. DAVID, U.S. DEPUTY SURVEYOR, UNDER CONTRACT NO. 131, DATED JUNE 8, 1869. SUBSEQUENTLY ON AUG. 4 & 5, 1913, VERNON GLAZE, COUNTY SURVEYOR RETRACED CERTAIN EXTERIOR LINES OF THIS SECTION AND SUBDIVIDED THE SECTION AS SHOWN ON RECORD OF SURVEY NO. 13G, RECORDED IN SURVEYOR'S RECORD BOOK B, PAGE 40. IN 1978, I RETRACED THE WEST BOUNDARY DURING RECORD SURVEY NO.514. IN 1980, I RETRACED THE SOUTH BOUNDARY DURING RECORD SURVEY NO. 619.

FIELD MEASUREMENTS WERE MADE TO LOCATE EXISTING CONTROLLING MONUMENTS OF RECORD AFFECTING THE SUBDIVISION OF THIS SECTION. WE FOUND MONUMENTED CORNERS OF RECORD AT THE NE, SE, S1/4,

(CON'T.)
W1/4, AND NW CORNER OF THE SECTION, AND AT THE N1/16 CORNER BETWEEN SECTIONS 32 AND 33 AS SHOWN HEREON. WE SEARCHED FOR BUT DID NOT FIND ANY SUITABLE CORNER EVIDENCE AT THE E1/4 CORNER NOR THE N1/4 CORNER. WE ALSO SEARCHED FOR BUT DID NOT FIND ANY SUITABLE CORNER EVIDENCE AT THE SE AND NE CORNERS OF THE SW1/4NE1/4, WHICH GLAZE INDICATED THAT HE SET IN SURVEY NO. 13G.

WITH NO EVIDENCE OF THE ORIGINAL CORNER OR GLAZE'S CORNER AT THE E1/4 CORNER, I SET THE E1/4 CORNER AT SINGLE PROPORTIONATE MEASURE BETWEEN THE FOUND MONUMENTS AT THE NE AND SE CORNERS OF THE SECTION. WITH NO CORNER EVIDENCE BEING FOUND AT THE N1/4 CORNER, I SET THE N1/4 CORNER AT SINGLE PROPORTIONATE MEASURE BETWEEN THE FOUND MONUMENTS AT THE NE AND NW CORNERS OF THE SECTION. WE THEN SUBDIVIDED SECTION 33 AND SET THE 1/16 CORNERS SHOWN HEREON.

SEE CORNER RESTORATION SHEETS FOR DETAILS OF MONUMENTS SET AT THE N1/4 COR. AND THE E1/4 COR., FILED IN CORNER RESTORATION BOOK.

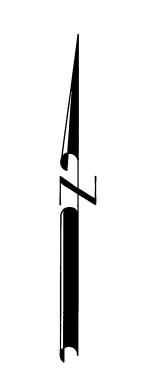

BASIS OF BEARINGS

RECORD MAP OF SURVEY NO. 514
AS SHOWN

LEGEND

- FOUND 1½" GALV. IRON PIPE WITH ATTACHED GRANT COUNTY SURVEYOR BRASS CAP.
- FOUND 5/8" IRON PIN.
- SET 2½" x 30" ALUMINUM PIPE WITH ATTACHED BAGETT GRIFFITH & BLACKMAN ALUMINUM CAP, MARKED AS SHOWN.
-) GLO RECORD BEARING AND DISTANCE.
- (()) GLAZE'S RECORD BEARING AND DISTANCE, SEE SURVEY NO. 13G IN SURVEYOR'S RECORD BOOK 'B' PAGE 40.
- [] RECORD BEARING AND DISTANCE FROM INDICATED RECORDED SURVEY NO.
 - FOUND MONUMENT FROM RECORDED SURVEY NO. SURVEY NO. APPEARS IN BOX.

REFERENCES

RECORD MAP OF SURVEY NO.'S 514, 619 AND 621.

DEED RECORD BOOK 92 PAGES 45-46
97 224

RECEIVED AND FILED

NOV. 15, 1996
OFFICE OF COUNTY SURVEYOR

ATTEST: Muy Ruell

PROFESSIONAL LAND SURVEYOR

OREGON
JULY 12, 1963
ROBERT D. BAGETT

598 Renewal Date 12/31/97

BAGETT, GRIFFITH & BLACKMAN 217 N. Canyon Blvd. John Day, Oregon

MAP OF SURVEY
DEPENDENT RESURVEY
AND SUBDIVISION OF SECTION 33,
T12S,R34E, W.M.

GRANT COUNTY, OREGON

SURVEYED FOR BOB KIMBERLING

SURVEYED BY RDB & SDF & DEM 11/01/96

Scale: 1"=500' Drawn by: G.J.R.

RECORD MAP OF SURVEY NO. 1431