



RECEIVED AND

FILED

JUL 2 3 1997

POFFICE OF COUNTY SURVEYOR

This survey was performed at the request of Larry Slaughter. The purpose of this survey was to monument the selected lines of Mr. Slaughter's property described in Deed Instrument No.


After searching the available records pertaining to this survey, I found two surveys performed by Vernon Glaze, Survey No. 2G done in January 1913 and Survey No. 7G done in June and July 1914. John B. David performed the original GLO survey along the standard parallel in 1869 and the township was originally surveyed by Jason Owen in 1873.

The NW corner of Section 35 is lost, the John Day River was north of this corner when Mr. Owen originally set it in 1873, now the John Day River is several hundred feet south of the corner position and the position falls in a plowed field. I reestablished this corner by double proportionate measure between the found corners 1/2 mile north and 1/2 mile south and the found corners 1 mile east and 1 mile west as shown hereon.

The east 1/4 corner of Section 35 falls in a road way and no evidence of it could be found. The north 1/4 corner position falls on a steep hillside and no evidence of it's position was found, these positions were calculated by single proportionate measurement but were not monumented during this survey. These sections were subdivided in the usual manner and the corners required for this survey were set as shown hereon.

The westerly boundary was established by holding the deed call at the rim rock and at deed record from the east 1/4 corner of Section 27.

This survey was performed with a Topcon GTS-4 total station, with a closed loop random traverse.

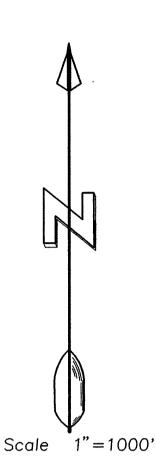


BASIS OF BEARINGS

SOLAR OBSERVATION

LEGEND

- Found 1½" iron pipe with attached 2½" brass cap, see Survey No. 7G.
- Set 2½" aluminum pipe with attached 2½" aluminum cap. See Land Corner Monumentation sheets filed separately for details.
- Set 5/8"x30" iron pin with attached red plastic cap marked CORNERSTONE SURVEYING, Inc.
- Set 2"x2" aluminum rock cap, grouted into rim rock, marked OPLS 2734.
- Set 5/8"x30" iron pin with attached 2" aluminum cap marked CORNERSTONE SURVEYING, Inc.
 See Land Corner Monumentation sheets filed separately for details.
- X----X Fence Line
-) GLO record bearing and distance.
- (()) Vernon Glaze, Survey No. 7G, record bearing and distance.
- Vernon Glaze, Survey No. 2G, record bearing and distance.
- [] Deed record bearing and distance.

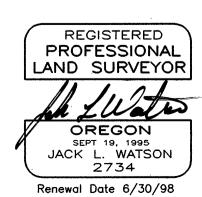



CORNERSTONE SURVEYING, Inc.

233 S. Canyon Blvd., John Day, Oregon (541) 575-1813

MAP OF SURVEY
DEPENDENT RESURVEY AND SUBDIVISION OF
SECTIONS 26, 27 AND 35
T12S, R26E, W.M.

GRANT COUNTY, OREGON

SURVEYED FOR: Larry Slaughter

SURVEYED BY : Jack Watson Date: 6/12/97

DRAWN BY : Jack Watson

MAP OF SURVEY NO. 1443