


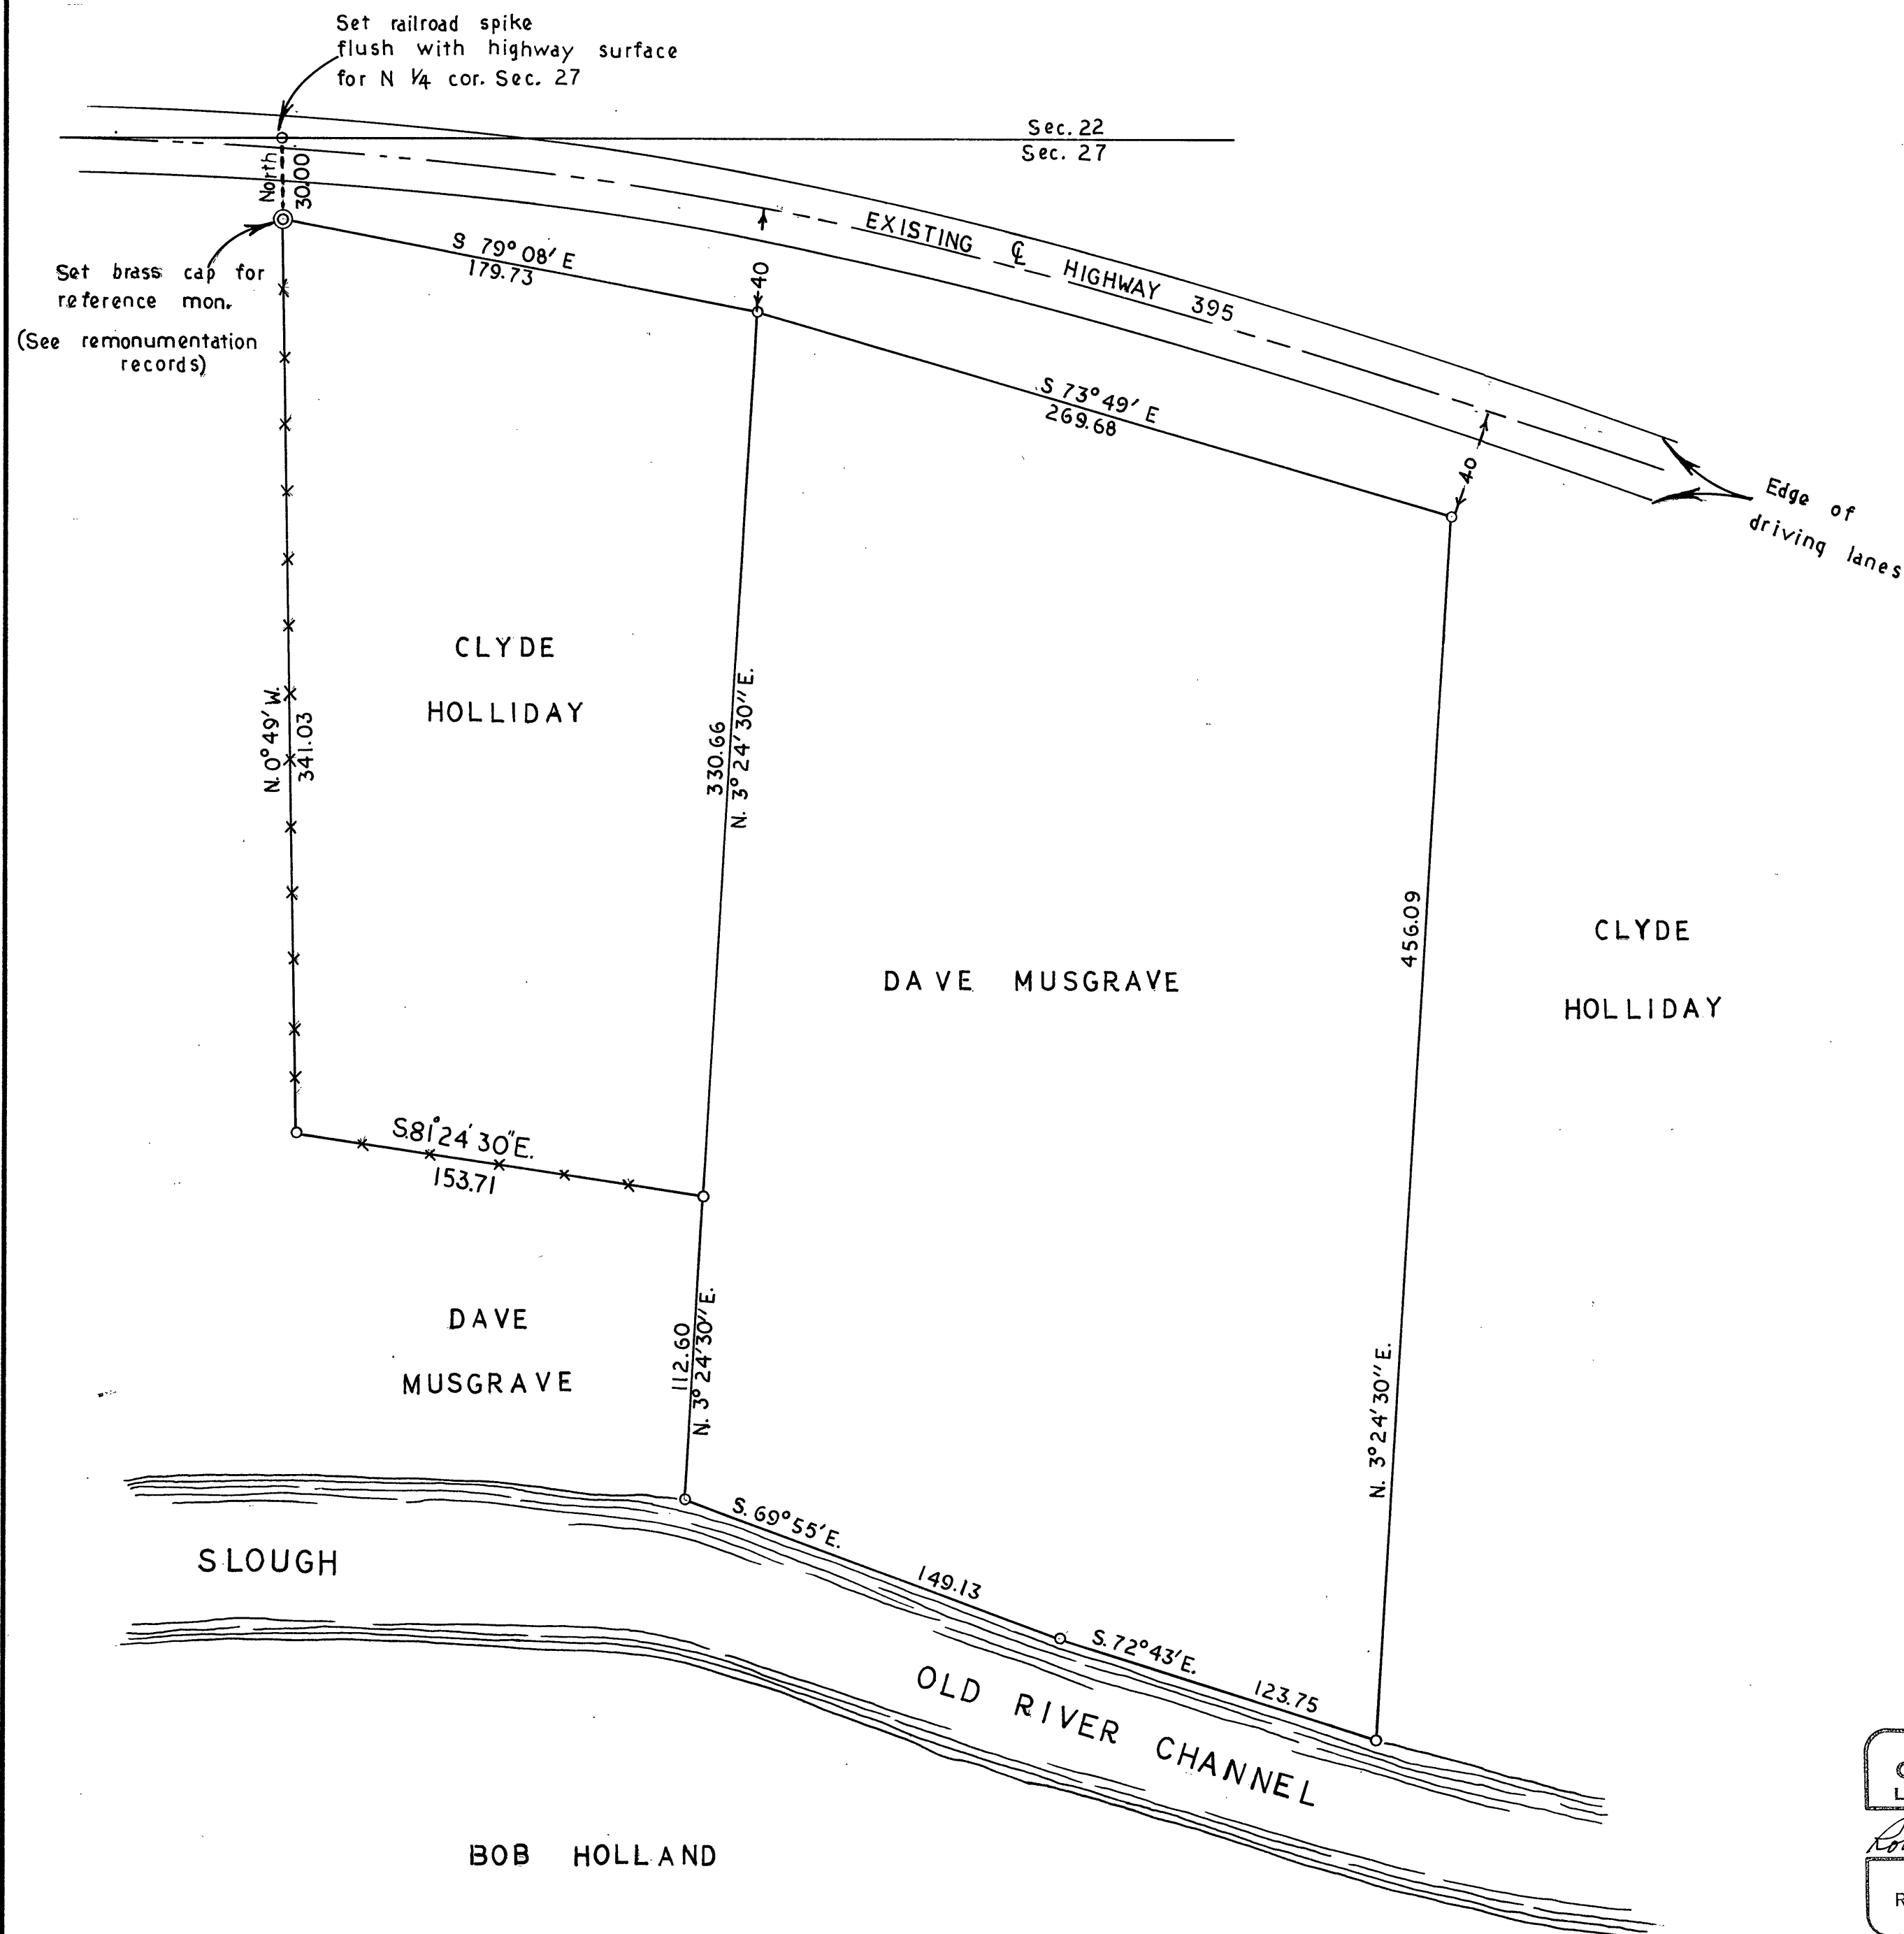

RECEIVED AND
FILED
JUL 9 1969
JOHN LIVERA, Deputy Clerk
By _____ Deputy

BASIS OF BEARING
Solar Observation

LEGEND
 o 5/8" x 30" iron pin set unless otherwise noted
 @ 1 1/2" x 30" Brass Cap set
 x-x Fence

NOTE
No Highway R.O.W. monuments were found. The ϵ shown indicates the existing center stripe between driving lanes.

REGISTERED
OREGON
LAND SURVEYOR
Robert D. Bagett
JULY 12, 1963
ROBERT D. BAGETT
598

BAGETT & GRIFFITH SURVEYING		
John Day, Oregon		
Map of Survey		
Boundary Agreement Lines in		
N. ½ Sec. 27, T. 13S, R. 30 E., W.M.		
Grant County, Oregon		
SURVEYED FOR	Holliday — Musgrave — Holland	
SURVEYED BY	R.D.B. D.I.G. R.A.M.	6/69
Scale: 1" = 50	Drawn by: D.F.	6/10/69