

NARRATIVE

THIS SURVEY WAS PERFORMED AT THE REQUEST OF DICK CHASE AND JERRY DAAKE.

THE PURPOSE OF THIS SURVEY WAS TO LOCATE THE E-W CENTER LINE OF SECTION 25, TO POST THAT LINE FROM THE W1/4 CORNER TO THE HIGHWAY AND TO SET A PIN AT OR NEAR THE NE CORNER OF THE CHASE TRACT.

A SEARCH WAS MADE OF THE AVAILABLE RECORDS PERTAINING TO THIS SURVEY. FIELD MEASUREMENTS WERE MADE TO LOCATE THE EXISTING CONTROLLING MONUMENTS OF THIS SECTION, AS SHOWN HEREON.

THE WEST 1/4 CORNER IS REMONUMENTED FROM ORIGINAL EVIDENCE WITH A GRANT COUNTY SURVEYOR BRASS CAPPED IRON PIPE WHICH I SET IN 1972. THE EAST 1/4 CORNER OF SECTION 25 IS MONUMENTED WITH A 1939 GOVERNMENT LAND OFFICE BRASS CAPPED IRON PIPE. THE OLD 1/4 CORNER BETWEEN SECTIONS 25 AND 30 LYING 224 FEET TO THE NORTH OF THE EAST 1/4 CORNER IS MONUMENTED WITH A G.L.O. BRASS CAPPED IRON PIPE, BUT IS NOW MARKED FOR AN ANGLE POINT IN THE SECTION LINE BETWEEN SECTIONS 25 AND 30.

WE RAN A TRUE LINE FROM THE WEST 1/4 CORNER TOWARD THE EAST 1/4 CORNER AS DESCRIBED ABOVE AND SET A PIN AT THE CHASE DEED RECORD DISTANCE TO THE WESTERLY HIGHWAY RIGHT OF WAY LINE.

RECEIVED AND FILED


Aug. 29,1997
OFFICE OF COUNTY SURVEYOR

ATTEST: Steven & Follwale,

PROFESSIONAL LAND SURVEYOR

OREGON
JULY 12, 1963
ROBERT D. BAGETT
598

Renewal Date 12/31/97

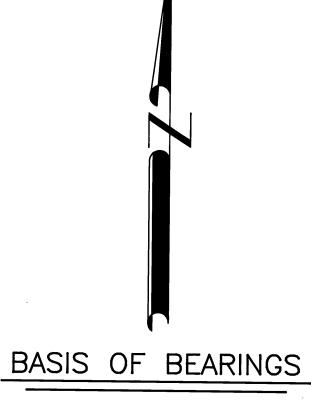

SOLAR OBSERVATION

LEGEND

- FOUND 1½" GALV. IRON PIPE WITH ATTACHED GRANT COUNTY SURVEYOR BRASS CAP.
- FOUND 1" GALV. IRON PIPE WITH ATTACHED U.S. GENERAL LAND OFFICE SURVEY BRASS CAP.
- O SET 5/8"X30" IRON PIN WITH ATTACHED YELLOW PLASTIC CAP MARKED BGB SURVEY MARKER.
- () RECORD BEARING AND DISTANCE
- FOUND MONUMENT FROM RECORDED SURVEY NO. SURVEY NO. APPEARS IN BOX.
- X FENCE LINE

REFERENCES

U.S. G.L.O. SURVEYS AND NOTES.


RECORD MAP OF SURVEY NO. 262

DEED RECORD BOOK 80 PAGE 382-383

85 527-530

129 790

140 80-81

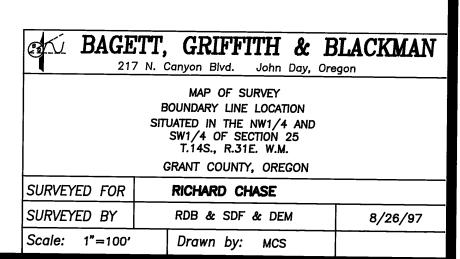

RECORD MAP OF SURVEY NO. 1451