


**SURVEY FOR
UMATILLA NATIONAL FOREST
OF
THE TOWNSHIP LINE
BETWEEN
TOWNSHIPS 6 AND 7 SOUTH,
RANGE 34 EAST,
WILLAMETTE MERIDIAN
GRANT & UMATILLA COUNTIES, OREGON
SEPTEMBER, 1997**

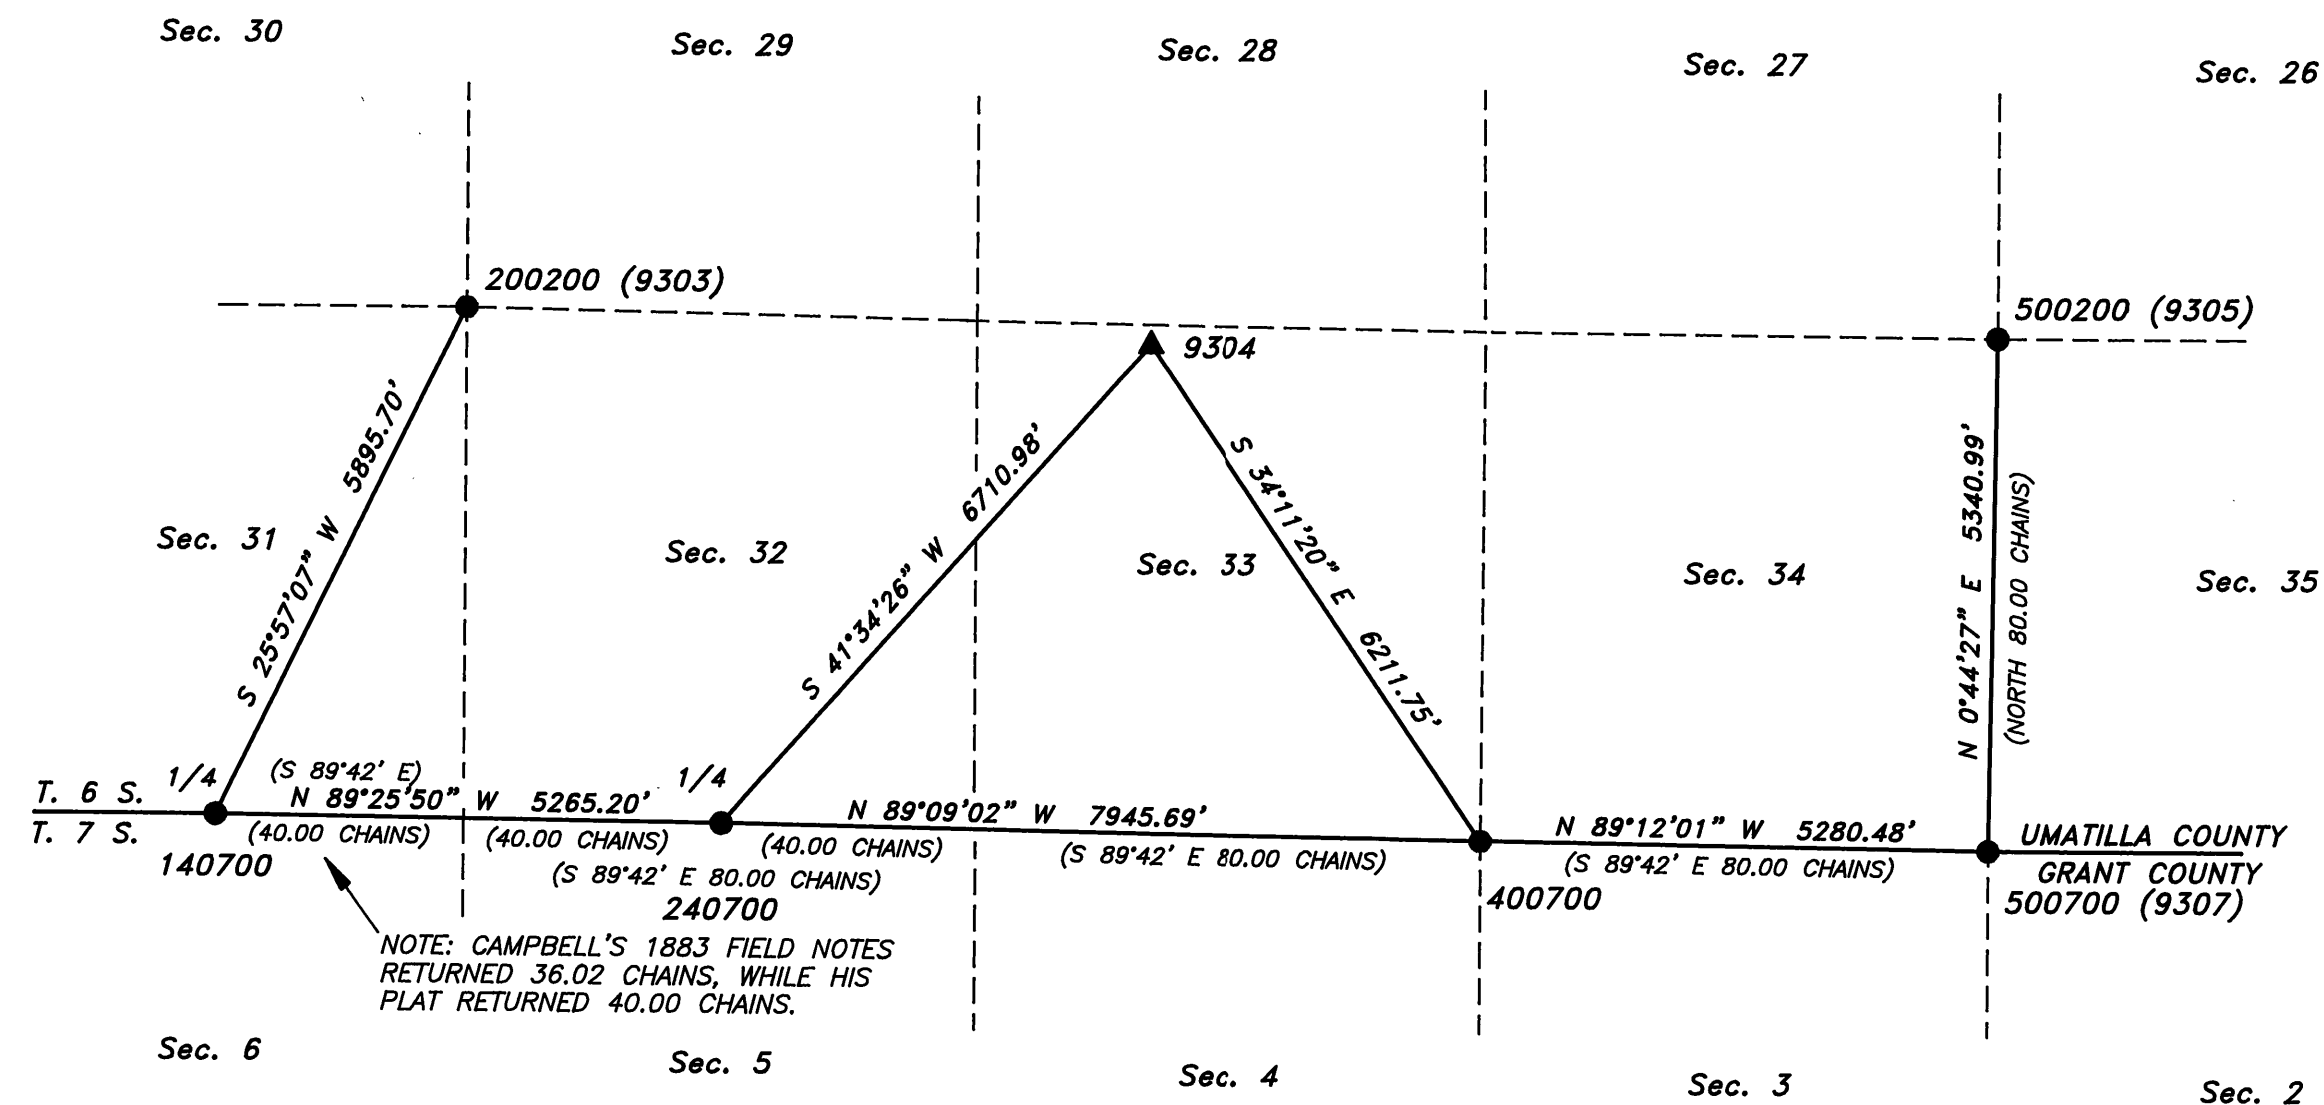

DATUM: NAD83(1991) OREGON HIGH PRECISION GPS NETWORK
STATE PLANE COORDINATES: OREGON NORTH ZONE IN METERS

NO.	LATITUDE	LONGITUDE	ELLIPSOID HEIGHT (METERS)	NORTHING(Y)	EASTING(X)
9304	45°00'40.12007" N.	118°37'47.13990" W.	1583.194	151106.234	2647405.677
140700	44°59'51.07854" N.	118°40'02.35202" W.	1522.609	149525.027	2644480.263
200200 (9303)	45°00'43.40740" N.	118°39'26.45244" W.	1477.475	151157.715	2645229.447
240700	44°59'50.56198" N.	118°38'49.10373" W.	1706.394	149545.675	2646084.395
400700	44°59'49.39918" N.	118°36'58.57237" W.	1658.595	149565.770	2648505.297
500200 (9305)	45°00'41.38918" N.	118°35'44.15486" W.	1562.488	151208.297	2650096.829
500700 (9307)	44°59'48.67175" N.	118°35'45.11579" W.	1644.567	149581.032	2650114.143

LEGEND

- ▲ GPS POINT
- CORNER FOUND
- () RECORD MEASUREMENT
(FRANK W. CAMPBELL 1883)

SCALE: 1 INCH = 2000 FEET

SCALE IN METERS SCALE IN FEET
1 METER = 3.28084 FEET

REVIEWED BY:
Dennis L. Layford Nov 5, 1997
SIGNATURE DATE

I CERTIFY THAT THIS SURVEY WAS PERFORMED AT THE
REQUEST OF THE UMATILLA NATIONAL FOREST SUPERVISOR

David A. Schlaich 11/4/97
SIGNATURE DATE

REGISTERED
PROFESSIONAL
LAND SURVEYOR

David A. Schlaich
OREGON
JULY 16, 1987
DAVID A. SCHLAICH
2308
RENEWS 06/30/98

I, DAVID A. SCHLAICH, A REGISTERED LAND SURVEYOR IN THE STATE OF OREGON, HEREBY CERTIFY THAT THIS PLAT AND THE NOTES HEREON ARE A TRUE AND CORRECT REPRESENTATION OF A SURVEY I CONDUCTED IN SEPTEMBER OF 1997, AT THE REQUEST OF THE UMATILLA NATIONAL FOREST, IN ACCORDANCE WITH THE STATUTES OF THE STATE OF OREGON AND THE 1973 B.L.M. MANUAL OF SURVEYING INSTRUCTIONS.

DAVID A. SCHLAICH -- RLS 2308
UMATILLA NATIONAL FOREST
2517 S.W. HAILEY AVENUE
PENDLETON, OREGON 97801
PHONE: (541) 278-3747

RECEIVED AND
FILED

NOV 13 1997

OFFICE OF COUNTY SURVEYOR
Attest: *Sharon D. Galt*