


MAP OF SURVEY
Sections 31, 32, 33
Township 11 S., Range 29 E.
Grant County, Oregon

Basis of Bearings
SOLAR OBSERVATIONS

MAGNETIC DECLINATION = 20° E

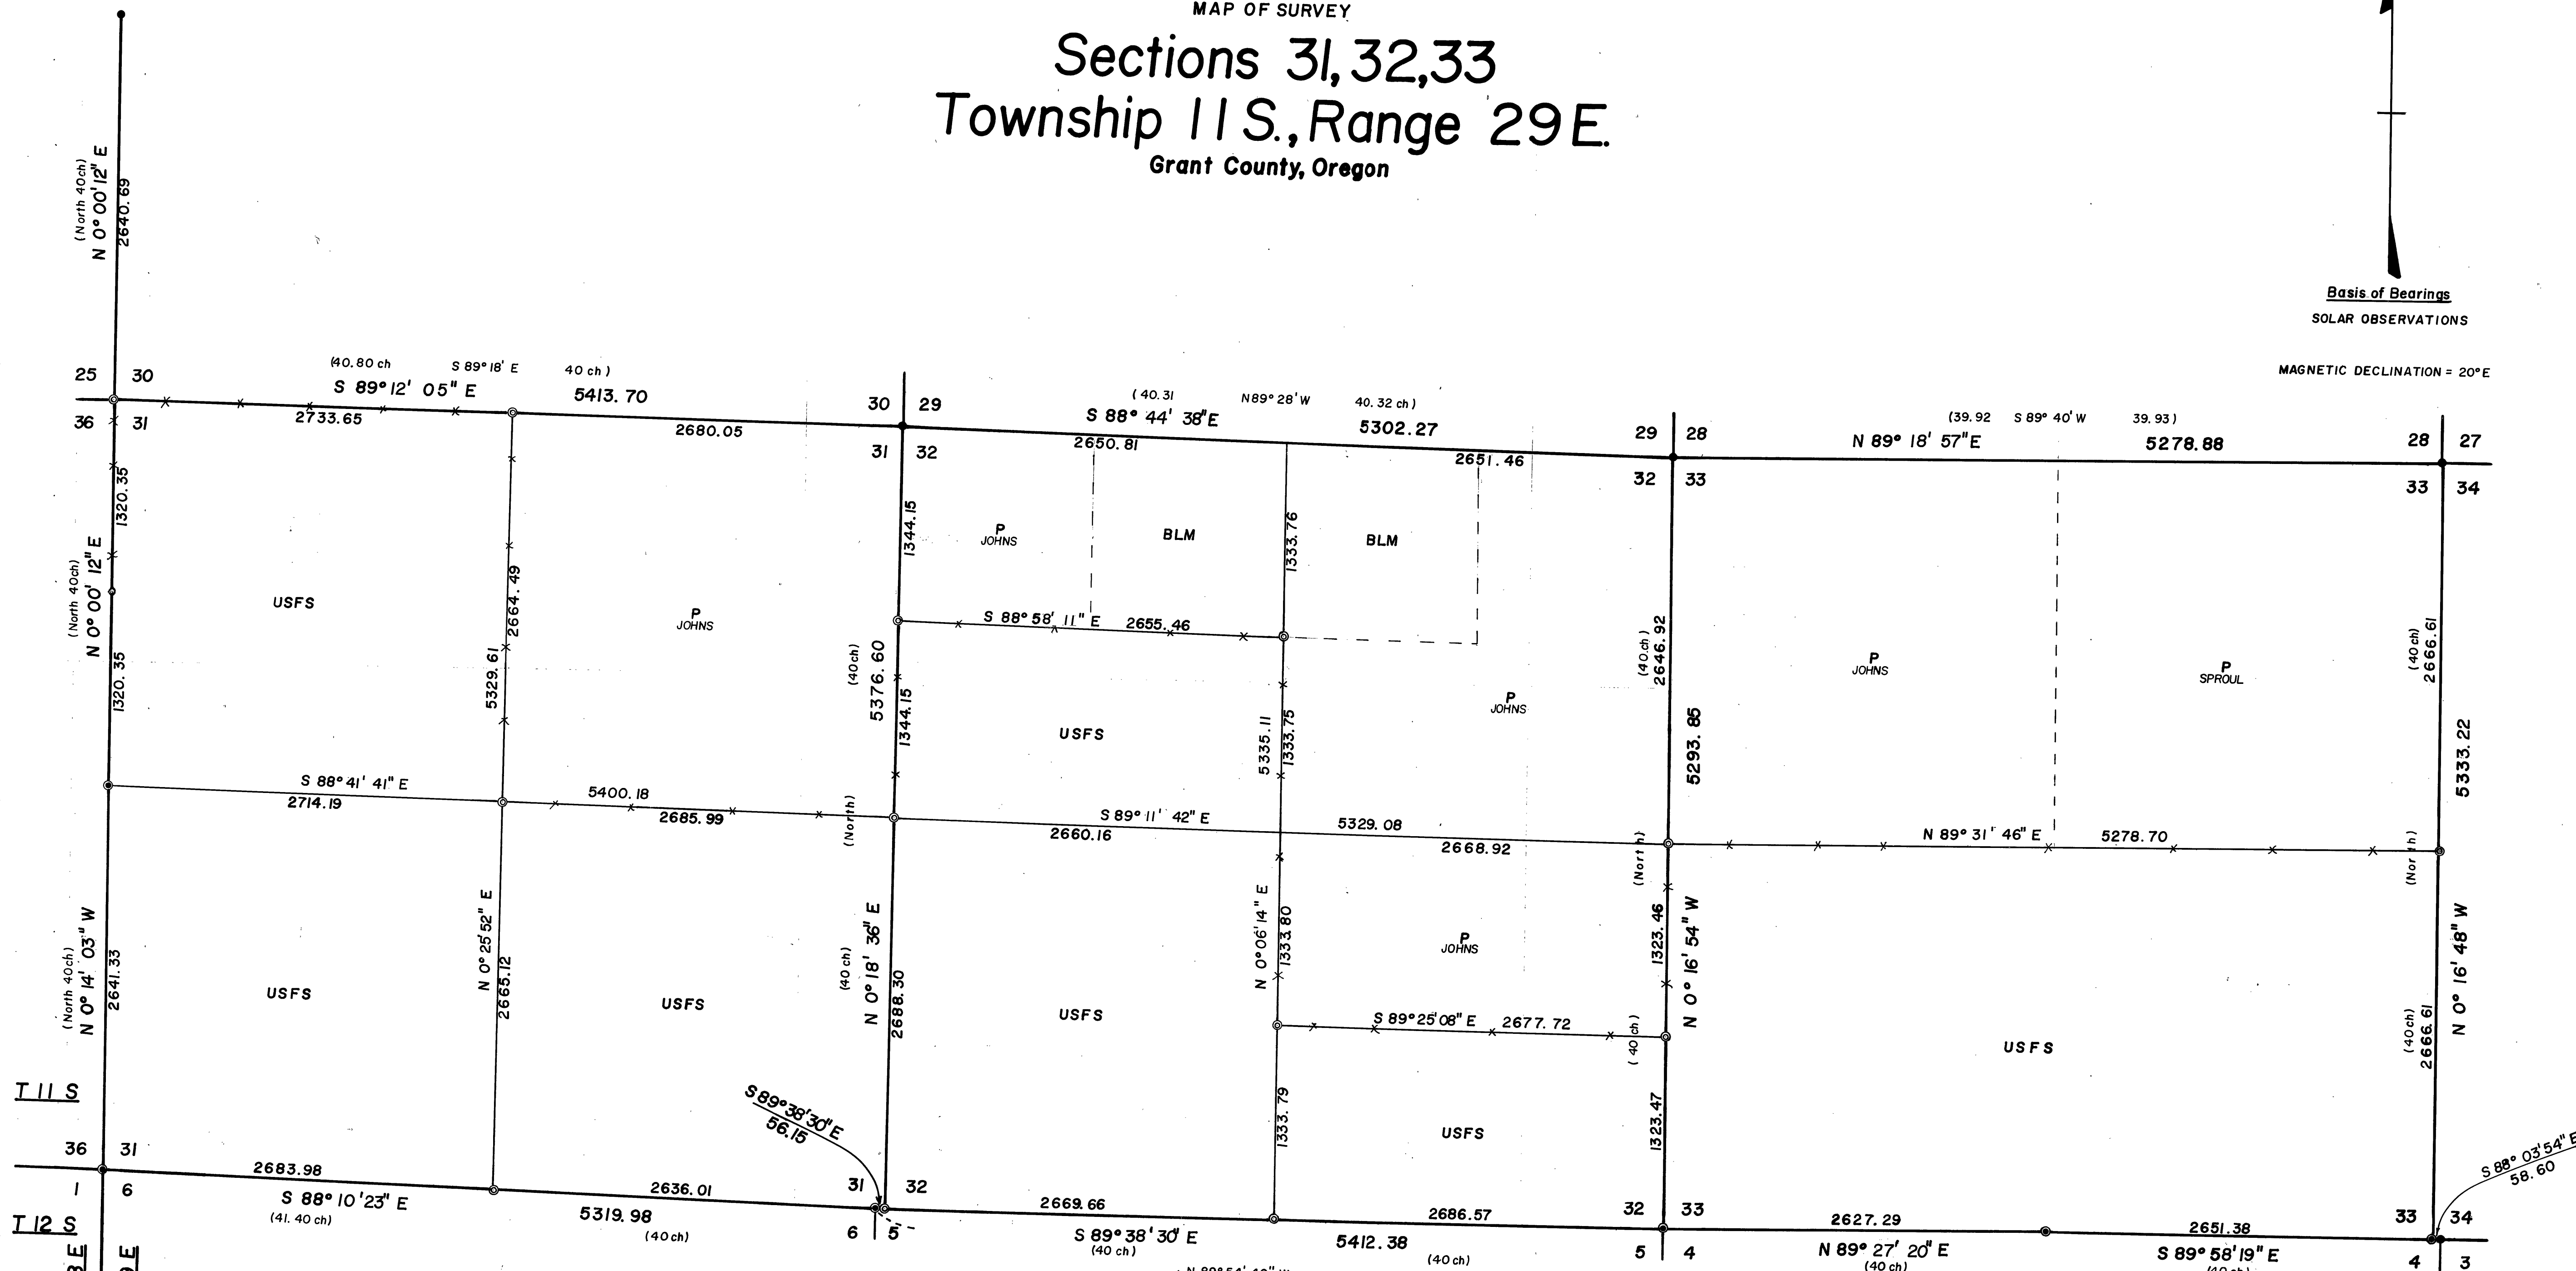

CERTIFICATION

I, Duane I. Griffith, do hereby certify that, during the summer of 1969, the area herein shown was surveyed under my direct supervision in accordance with procedures set forth in the BLM Manual and the OREGON STATE LAWS governing public land surveys and under instructions of the MALHEUR NATIONAL FOREST and that this plat is, to the best of my knowledge, is a true representation thereof. Brass caps set, are stamped with GRANT COUNTY SURVEYOR, date, L.S. 644, and with proper nomenclature as prescribed in the BLM Manual.

Duane I. Griffith
GRANT COUNTY SURVEYOR

HISTORY OF SURVEYS

Original survey in 1873 by William H. Byars
South boundary retraced in 1884 by William R. Gradon
West boundary retraced in 1880 by Aaron F. York



LEGEND

- Found original corner, replaced with, brass cap on a 2" x 30" iron pipe
- Found original corner, replaced with, brass cap on a 1" x 30" iron pipe
- Set, brass cap on a 2" x 30" iron pipe
- Set, brass cap on a 1" x 30" iron pipe
- () Record bearing and distances
- Steel fence posts, set on line
- USFS National Forest Land
- BLM Bureau of Land Management Land
- P Private owned Land

RECEIVED AND
FILED
JUL 15 1969
GRANT COUNTY CLERK

BAGETT & GRIFFITH SURVEYING John Day, Oregon		
SURVEYED FOR MALHEUR NAT'L FOREST		
SURVEYED BY	D.I. GRIFFITH	SUMMER, 1969
Scale: 1" = 600'	Drawn by D.I.G.	7/ 1969

Survey # 146