
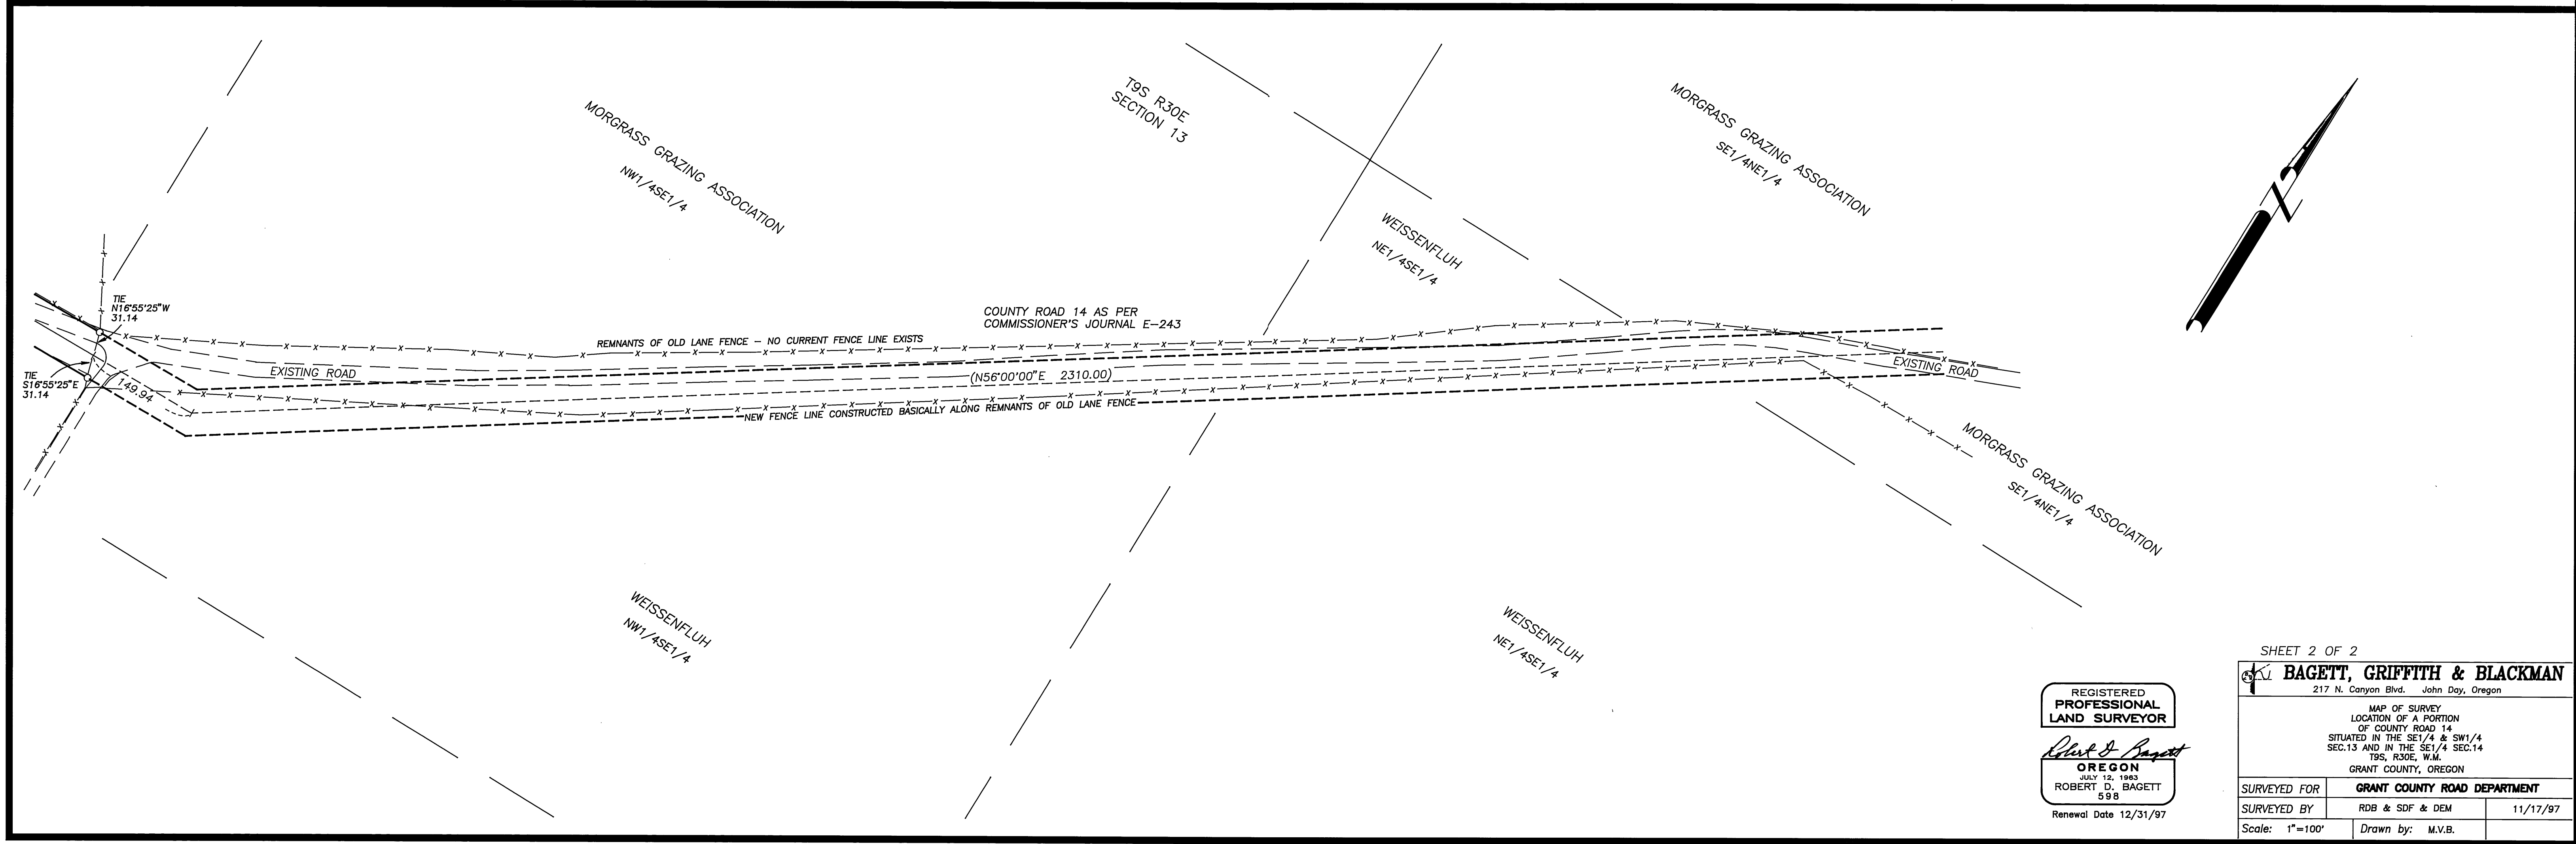


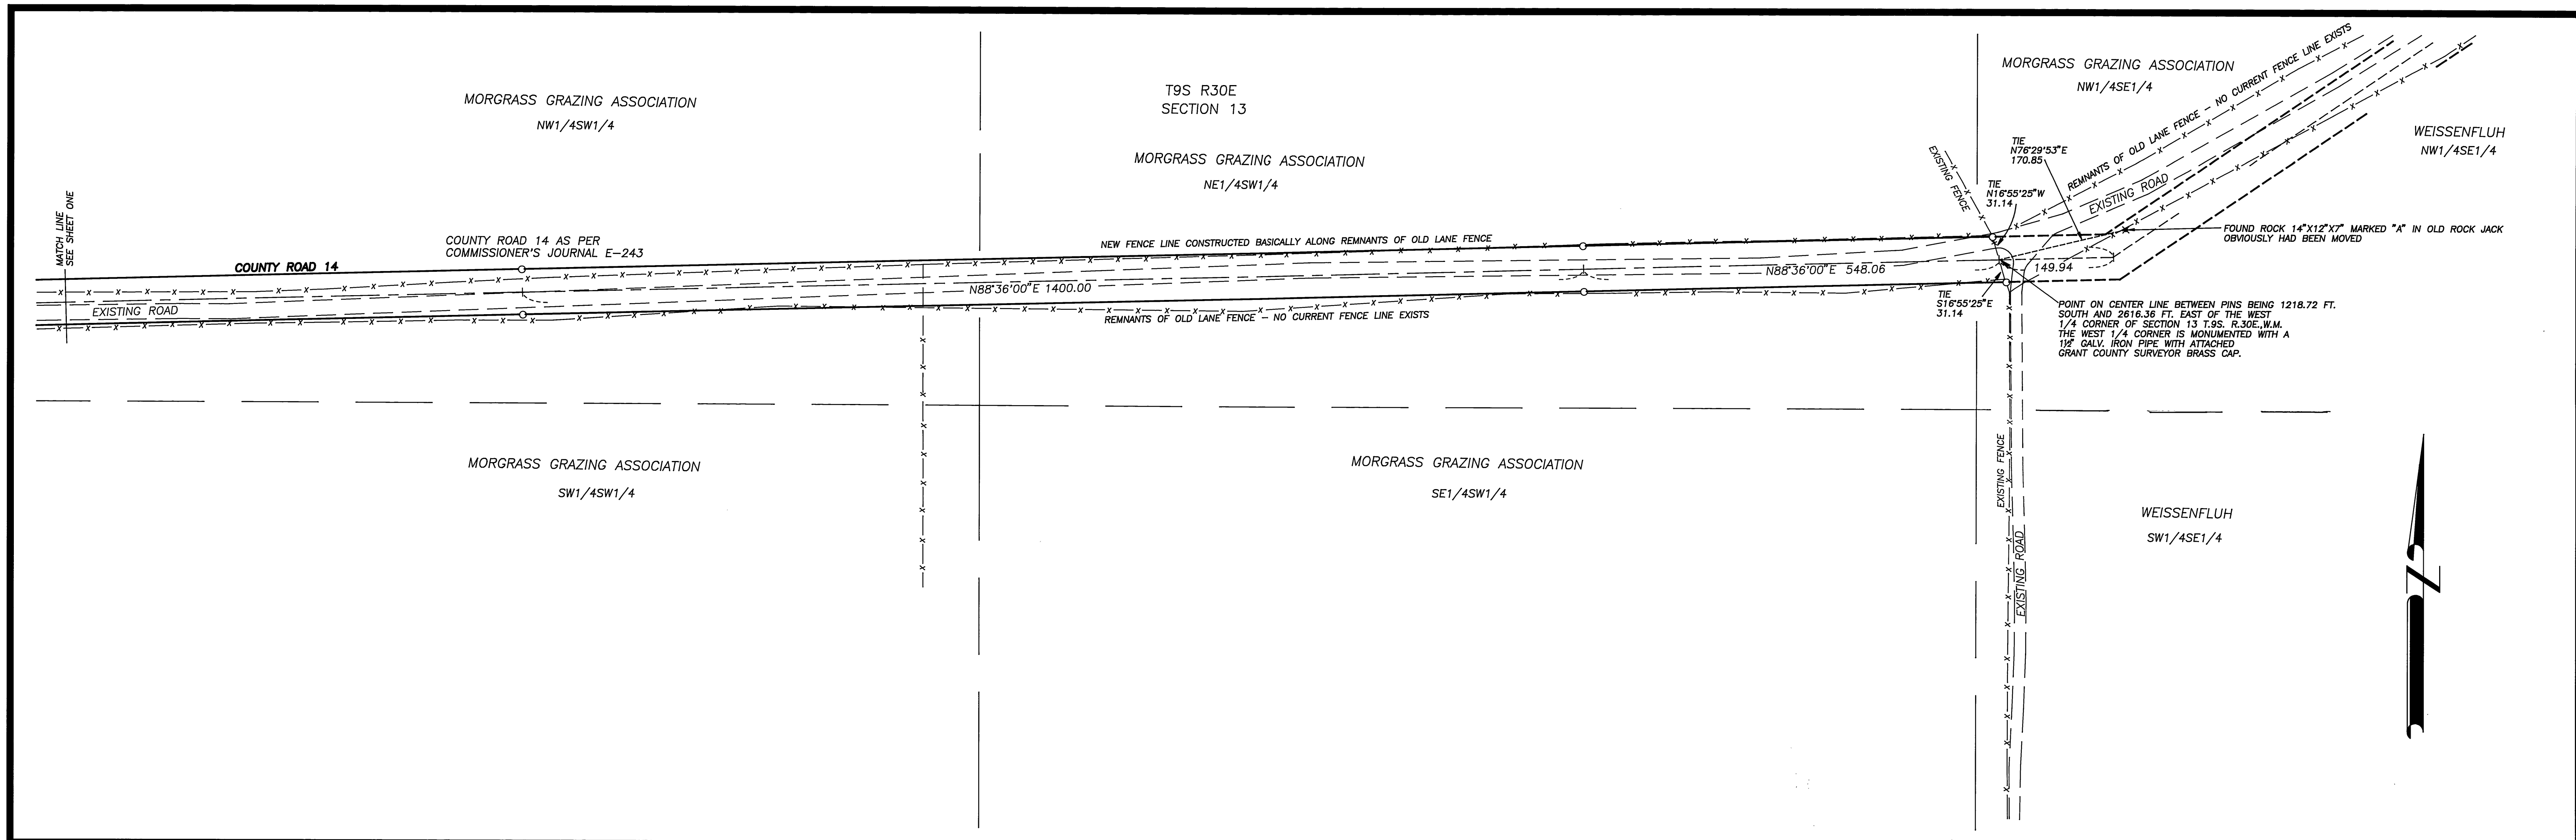

REGISTERED
PROFESSIONAL
LAND SURVEYOR
Robert D. Baggett
OREGON
JULY 12, 1983
ROBERT D. BAGGETT
598
Renewal Date 12/31/97

SHEET 2 OF 2

BAGETT, GRIFFITH & BLACKMAN 217 N. Canyon Blvd. John Day, Oregon		
MAP OF SURVEY LOCATION OF A PORTION OF COUNTY ROAD 14 SITUATED IN THE SE1/4 & SW1/4 SEC.13 AND IN THE SE1/4 SEC.14 T9S, R30E, W.M. GRANT COUNTY, OREGON		
SURVEYED FOR	GRANT COUNTY ROAD DEPARTMENT	
SURVEYED BY	RDB & SDF & DEM	11/17/97
Scale: 1"=100'	Drawn by: M.V.B.	