




Ferguson Surveying
Engineering

MT. VERNON, OREGON
PHONE (503) 832-4520
FAX (503) 832-4430

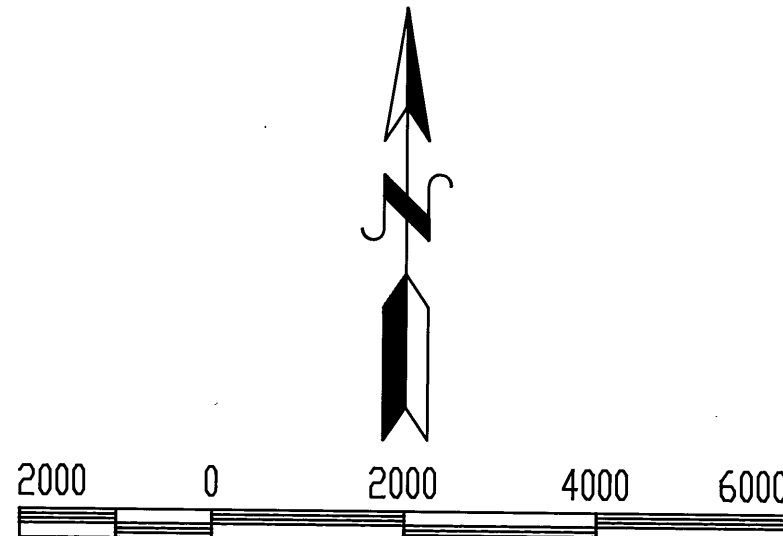

ALL COORDINATES AND
COURSES ARE APPROXIMATE

Contours as shown were created from U.S.G.S. Digital Elevation Models (DEM). These DEM points were supplied on a 30m grid, UTM coordinates. They were converted to NAD27, Oregon North Zone State Plane Coordinates using Wildsoft's Coordinate Conversion Program. The road and creeks shown were digitized from USGS 7-1/2 minute Quadrangle Maps.

LEGEND

- ⊗ Found B.L.M. Brass Capped Monument.
- U.S.F.S. Found original evidence. Monumented by this firm.
- ⊙ Corner Searched, Original Evidence Found
- ⊗ Corner Searched, Original Evidence Found Monumented by this firm.
- Corner Searched, No Evidence Found
- △ Corner evidence found, see SHEET 1

REGISTERED
PROFESSIONAL
LAND SURVEYOR

OREGON
JULY 12, 1988
DOUGLAS M. FERGUSON
848
RENEWAL DATE:
12/31/98

