




A PORTION OF GRANT COUNTY ROAD #24 RIGHT OF WAY SURVEY

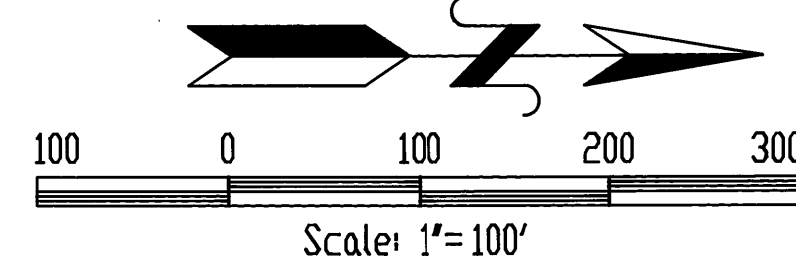

BASIS OF BEARING: SOLAR OBSERVATIONS
MAGNETIC DECLINATION 18-1/2° EAST

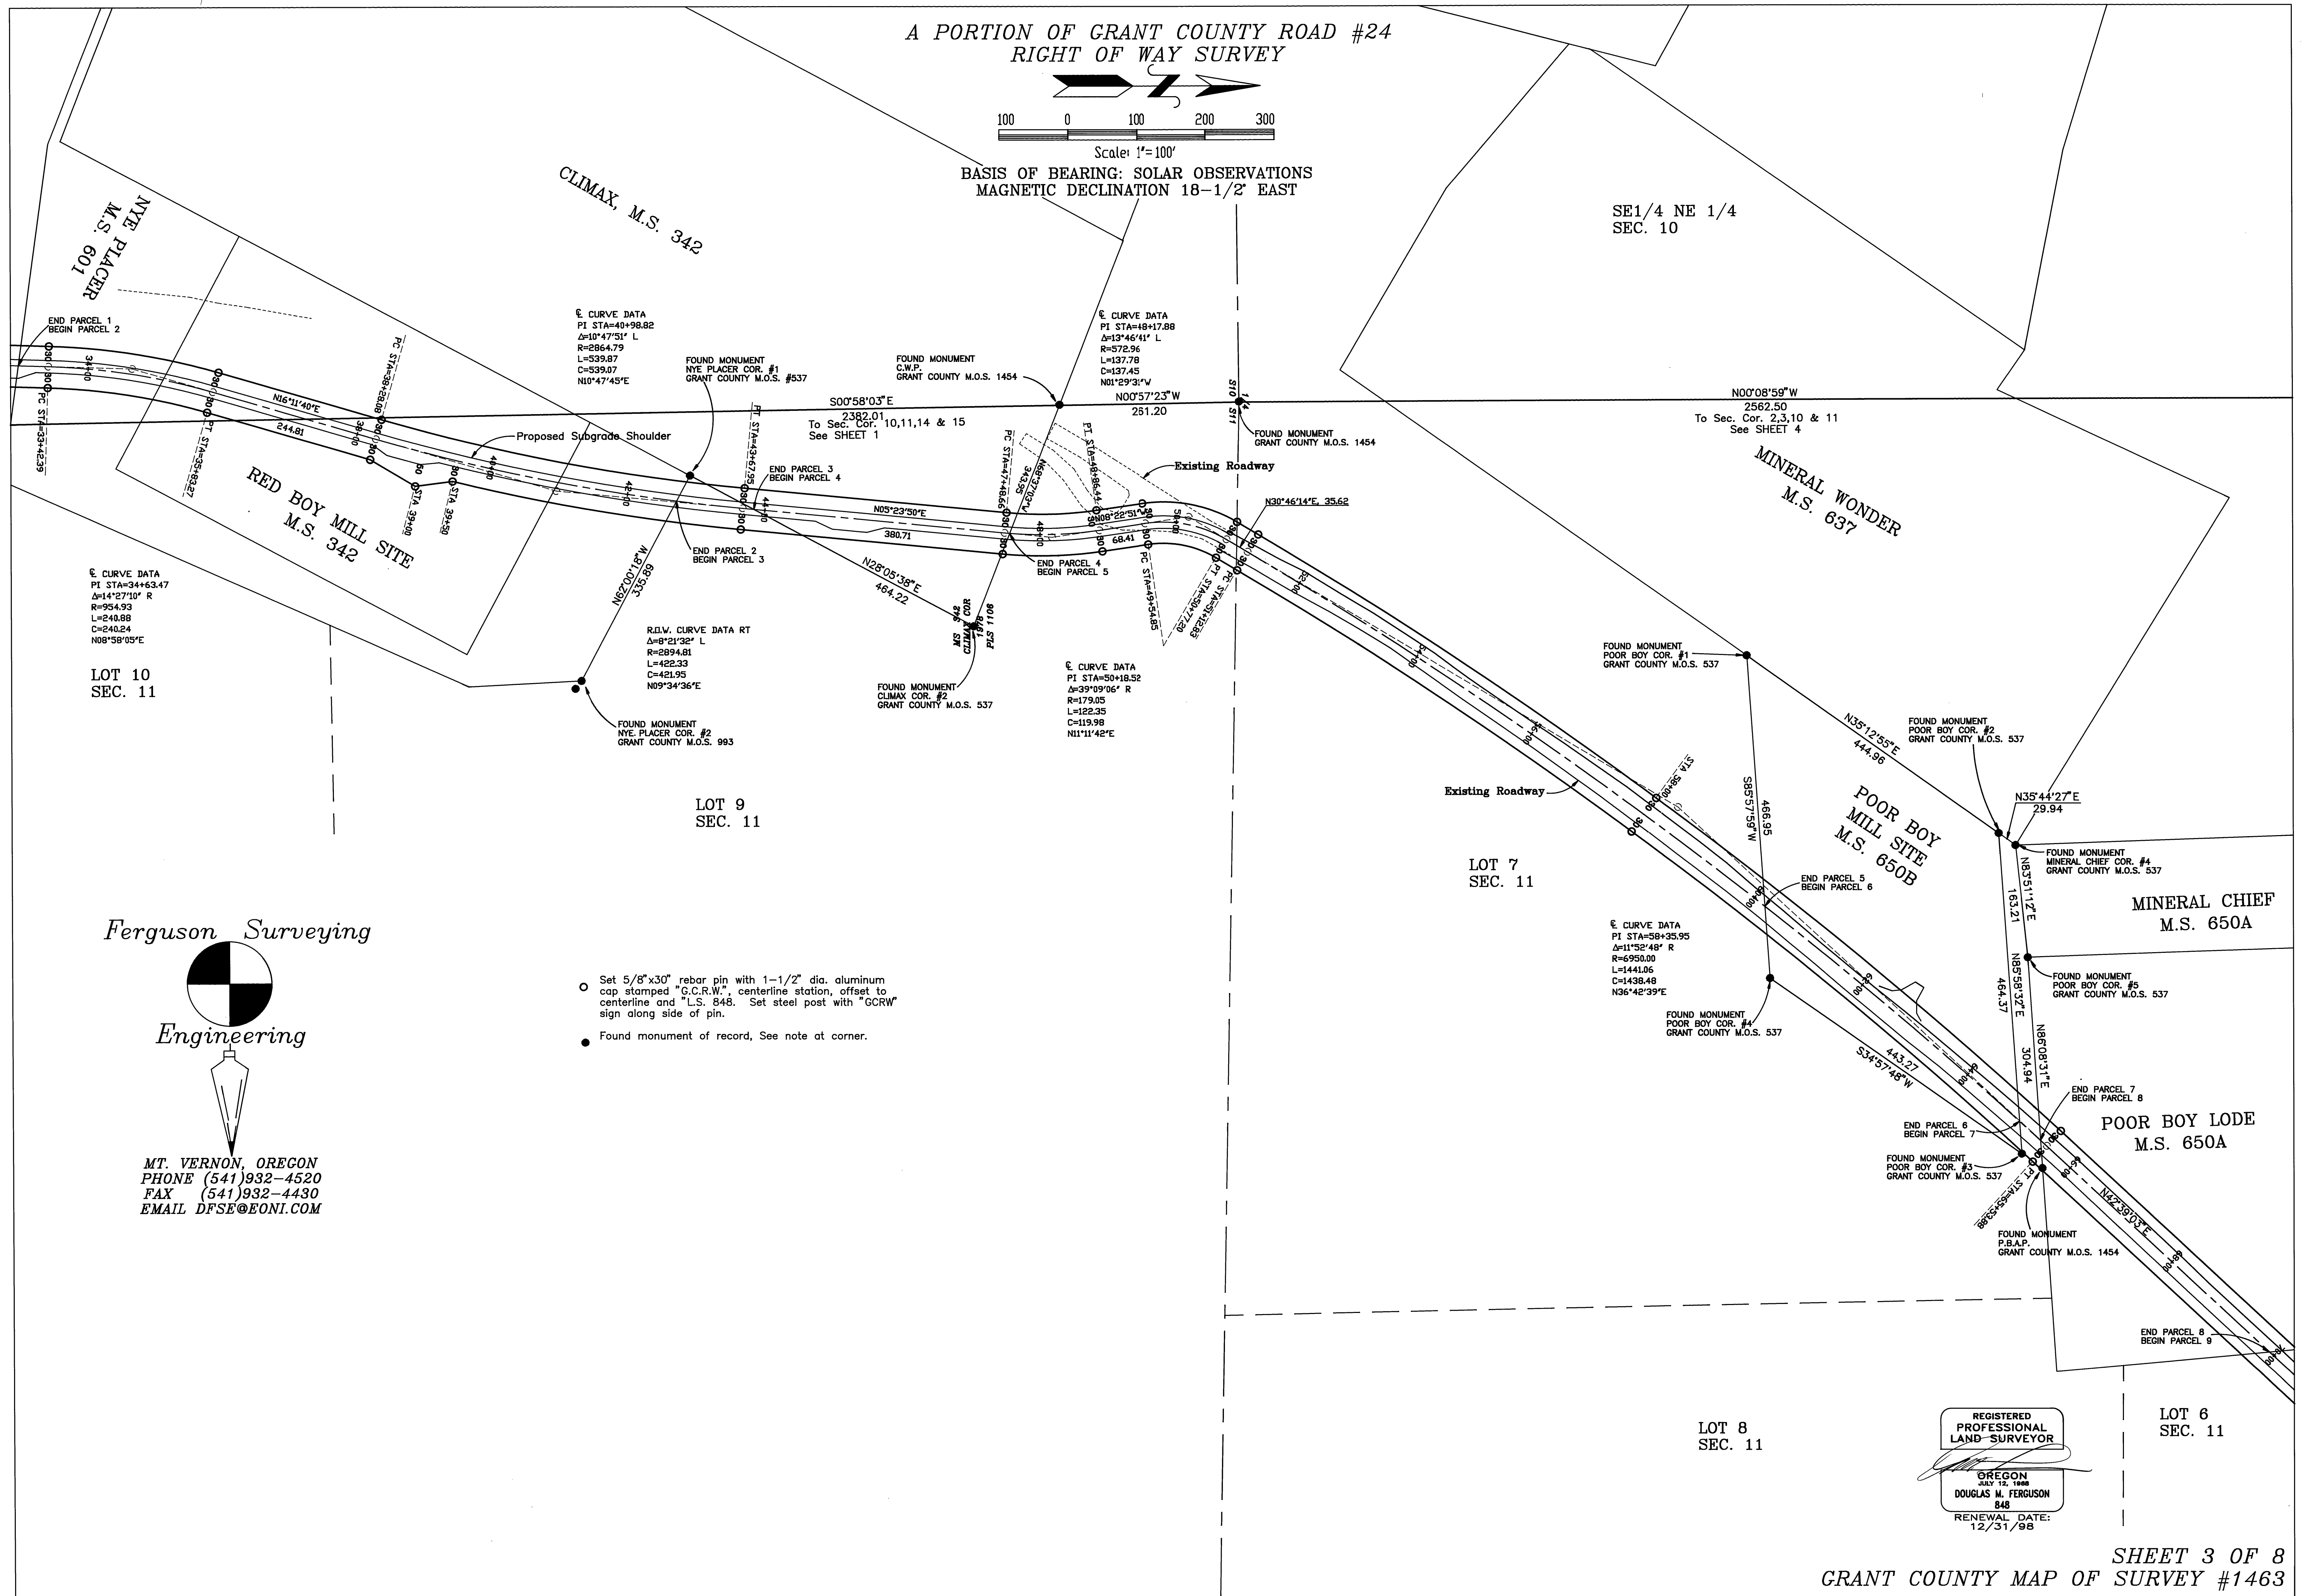

Ferguson Surveying

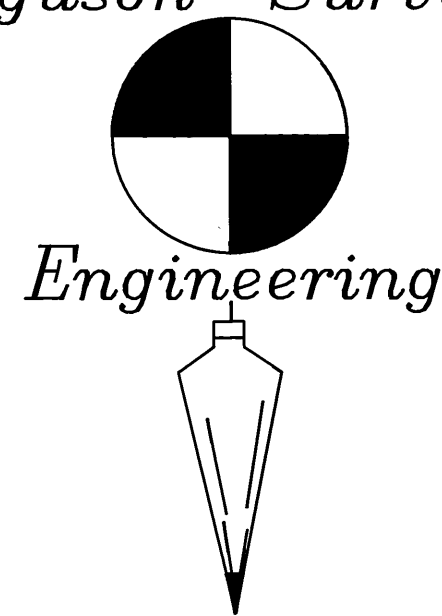

MT. VERNON, OREGON
PHONE (541)932-4520
FAX (541)932-4430
EMAIL DFSE@EONI.COM

- Set 5/8"x30" rebar pin with 1-1/2" dia. aluminum cap stamped "G.C.R.W.", centerline station, offset to centerline and "L.S. 848". Set steel post with "GCRW" sign along side of pin.
- Found monument of record, See note at corner.

REGISTERED
PROFESSIONAL
LAND SURVEYOR
OREGON
JULY 12, 1988
DOUGLAS M. FERGUSON
848
RENEWAL DATE:
12/31/98