



A PORTION OF GRANT COUNTY ROAD #24
RIGHT OF WAY SURVEY

Ferguson Surveying

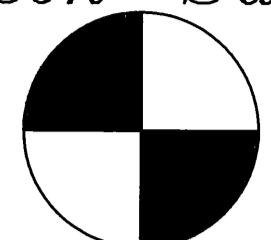

Engineering

MT. VERNON, OREGON
PHONE (541)932-4520
FAX (541)932-4430
EMAIL DFSE@EONI.COM

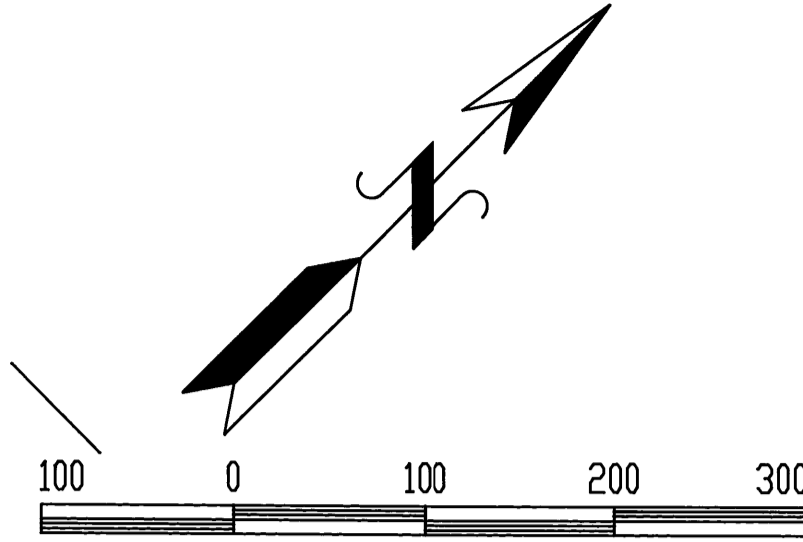

Scale: 1"=100'
BASIS OF BEARING: SOLAR OBSERVATIONS
MAGNETIC DECLINATION 18-1/2° EAST

NW 1/4 SE 1/4
SEC. 2

- Set 5/8" x 30" rebar pin with 1-1/2" dia. aluminum cap stamped "G.C.R.W.", centerline station, offset to centerline and "L.S. B48". Set steel post with "GCRW" sign along side of pin.
- Found monument of record, See note at corner.

☺ CURVE DATA
PI STA=122+22.95
Δ=22°52'49" L
R=1150.00
L=459.24
C=456.19
N30°48'44"E

SE 1/4 NE 1/4
SEC. 2

Approximate location of prior R.O.W.
Deed Book 97, Page 297
to be superceded by this survey.

☺ CURVE DATA
PI STA=127+67.77
Δ=42°08'24" R
R=425.00
L=312.58
C=305.58
N40°26'32"E

☺ CURVE DATA
PI STA=107+03.92
Δ=23°51'04" R
R=1060.00
L=441.26
C=438.08
N30°19'37"E

NO22041E
2874.75
To Sec. Cor. 1 & 2
See SHEET 6 & 2

FOUND MONUMENT
GRANT COUNTY M.O.S. 575

REGISTERED
PROFESSIONAL
LAND SURVEYOR

OREGON
JULY 12, 1988
DOUGLAS M. FERGUSON
848
RENEWAL DATE:
12/31/98