



U.S.A.  
SW1/4SE1/4

RUDIO MTN. LIMITED  
PARTNERSHIP  
SE1/4SE1/4

CENTERLINE STATION 494+73.20 BEING  
756.51 FT. NORTH AND 1157.23 FT. WEST  
OF THE SOUTHEAST CORNER OF SECTION 7,  
T.11S., R.27E., W.M. THE SOUTHEAST CORNER  
IS MONUMENTED WITH A BLM BRASS CAP.


② CURVE DATA  
Δ=58°55'22"  
R=200.00  
L=205.68  
LC=196.73  
N76°50'26"E

②49  
E1/16 CORNER

(S88°47'W 1318.02) S88°43'41"W 1317.48

T.11S., R.27E.

SECTION 7 SECTION 8  
SECTION 18 SECTION 17

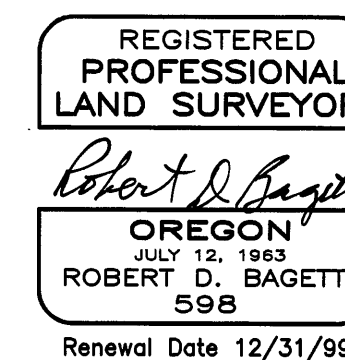

PAGE 11 OF 11		
BAGETT, GRIFFITH & BLACKMAN 217 N. Canyon Blvd. John Day, Oregon		
MAP OF SURVEY RIGHT OF WAY FOR DICK CREEK ROAD SITUATED IN SECTIONS 20, 21, 24, 25, 26, 27, & 28, T.11S., R.26E. AND IN SECTIONS 7, 18 & 19, T.11S., R.27E., W.M.		
GRANT COUNTY, OREGON		
SURVEYED FOR	GRANT COUNTY ROAD DEPARTMENT	
SURVEYED BY	RDB & SDF & DEM	9/17/97 THRU 1/21/98
Scale: 1"=100'	Drawn by: MCS-MJD-MVB	

RECORD MAP OF SURVEY NO. 1465