


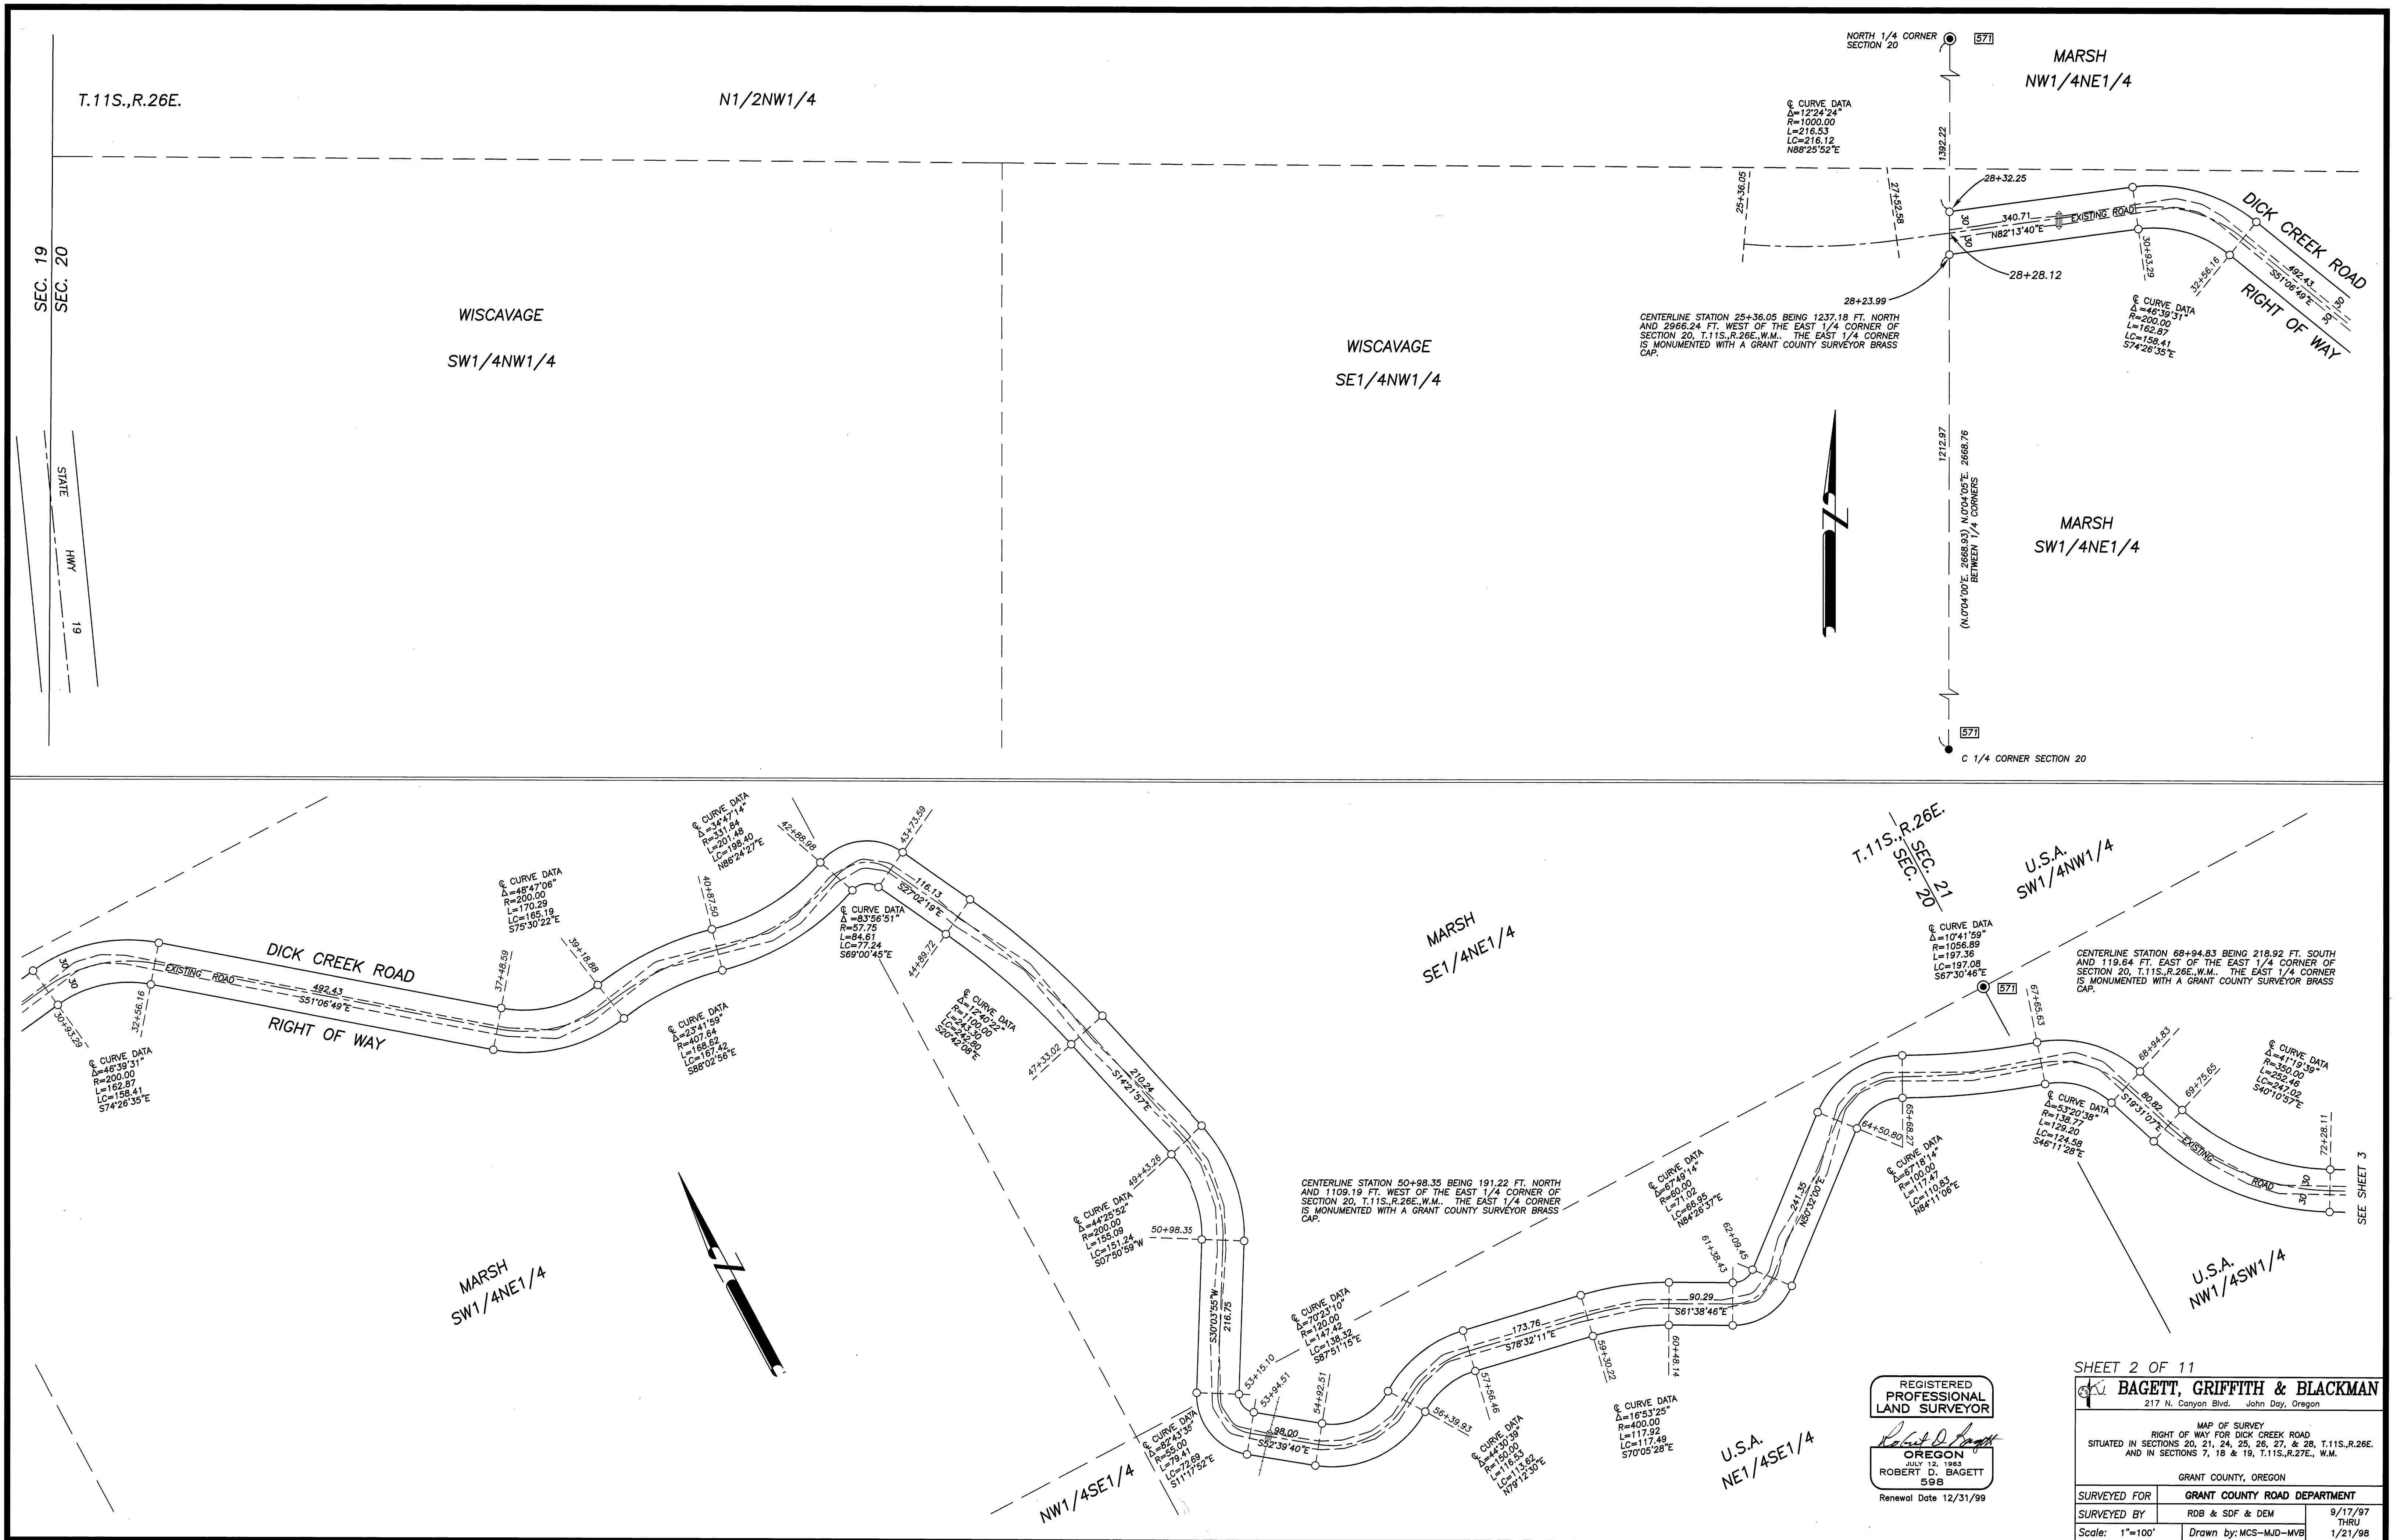

SHEET 2 OF 11

BAGETT, GRIFFITH & BLACKMAN
217 N. Canyon Blvd. John Day, Oregon

REGISTERED PROFESSIONAL LAND SURVEYOR

OREGON
JULY 12, 1963
ROBERT D. BAGETT
599
Renewal Date 12/31/99

MAP OF SURVEY
RIGHT OF WAY FOR DICK CREEK ROAD
SITUATED IN SECTIONS 20, 21, 24, 25, 26, 27, & 28, T.11S., R.26E.
AND IN SECTIONS 7, 18 & 19, T.11S., R.27E., W.M.

GRANT COUNTY, OREGON

SURVEYED FOR	GRANT COUNTY ROAD DEPARTMENT
SURVEYED BY	RDB & SDF & DEM
Scale: 1"=100'	Drawn by: MCS-MJD-MVB
	9/17/97 THRU 1/21/98