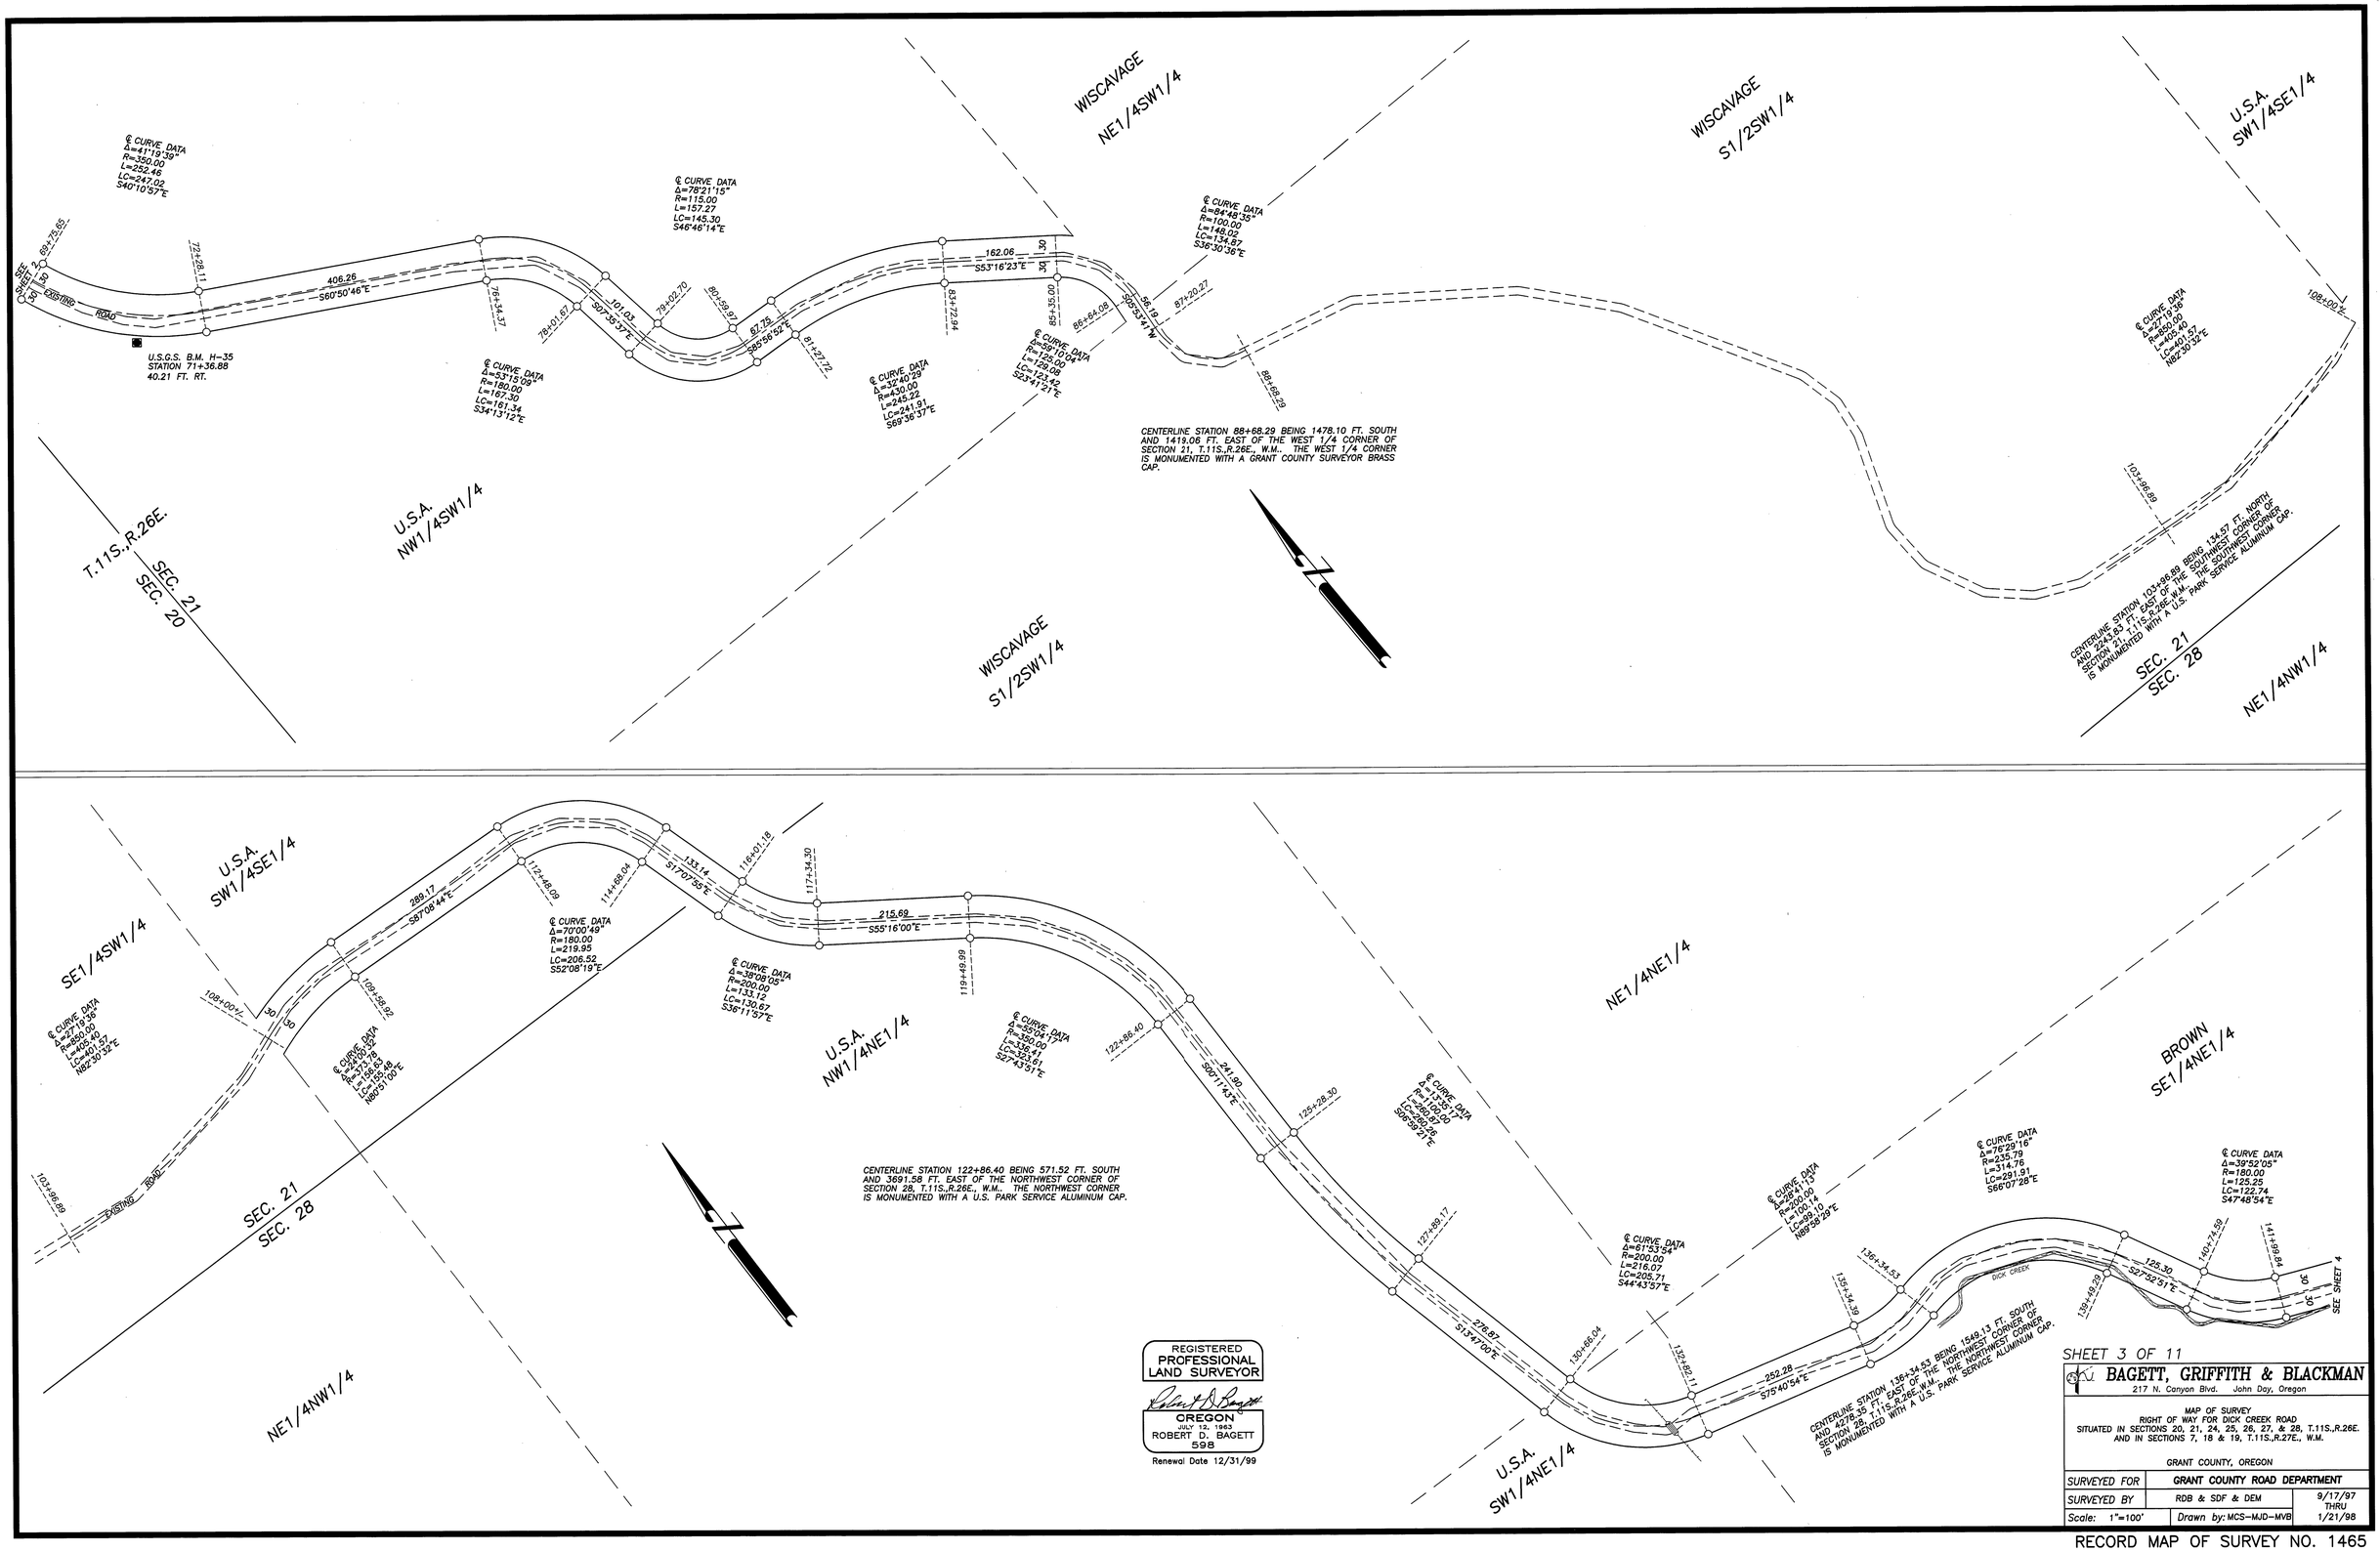

RECORD MAP OF SURVEY NO. 1465