


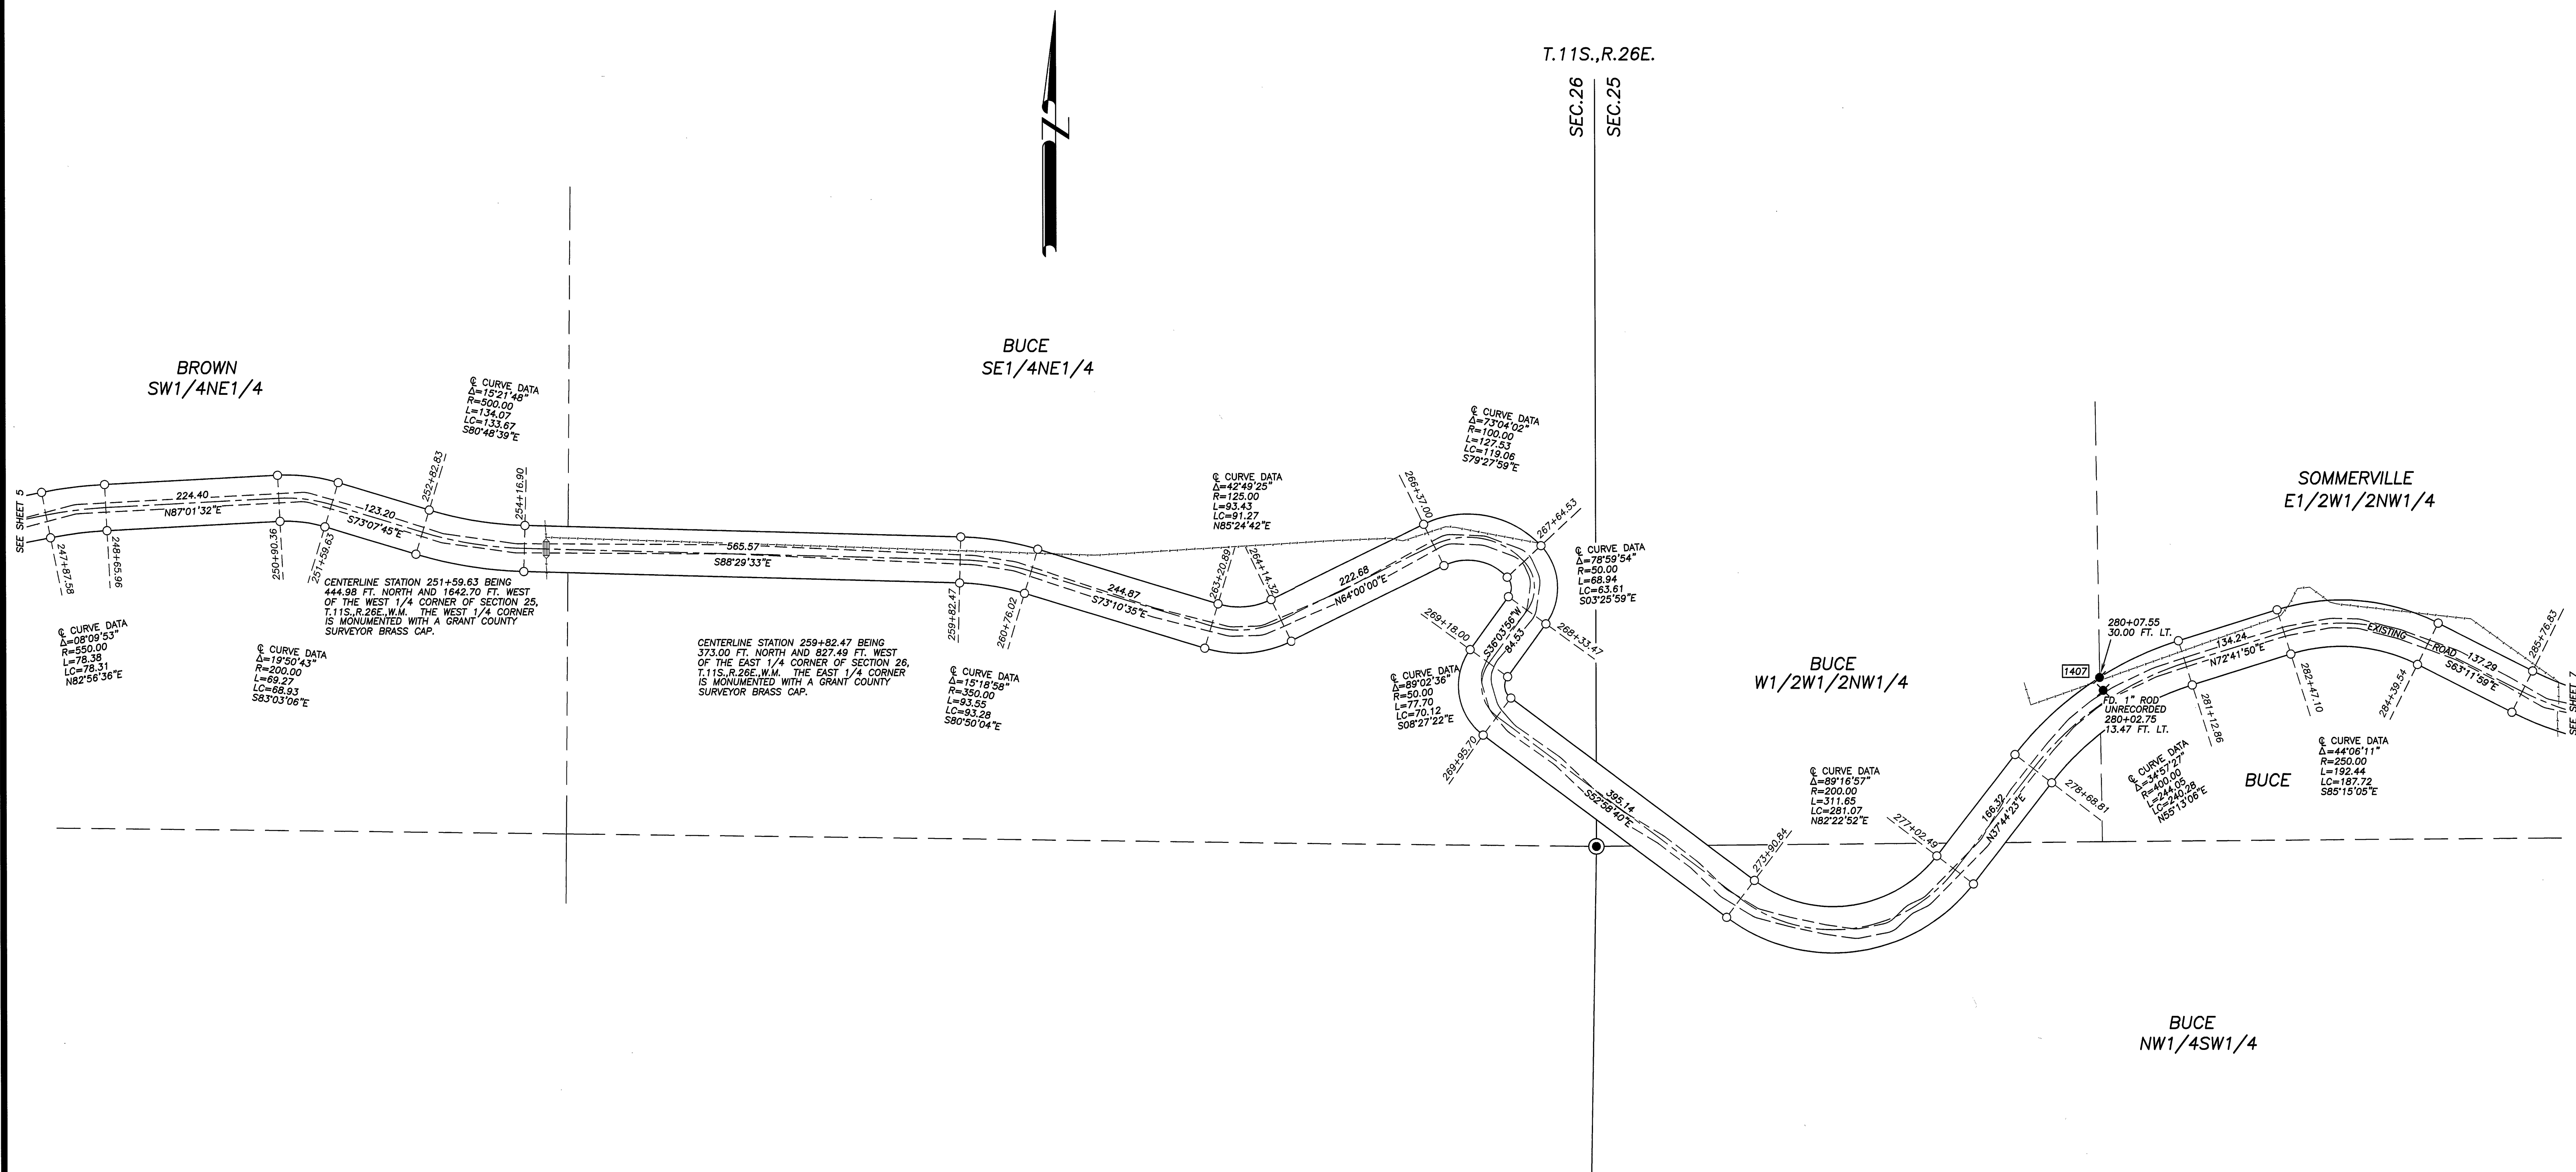

REGISTERED
PROFESSIONAL
LAND SURVEYOR

Robert D. Baggett

OREGON
JULY 12, 1983
ROBERT D. BAGGETT
598
Renewal Date 12/31/99

SHEET 6 OF 11		
BAGGETT, GRIFFITH & BLACKMAN 217 N. Canyon Blvd. John Day, Oregon		
MAP OF SURVEY RIGHT OF WAY FOR DICK CREEK ROAD SITUATED IN SECTIONS 20, 21, 24, 25, 26, 27, & 28, T.11S., R.26E. AND IN SECTIONS 7, 18 & 19, T.11S., R.27E., W.M.		
GRANT COUNTY, OREGON		
SURVEYED FOR	GRANT COUNTY ROAD DEPARTMENT	
SURVEYED BY	RDB & SDF & DEM	9/17/97 THRU 1/21/98
Scale: 1"=100'	Drawn by: MCS-MJD-MVB	