


PICTURE GORGE - DAYVILLE
O.D.O.T. RIGHT OF WAY
MONUMENTATION

Ferguson Surveying
Engineering

MT. VERNON, OREGON
PHONE (541) 932-4520
FAX (541) 932-4430
EMAIL DFSE@FONI.COM

REGISTERED
PROFESSIONAL
LAND SURVEYOR

OREGON
JULY 12, 1988
DOUGLAS M. FERGUSON
848
RENEWAL DATE:
12/31/99

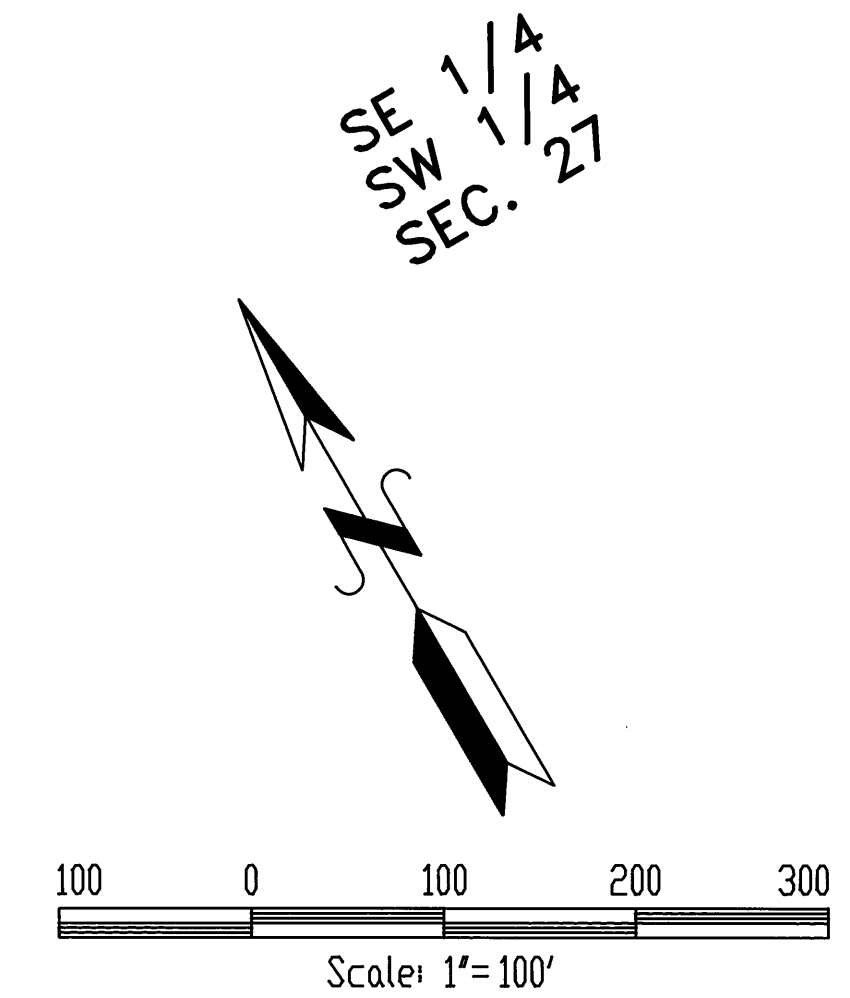

SW 1/4
SW 1/4
SEC. 27

A.E. & M.J. Brown
M.A. Brown (C.P.)
139-471-89

A.E. & M.J. Brown
M.A. Brown (C.P.)
139-471-89

M.A. Brown
139-469-89

J.L. Hall
136-490-88
S. Bor S Ranches, Inc. (C.P.)
136-557-88

NE 1/4
NW 1/4
SEC. 34

- RIGHT OF WAY
- - - PREVIOUS CENTERLINE
- PREVIOUS TANGENT LINES
- - - DESIGN CENTERLINE
- - - DESIGN TANGENT LINES
- (Station or Bearing) PREVIOUS CENTERLINE STATION-BEARING
- (Offset) PERPENDICULAR OFFSET TO PREVIOUS CENTERLINE
- x-x-x-x-x EXISTING FENCES PRIOR TO CONSTRUCTION
- SET 5/8"x30" IRON PIN WITH YELLOW PLASTIC CAP STAMPED "PLS 848", WITH POST AND PADDLE MARKED WITH DESIGN CENTERLINE STATION AND OFFSET.
- APPROX SECTION LINE
- - - APPROX CENTER SECTION LINE
- - - APPROX. SECTION SUBDIVISION LINE

DESIGN CURVE DATA
PI STA=106+23.64
I=29°19'59" L

CIRCULAR	SPIRALS
Ic=3°19'59"	Is=13°00'00"
Da=6°30'00"	L=400.00
Dc=6°30'13"	X=397.95
T=25.65	Y=30.14
R=881.47	P=7.55
L=51.28	K=199.66
C=51.27	LT=267.39
E=0.37	ST=133.99
M=0.37	T=432.33

PREVIOUS N.B. DAT
PI STA=17+48.97
I=29°28'08" L

CIRCULAR	SPIRALS
Ic=0°00'00"	Is=14°44'08"
Da=7°40'29"	L=384.00
Dc=7°40'50"	X=381.47
T=0.00	Y=32.76
R=745.55	P=8.21
L=0.01	K=191.58
C=0.01	LT=256.89
E=0.00	ST=128.81
M=0.00	T=390.09

CURVE DATA, DRG. NO. 48-25-11
TS, STA. 13+66.8
DOUBLE SPIRALS
TWO 384' SPIRALS, α=2, Da=14°45'
TOTAL Da=29°30'
ST. STA. 21+34.8

D. L. Horgan
125-15-81

28 27
33 34

NW 1/4
NW 1/4
SEC. 34