
SURVEY FOR THE REMONUMENTATION OF THE NORTH 1/4 CORNER OF SECTION 1, T.13S., R.26E., W.M. GRANT COUNTY, OREGON

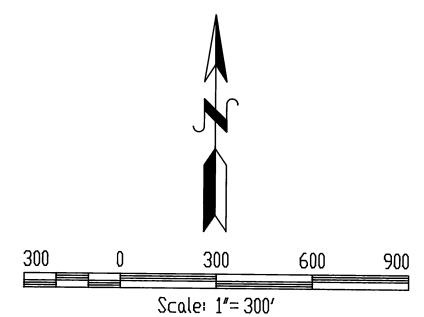

BASIS OF BEARING: Grant County Map of Survey No. 1050


LEGEND


- Found Monument, See Grant County
 Map of Survey No. 1050
- Set 2−1/2"x30" aluminum monument with 3" diameter aluminum cap.
- Record Bearing/Distance as shown on Grant County Map of Survey No. 1050


NARRATIVE

This survey was performed to remonument the North 1/4 corner of Section 1, T.13S., R.26E., W.M. in Grant County, Oregon. This survey is based on Grant County Map of Survey No. 1050. This survey was performed in February of 1998.

The monument for the above stated North 1/4 corner was found to be destroyed. In the process of replacing this corner, it was found that the reference pins as shown on Grant County Map of Survey No. 1050 were in error. In order to clarify this error, a closed loop traverse was ran between the monuments 1/2 mile east and west of this corner. This corner was then remonumented as shown on this survey. See "CERTIFIED RECORD OF LAND CORNER MONUMENTATION" as referenced to this map of survey no. 1478, filed in the office of the Grant County Surveyor.

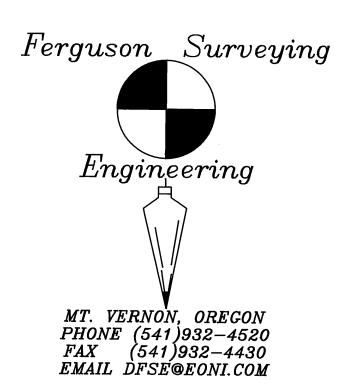

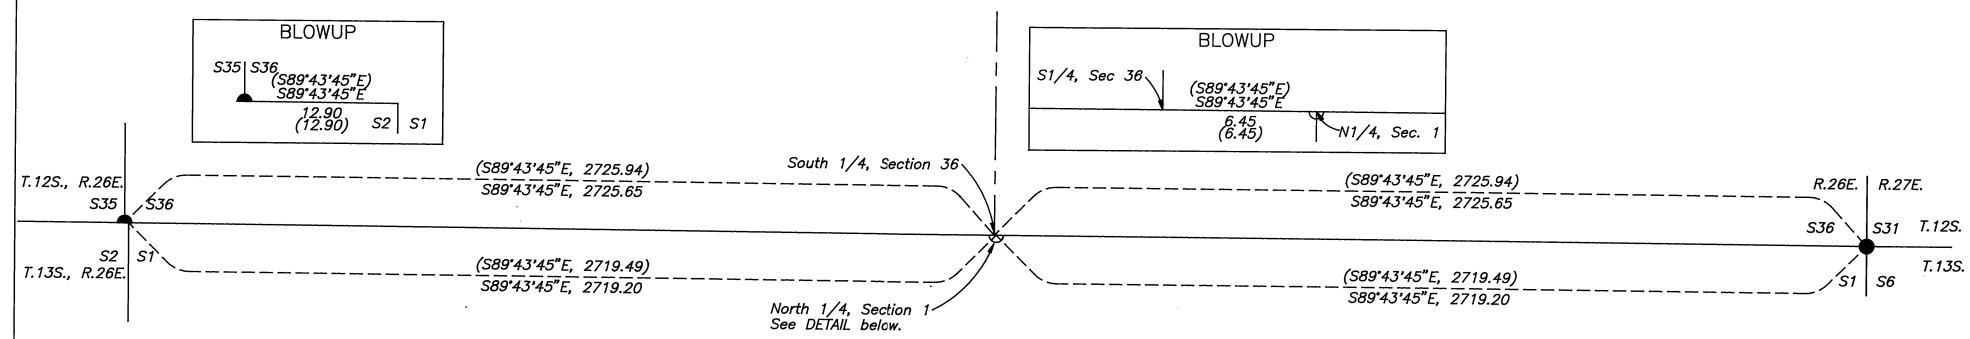

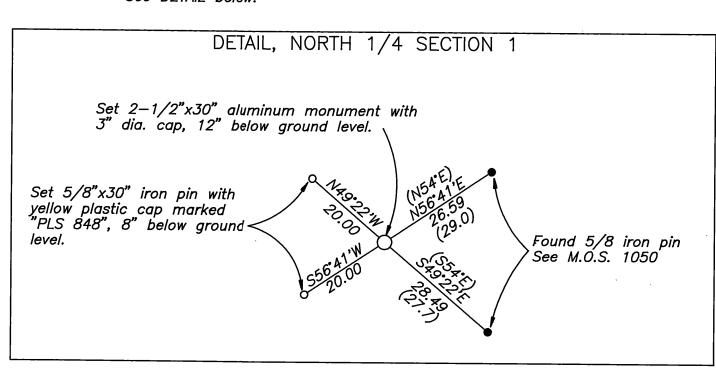

RECEIVED AND
FILED

JUN 2 3 1996

OREGON
JULY 12, 1988
DOUGLAS M. FERGUSON
848

RENEWAL DATE:
12/31/98

GRANT COUNTY MAP OF SURVEY NO. 1478