

REGISTERED  
OREGON  
LAND SURVEYOR  
*Robert D. Baggett*  
JULY 12, 1963  
ROBERT D. BAGGETT  
598


Fd section corner mkd. by  
1/2 inch iron pipe, 3 inches  
below surface of road.

Fd. 1/4 corner mkd. by a 1" iron pin  
and a basalt stone mkd. 1/4.

6 12 7  
6 1  
COUNTY ROAD  
N.0°10'00"W. 2648.89  
(Based on State Highway Dept. tie)  
T.13S., R.26E., W.M.  
T.13S., R.27E., W.M.

W. O. WEATHERFORD  
E. A. MOULTON

G. O. MANUELL

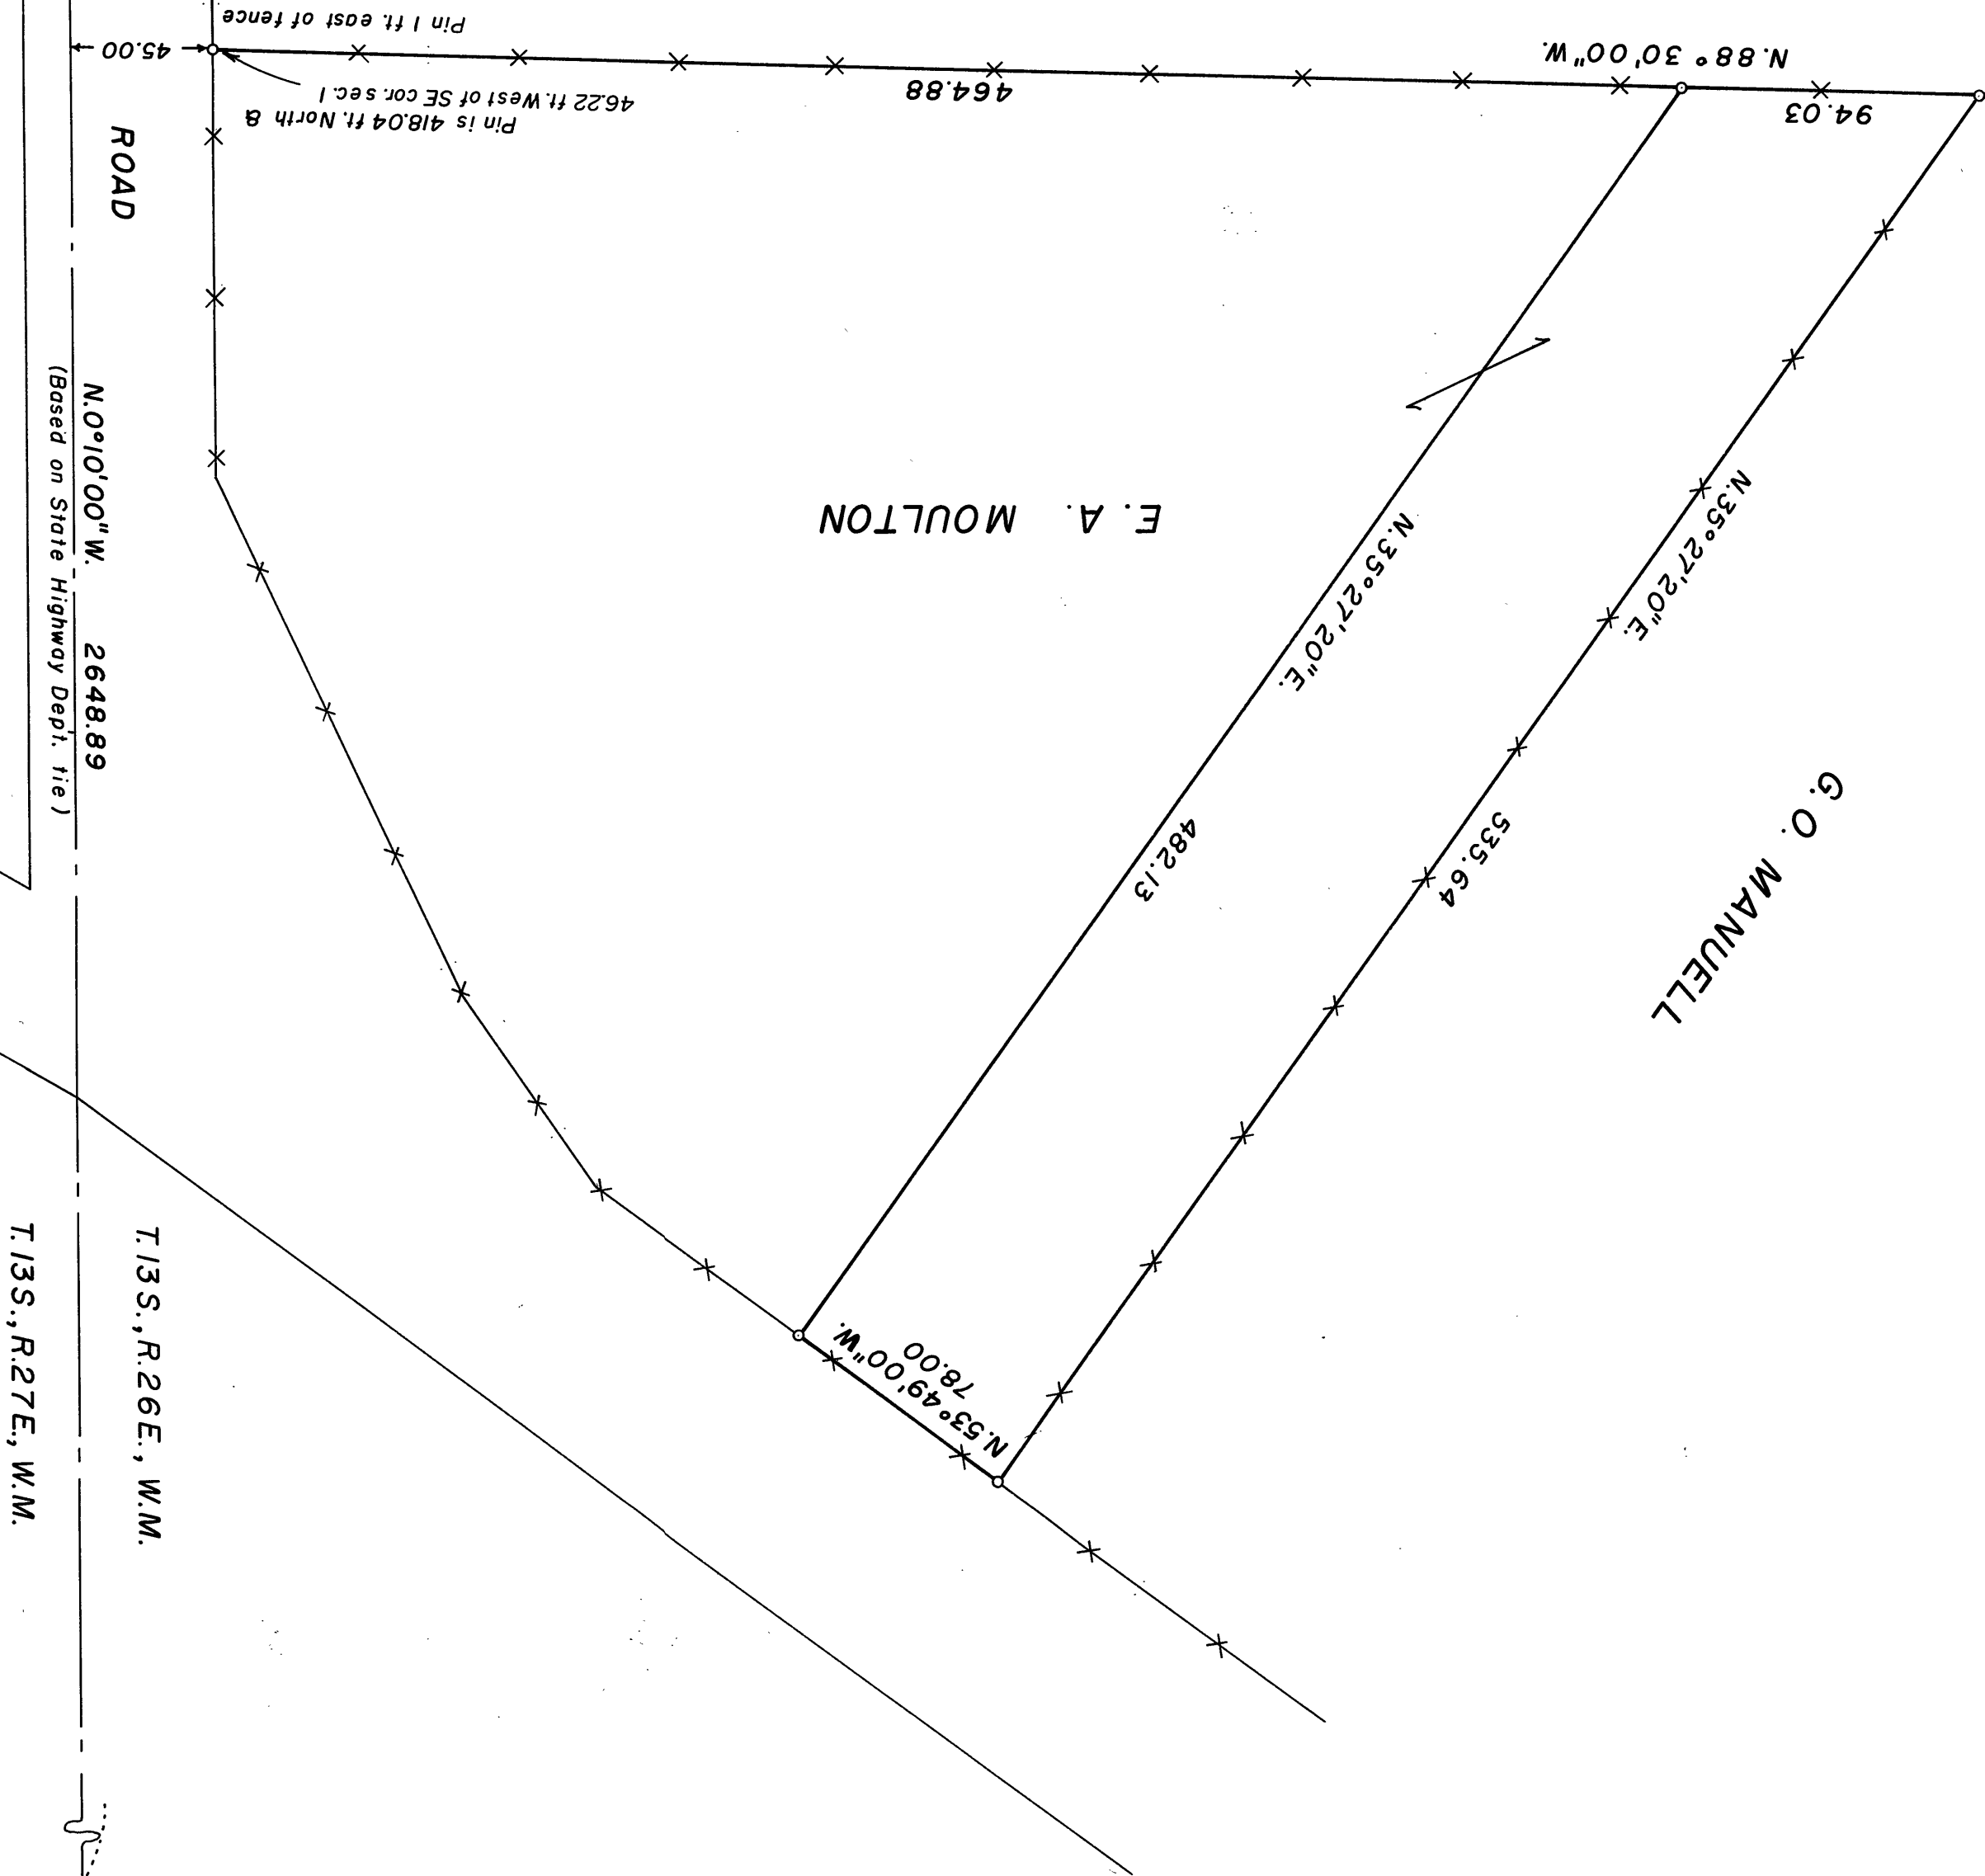

Basis of bearings  
Solar observation

LEGEND

- ◎ Found monuments
- Set 5/8" x 30" iron pin
- x — Fenceline

REFERENCES

OREGON STATE HIGHWAY DEPARTMENT  
DRAWING NO. 88-34-7

RECEIVED AND  
FILED  
SEP 22 1969  
JOHN LIVERA, County Clerk  
By \_\_\_\_\_ Deputy

BAGGETT & GRIFFITH SURVEYING  
John Day, Oregon  
Map of Survey

Parcel in City of Dayville  
Grant County, Oregon

|                 |                          |
|-----------------|--------------------------|
| SURVEYED FOR    | E. A. MOULTON            |
| SURVEYED BY     | R.D.B., D.I.G., & D.W.S. |
| Scale: 1" = 50' | Drawn by: R.D.B.         |

9/15/69

9/10/69

Survey # 148