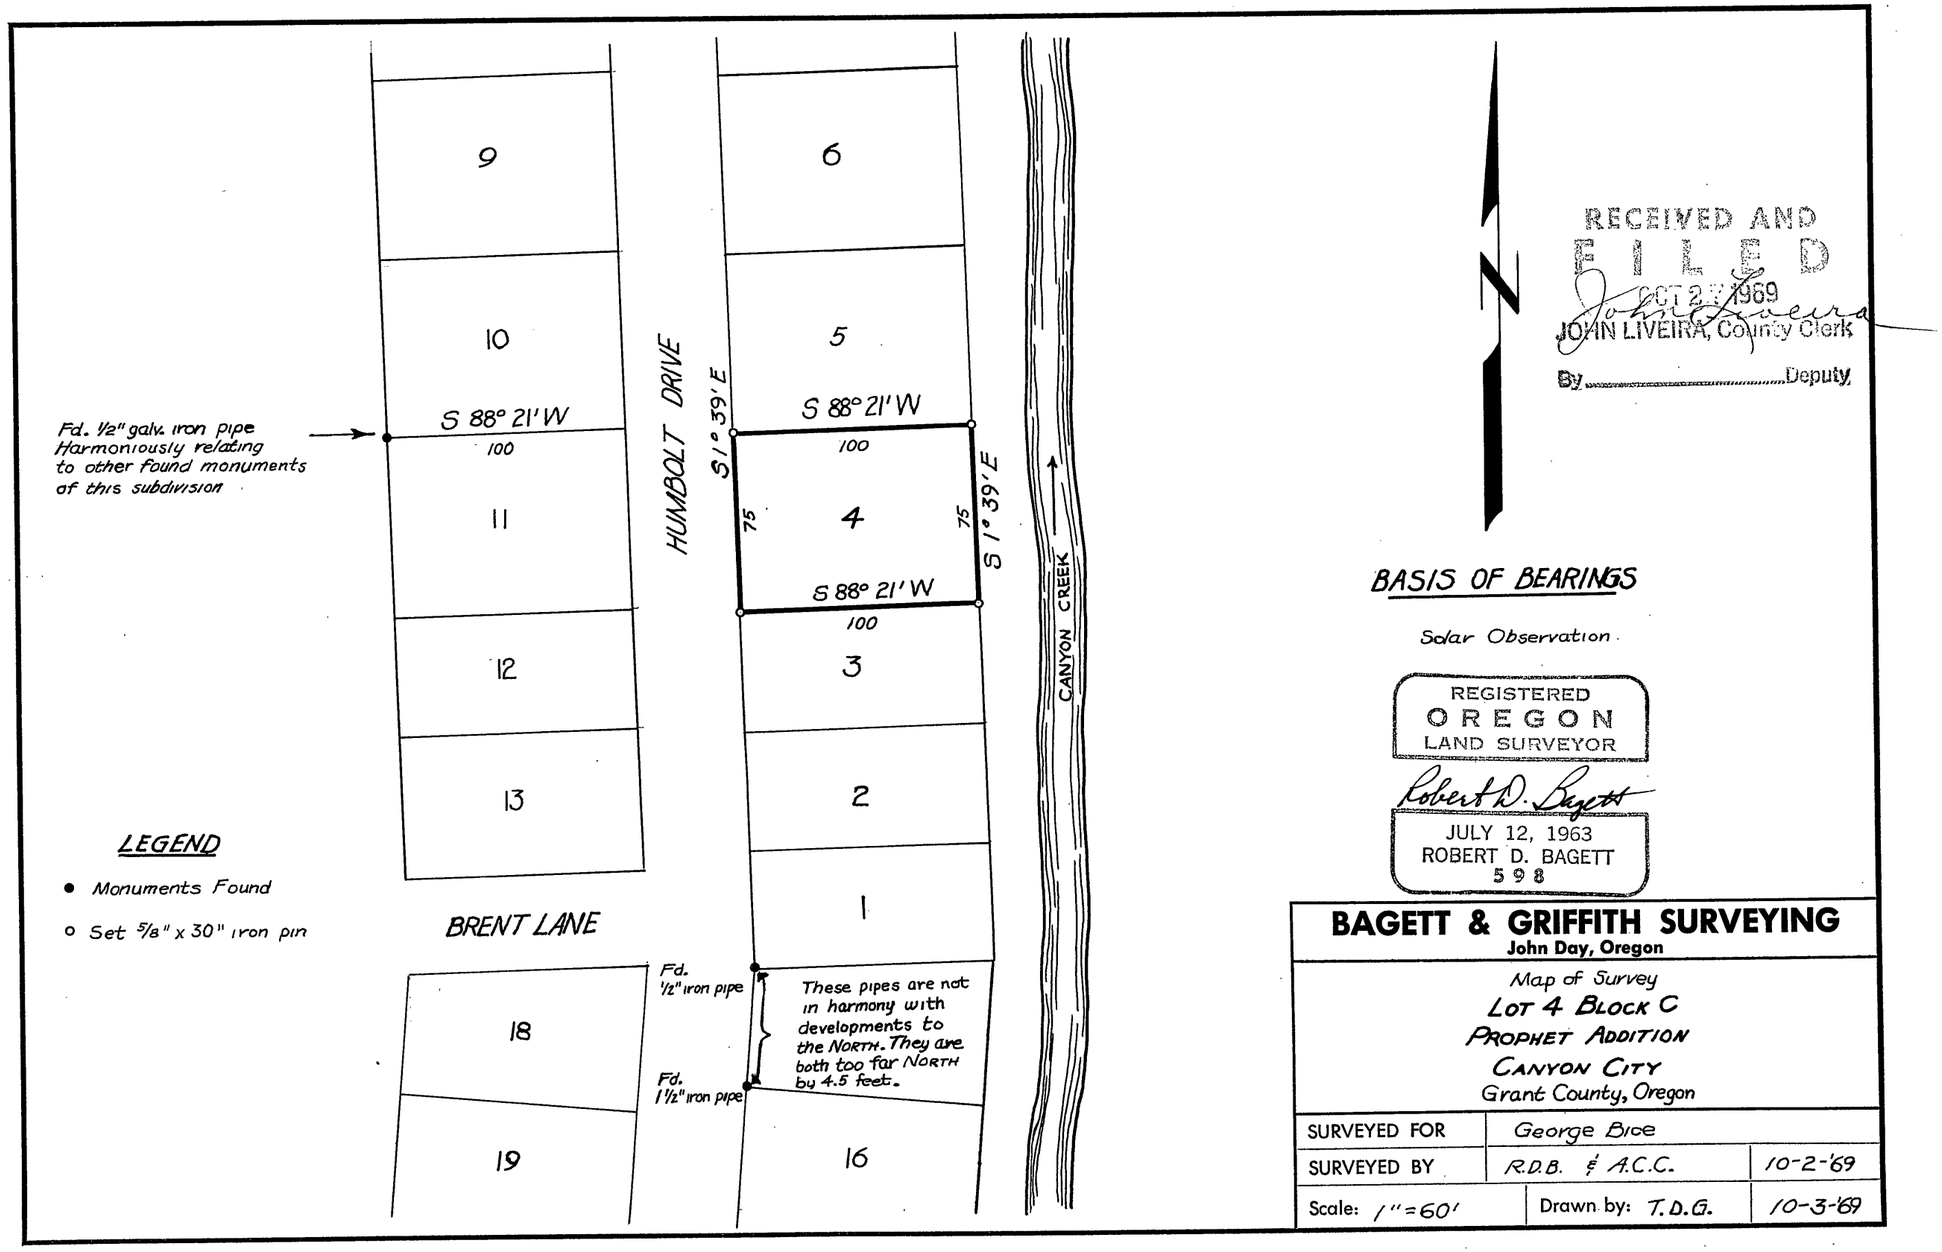
9
10
11
12
13
6
5
4
3
2
1
18
19
16
HUMBOLT DRIVE
CANYON CREEK
BRENT LANE
S 88° 21' W
100
S 1° 39' E
75
Fd. 1/2" galv. iron pipe Harmoniously relating to other found monuments of this subdivision
Fd. 1/2" iron pipe
Fd. 1 1/2" iron pipe
These pipes are not in harmony with developments to the NORTH. They are both too far NORTH by 4.5 feet.
LEGEND
• Monuments Found
o Set 5/8" x 30" iron pin
N
BASIS OF BEARINGS
Solar Observation
RECEIVED AND FILED
OCT 2 7 1969
JOHN LIVEIRA, County Clerk
By ..... Deputy
REGISTERED OREGON LAND SURVEYOR
JULY 12, 1963
ROBERT D. BAGETT
598
BAGETT & GRIFFITH SURVEYING
John Day, Oregon
Map of Survey
LOT 4 BLOCK C
PROPHET ADDITION
CANYON CITY
Grant County, Oregon
SURVEYED FOR George Bice
SURVEYED BY R.D.B. & A.C.C. 10-2-'69
Scale: 1"=60' Drawn by: T.D.G. 10-3-'69

SURVEY #150