UMATILLA COUNTY GROUND CONTROL DATUM: NAD83(91) NGVD29 ZONE: 3601 OREGON NORTH STATE PLANE IN: INTERNATIONAL FEET

LATITUDE (N)	LONGITUDE (W)	NGVD 29(47)	11112 30101	(INTL FEET)	NGVD 29				7 1/2 MIN.				1	
45°29′47.033″	119°27′33.086″	HEIGHT (M)	NORTHING	EASTING	HEIGHT (USft)		SCALE FACTOR		QUAD	1/4	SEC	TWN	RGE	STATION DESCRIPTION—TO REACH STATEMENT
	117 E7 33.000	790.892	668/92./1/	8468974.158	2594.785	0°44′17,258″	0.999910912	211	GLEASON BUTTE-OR	NE	9	18	27E	12"STEEL SPIKE WITH WASHER INSCRIBED "EAGLE GPS SURVEY"-FROM PINE CITY, GO SOUTHWESTERLY ON LITTLE BUTTER CR. RD, 2.3 MILES, TO FORK. TAKE RIGHT FORK AND GO 2.25 MILES TO ROCK ROAD ON LEFT. GO SOUTHEASTERLY ON ROCK ROAD, 3.6 MILES, TO THE STATION ON SW EDGE OF ROAD.
	118°49′57.696″	518.754	673123.966	8629562.312	1701.945	1°10′56.749″	0.999911363	212	MAKAY RESERVOIR OR	SE	5	15	32E	5/8"IRON ROD WITH YELLOW PLASTIC CAP INSCRIBED "EAGLE GPS CONTROL STA"- FROM PILOT ROCK, GO NORTH ON MILL ROAD TO MILE POST 1 PROCED 0 20 MILES TO STATION
45°29′34.852″	118°24′52.034″	1156.383	672742.337	8736842.871	3793.900	1°28′44.544″	0.999910576	213	MEACHAM LAKE-OR	SW	11	15	35E	TO THE NORTH. STATION IS 35' WEST AND 18' SOUTH OF GATE TO PILOT ROCK GUN CLUB.  5/8"IRON ROD WITH YELLOW PLASTIC CAP INSCRIBED "EAGLE GPS CONTROL STA" - TAKE EXIT #238  OFF OF I-84 SOUTHBOUND. AT THE STOP SIGN THE STATION IS LOCATED 100' EAST OF OFF-RAMP
45°39′55.164″	118*06'26.289"	1406,665		8813715.913	4615.033	1°41′48.723″	0.999932126	214	ANDIES PRAIRIE-OR	SW	7	2N	1	AND 100' NORTHERLY OF ROAD UNDER I-84 IN THE NW QUADRANT OF THE INTERCHANGE.  5/8"IRON ROD WITH YELLOW PLASTIC CAP INSCRIBED "EAGLE GPS CONTROL STA"- FROM ELGIN AT THE INTERSECTION OF HWY'S 82 AND 204, GO WESTERLY ON HWY 204 FOR 12.9 MILES TO FSR 31. TAKE FSR 31 WESTERLY 5.3 MILES TO A FOUR WAY INTERSECTION OF FSR 31, 3155 AND 3728. CONTINUE WESTERLY OF FSR 31 FOR 0.35 MILES TO ROAD ON LEFT. TURN LEFT AND PROCEED 0.05 MILES TO STATION ON RIGHT.
	118°48′58.328″	1204.361	486738.107	8637676.611	3951.308	1°11′38.852″	0.999899463	216	COCKSCOMB OR	SW	1	7\$		5/8"IRON ROD WITH YELLOW PLASTIC CAP INSCRIBED "EAGLE GPS CONTROL STA"- NEAR DALE, DR, FROM THE INTERSECTION OF HWY 395 AND QUIMBY ROAD, GO EAST ON QUIMBY (FSR 55) ROAD 4± MILES TO FSR 5505 AND BRIDGE OVER THE NORTH FORK OF THE JOHN DAY RIVER. TURN RIGHT ON FR 5505 AND GO 3.6± MILES TO QUARRY ACCESS ROAD. PARK AT
	118°03′52,259″	835.460		8828543.953	2741.005	1°43′37.959″	0.999897655	LA GRANDI CBL 0 PT	LA GRANDE, SE-OR	NE	16	32		GATE AND WALK 100 YARDS TO CENTER OF QUARRY AND STATION.  2"BRASS PLSO DISK-FROM EXIT #265 OFF OF I-84 GO WESTERLY ON HWY 30 1.65 MILES TO A FARM LANE NEAR GEKELER LANE. TURN LEFT ONTO FARM LANE AND STATION. SEE THE THE NATIONAL GEODETIC SURVEY DESCRIPTION FOR PRECISE LOCATION.
	119°18′01.317″			8507269.580	361.043	0°51′02.749″	0.999986364	B 340	UMATILLA OR	SW	3	5N		3 1/2"BRASS DISC STAMPED "B 340 1951"- FROM PLYMOUTH, WA, GO EASTERLY ON SR-14 0.8 MILE TO OVERPASS OF I-82. CONTINUE EASTERLY 1.4 MILES TO RAILROAD OVERPASS. CONTINUE EASTERLY 0.4 MILES TO BOAT LAUNCH PARKING AREA. TURN LEFT AND GO NORTHON TRACK ROAD 0.1 MILES TO RAILROAD TRACK AND STATION. SEE THE NATIONAL GEODETIC SURVEY DESCRIPTION FOR PRECISE LOCATION.
	118*57'27.865"		540108.994	8600034.257	3313.642	1°05′37.496″	0.999894728	FORE	UKIAH DR	NW	15	58	31E	3 1/2"BRASS DISC STAMPED "FORE 1989"- STATION IS LOCATED IN THE SW QUADRANT OF THE INTERSECTION OF HWY 395 AND HWY 244, 1.3 MILES EAST OF UKIAH. SEE THE NATIONAL GEODETIC SURVEY DESCRIPTION FOR PRECISE LOCATION.
45°40′01.475″ SURVEYOR: W.L.C	118°46′38.960″	402.900	733999.514	8642421.693	1321.848	1°13′17.690″	0.999932392	PENDLETON	PENDLETON OR	NE	9	2N	32E	3 1/2"BRASS DISC STAMPED "PENDLETON 1963"- AT EXIT #210 OFF OF I-84, GO NORTH ON THIRD STREET FOR 0.3 MILES TO CROSS ROAD. TURN EAST ON GOODWIN STREET FOR 0.1 MILES TO INTERSECTION. TURN RIGHT ON SE 8TH STREET GO 0.4 MILES TO THE INTERSECTION OF SE 6TH STREET AND E. ISAAC STREET. CONTINUE ON 6TH STREET 0.2 MILES TO END OF ROAD AND THE STATION. SEE THE NATIONAL GEODETIC SURVEY DESCRIPTION FOR PRECISE LOCATION.
DRAWN BY: B.S.S		РНОТО	CONTRO	L SURVE	Y									REGISTERED

DATE: 11/13/98

J□B N□. 98-004

SHEET 3 OF 3

FOO CONTROL SURVEY

FOR THE COUNTY OF UMATILLA

LOCATED IN T.1S, R.27E; T.1S, R.28E; T.1S, R.32E; T.1S, R.35E;


T.2S,R.35E; T.2N,R.32E; T.2N,R.38E; T.2N, R.39E; T.3S, R.38E;


T.5S,R.31E; T.5N,R.27E; T.5N, R.28E; T.6N, R.31E; T.6N, R.36E;

T.6N, R.39E; T.7S,R.29E; T.7S,R.32E; T.7S,R.35E

IN GRANT, MORROW, UNION, UMATILLA AND WALLOWA COUNTY, OREGON;

WALLA WALLA AND BENTON COUNTY, WASHINGTON

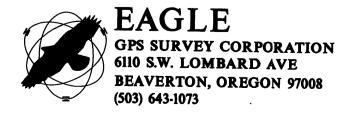

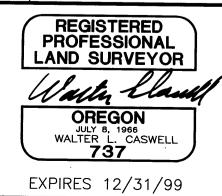

	,		
	•		
N□.	REVISION	DATE	BY