
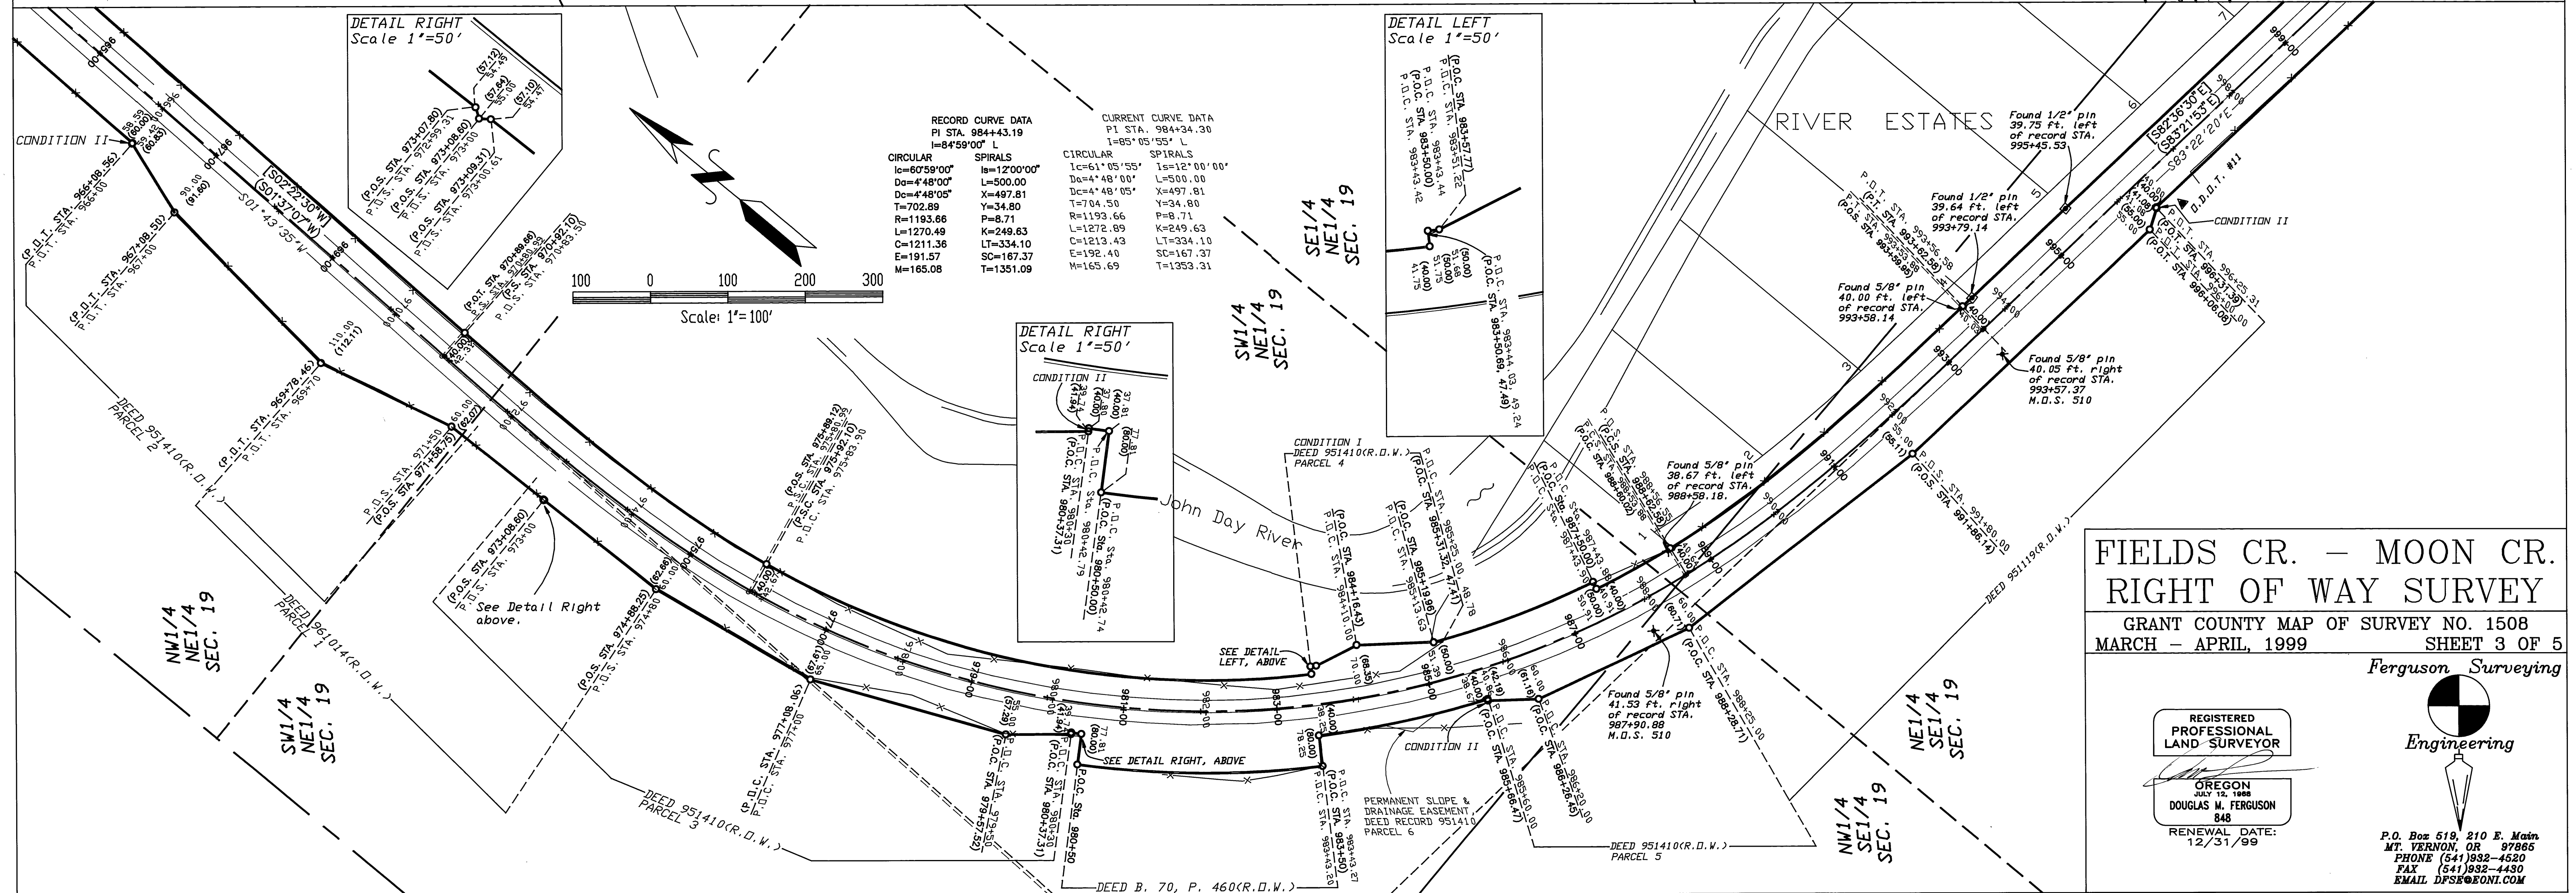


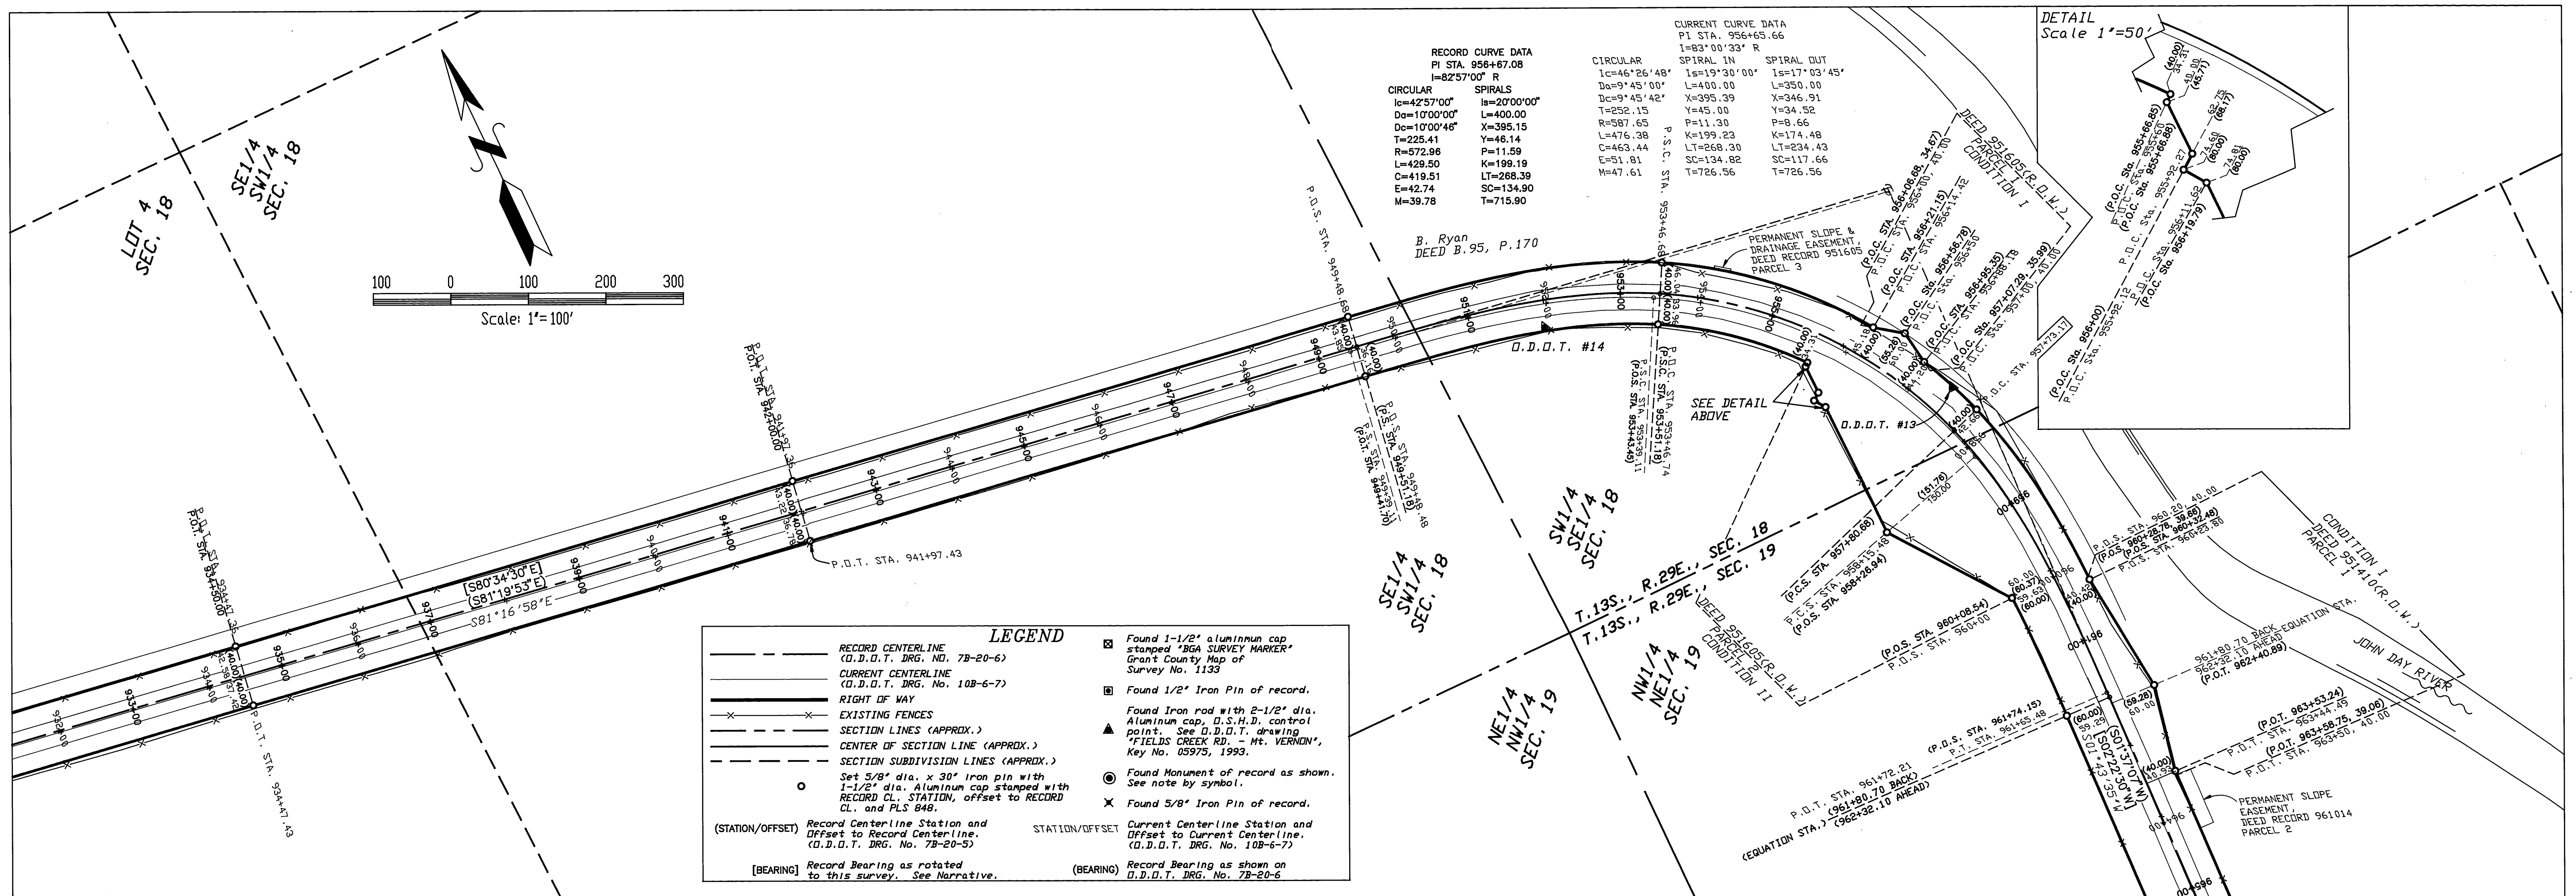

FIELDS CR. - MOON CR.
RIGHT OF WAY SURVEY
 GRANT COUNTY MAP OF SURVEY NO. 1508
 MARCH - APRIL, 1999
 SHEET 3 OF 5

Ferguson Surveying
 REGISTERED PROFESSIONAL LAND SURVEYOR
 OREGON
 JULY 12, 1988
 DOUGLAS M. FERGUSON
 RENEWAL DATE: 12/31/99

Engineering
 P.O. Box 519, 210 E. Main
 MT. VERNON, OR 97565
 PHONE (541) 832-4520
 FAX (541) 832-4430
 EMAIL DFSE@RONI.COM