
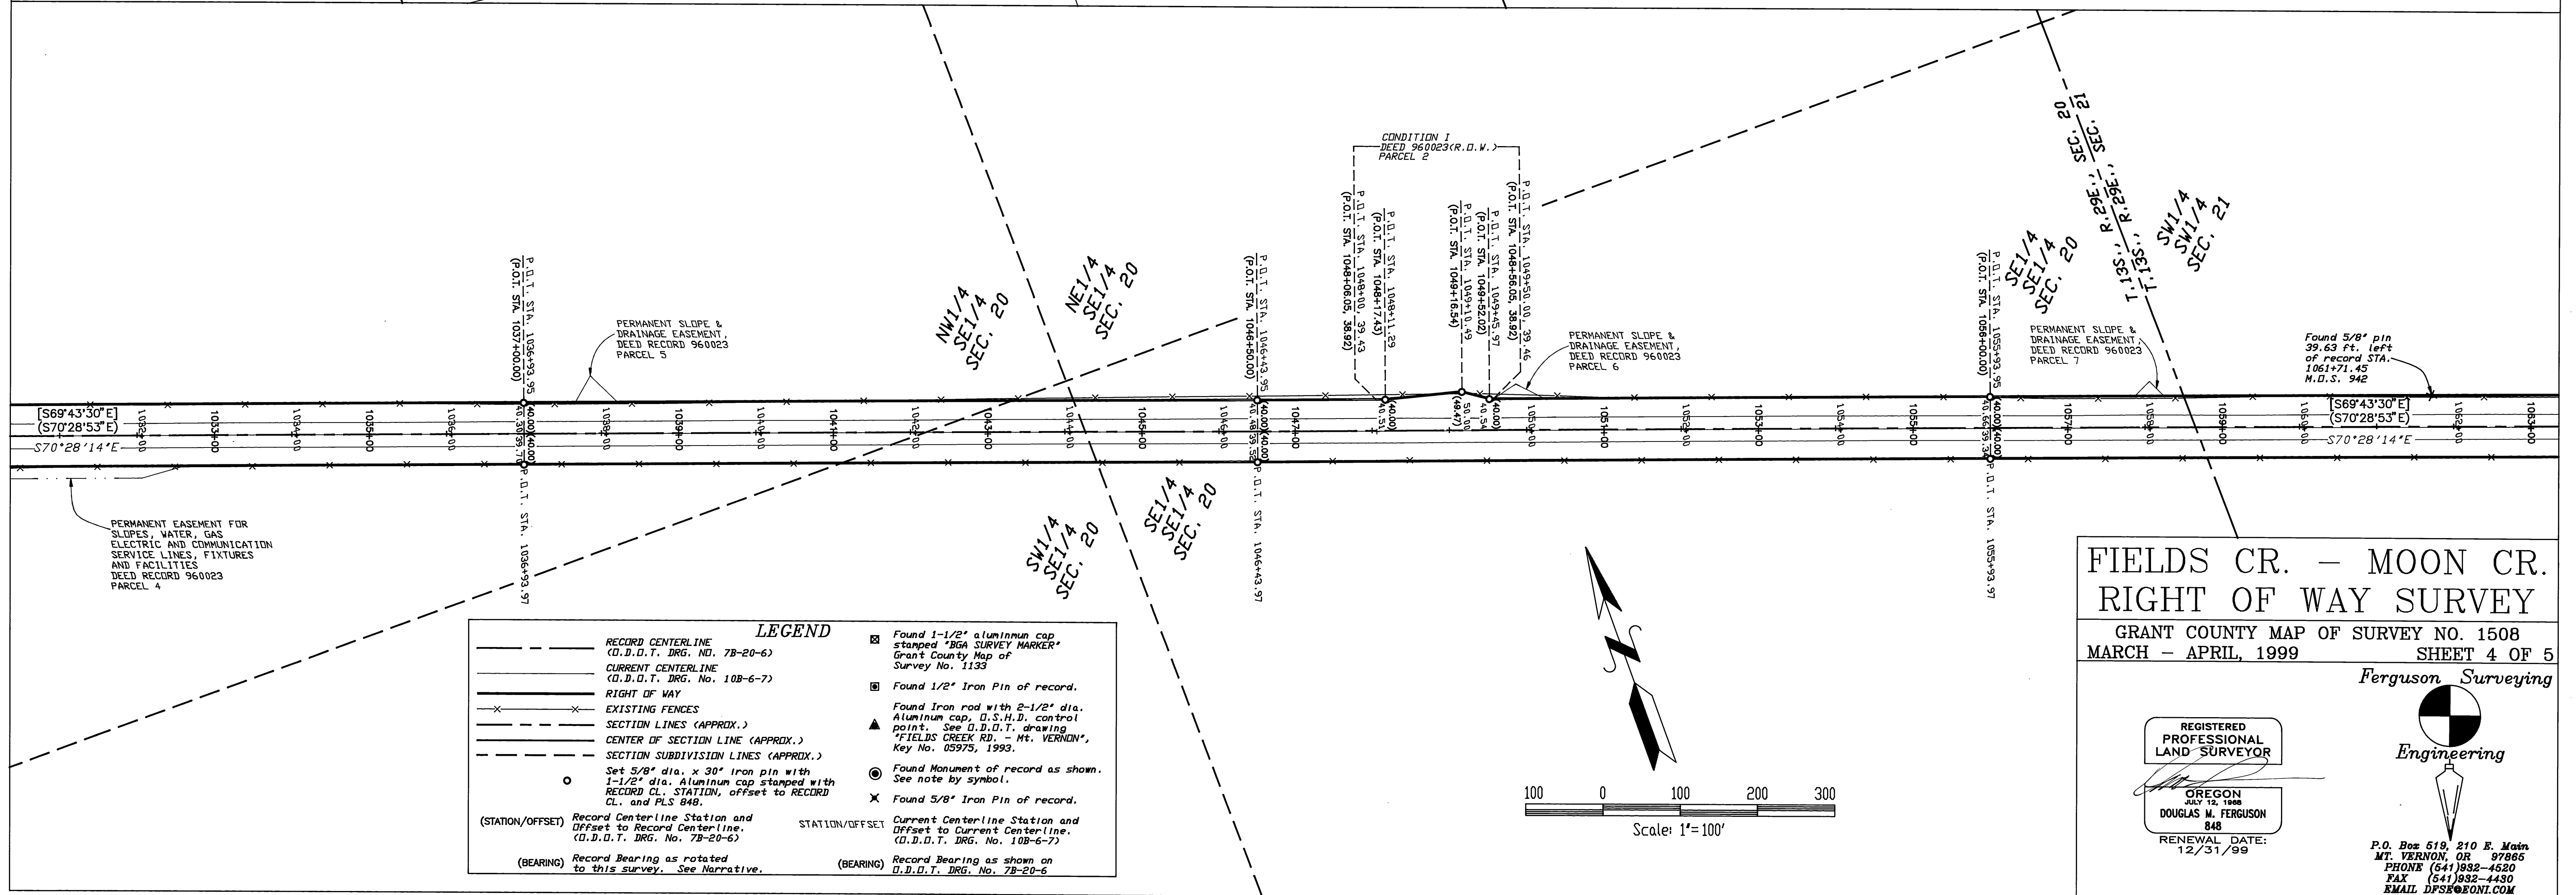


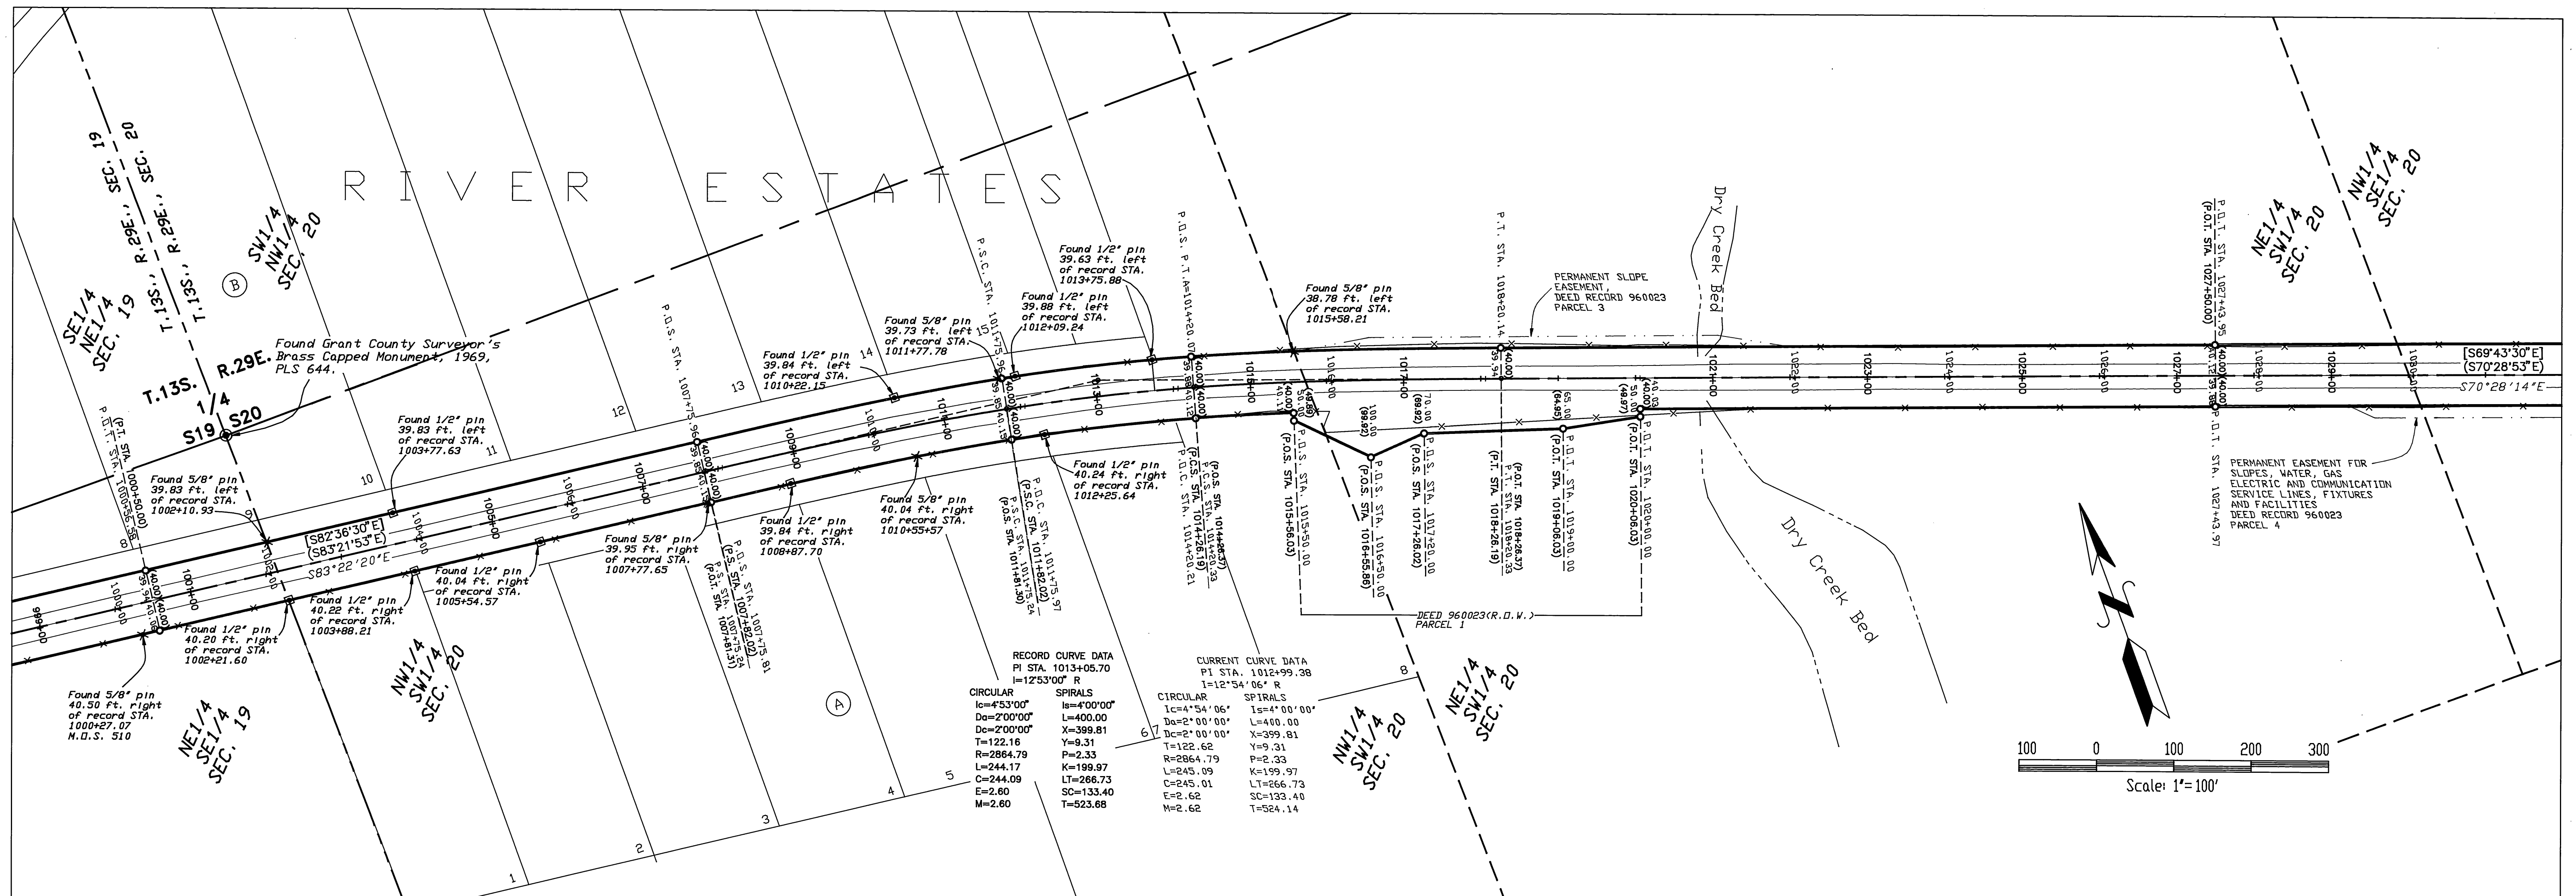


FIELDS CR. - MOON CR. RIGHT OF WAY SURVEY

GRANT COUNTY MAP OF SURVEY NO. 1508
MARCH - APRIL, 1999 SHEET 4 OF 5

Ferguson Surveying

REGISTERED
PROFESSIONAL
LAND SURVEYOR

OREGON
JULY 10, 1998
DOUGLAS M. FERGUSON
848
RENEWAL DATE:
12/31/99

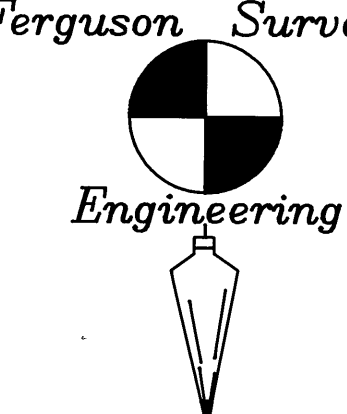

