


RECEIVED AND
FILED
 OCT 27 1969
 JOHN L. VEIRA, County Clerk
 By _____ Deputy

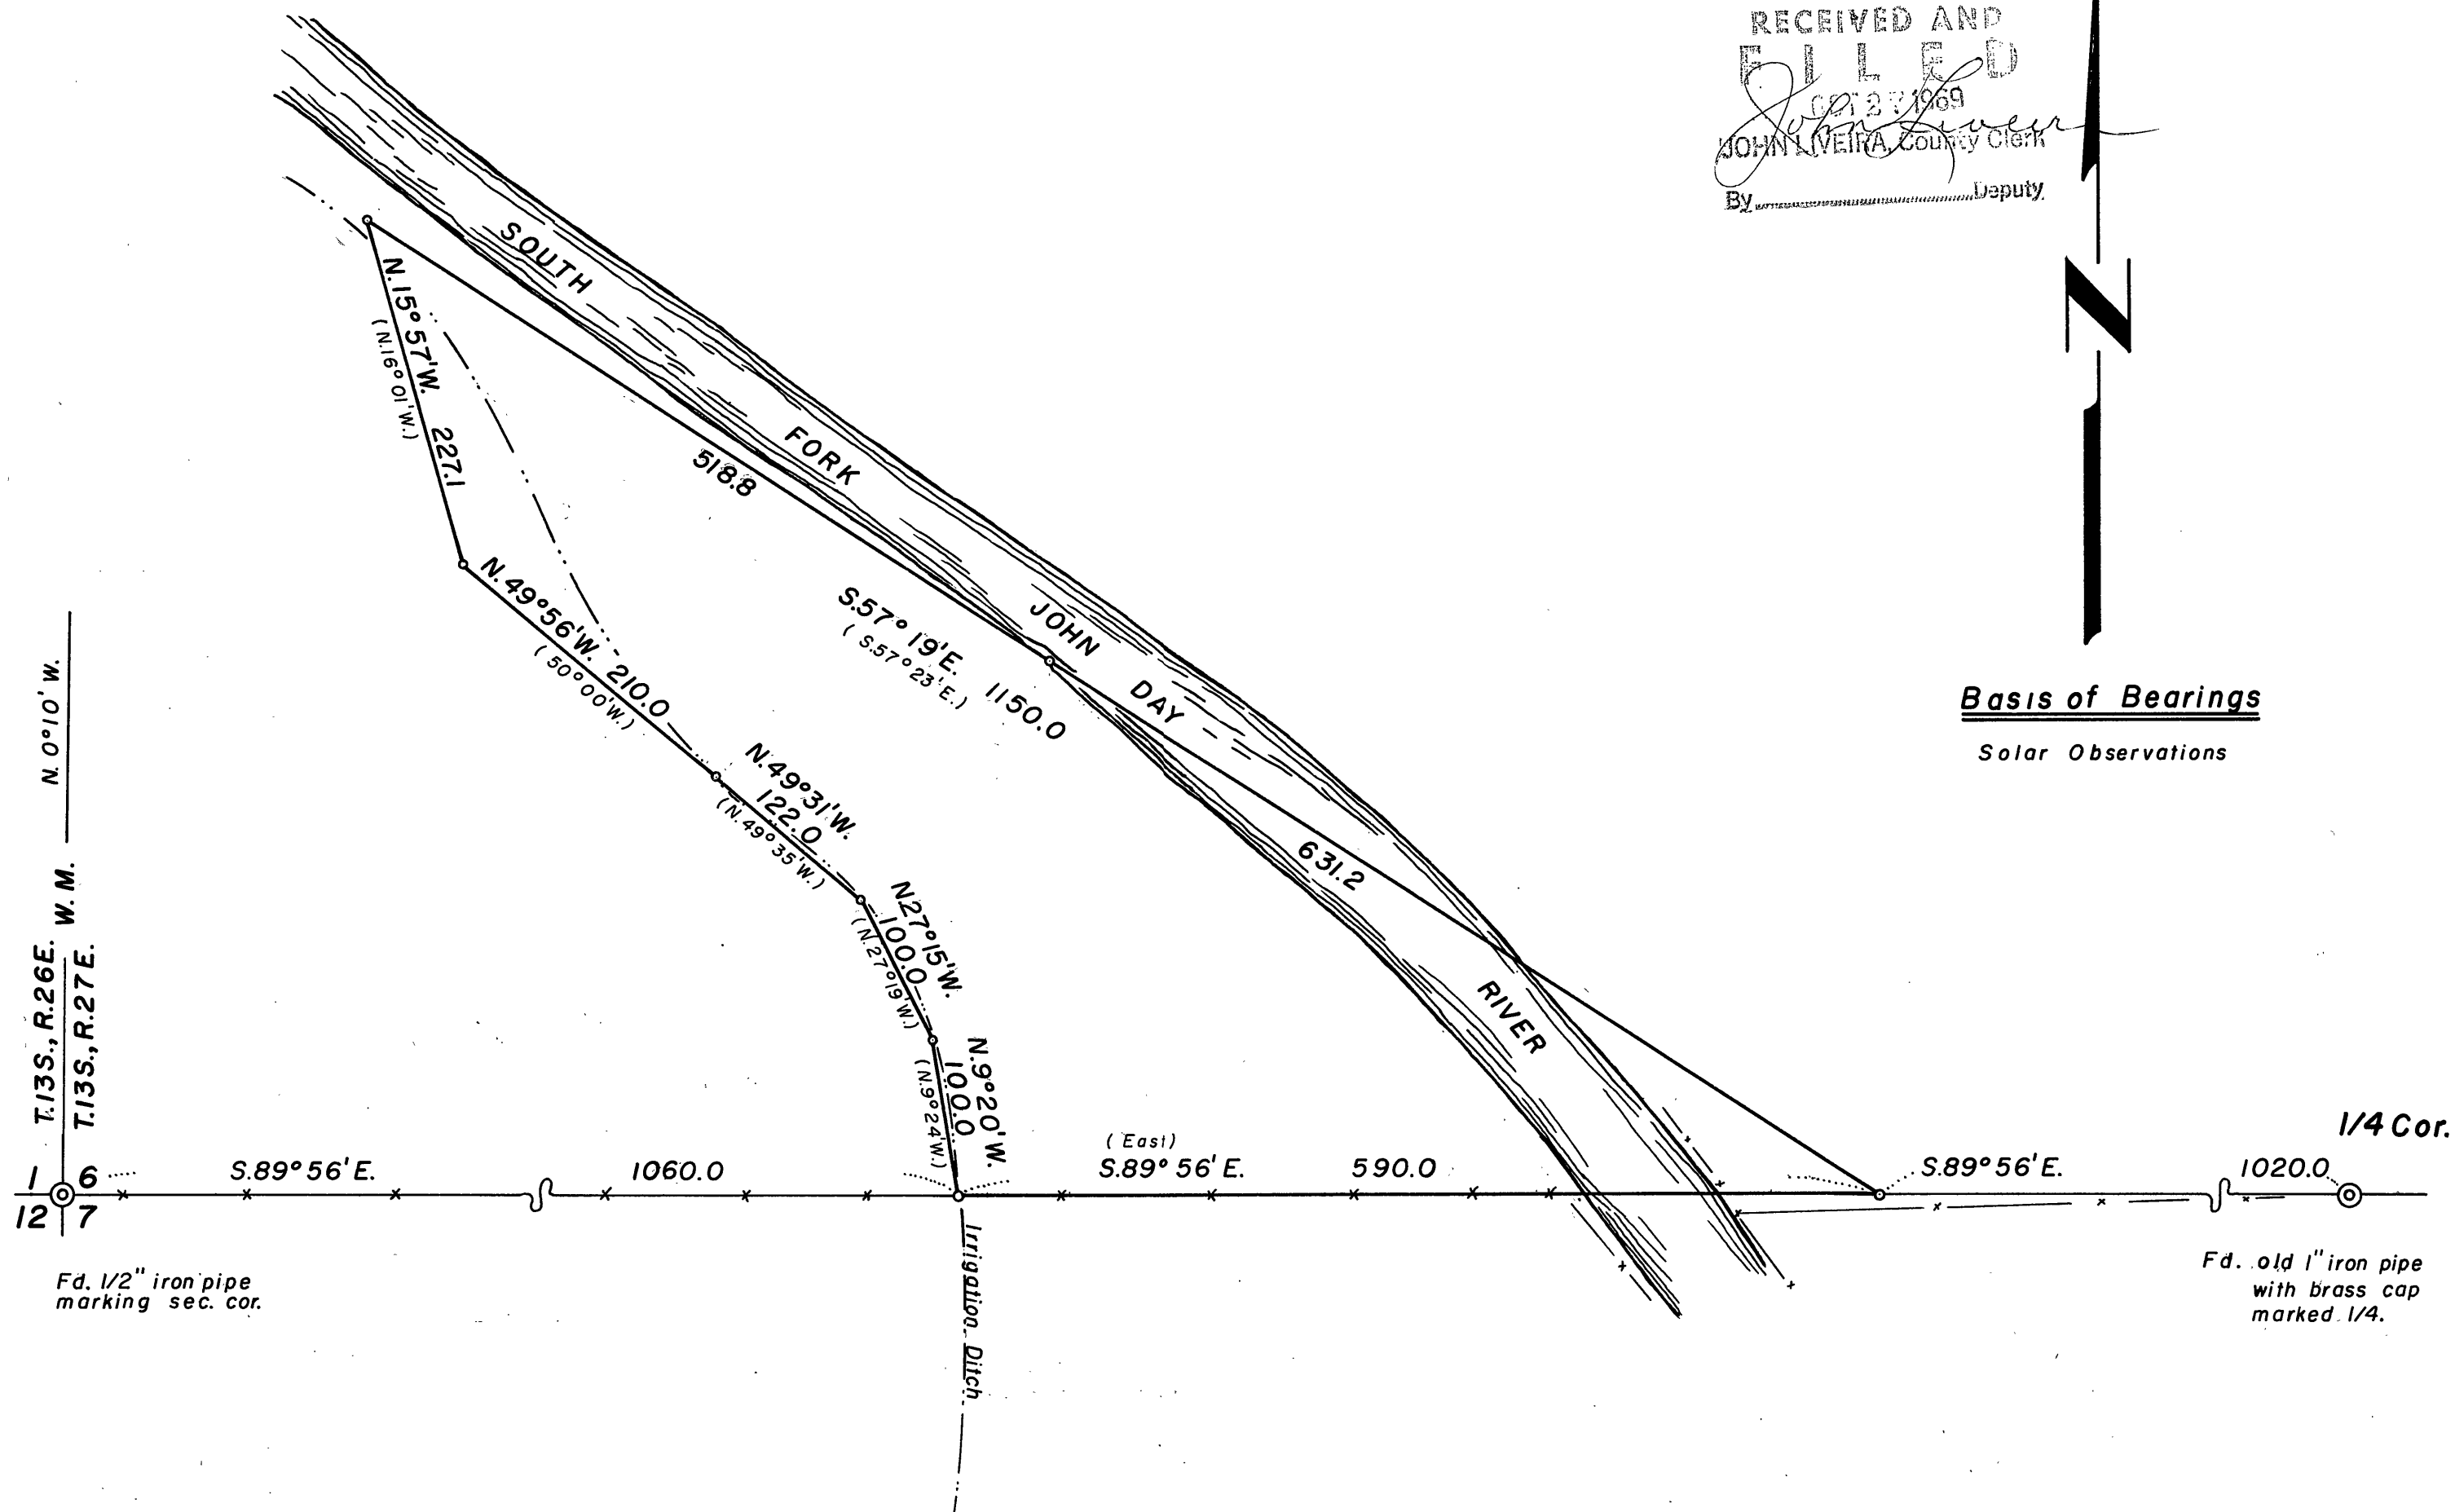

Basis of Bearings
 Solar Observations



Fd. 1/2" iron pipe
 marking sec. cor.

Fd. old 1" iron pipe
 with brass cap
 marked 1/4.

LEGEND

- o Set 5/8" x 30" iron pin
- ⊙ Found monuments
- x— Fence

REGISTERED
OREGON
 LAND SURVEYOR

Robert D. Bagett

JULY 12, 1963
 ROBERT D. BAGETT
 598

BAGETT & GRIFFITH SURVEYING

John Day, Oregon

Map of Survey

Parcel in Dayville

Grant County, Oregon

SURVEYED FOR	Ed Zedwick	
SURVEYED BY	R.D.B. & A.C.C.	10/15/69
Scale: 1" = 100'	Drawn by: R.D.B.	10/18/69