

8/1999

Field Date
JAC 8/1999
Calculations
MEM 11/1999
Drawn
JAC 11/1999
Checked By Date

REGISTERED
PROFESSIONAL
LAND SURVEYOR

J. A. Carlson
OREGON
JULY 15, 1983
JOHN A. CARLSON
2044

RENEWS 12-31-1999

HORIZONTAL CONTROL NETWORK SURVEY

PRAIRIE CITY - DIXIE SUMMIT SECTION
JOHN DAY HIGHWAY

- SW 1/4 SEC. 28, T.11S., R.34E.
- NE 1/4 SEC. 33, T.11S., R.35E.
- NE, SE, SW 1/4 SEC. 16, NW, SW 1/4 SEC. 21, NW 1/4 SEC. 28, NE, SE 1/4 SEC. 29,
SE 1/4 SEC. 31, NE, NW, SW 1/4 SEC. 32, T.12 S., R.34E.
- SE, SW 1/4 SEC. 1, SE, SW 1/4 SEC. 2, NE 1/4 SEC. 10, SW 1/4 SEC. 11,
NE 1/4 SEC. 12, NE 1/4 SEC. 14, T.13S., R.35E.
- NE, SE, SW 1/4 SEC. 6, NW 1/4 SEC. 7, T.13S., R.34E.

FOR: OREGON DEPARTMENT OF TRANSPORTATION REGION 5



Incorporated

17355 SW Boones Ferry Rd.
Lake Oswego, Oregon 97035
Phone: (503) 635-3618
FAX: (503) 635-5395

09356-004-004

Project No.

S356S001


File No.

1 OF 12


Sheet No.




NOT TO SCALE

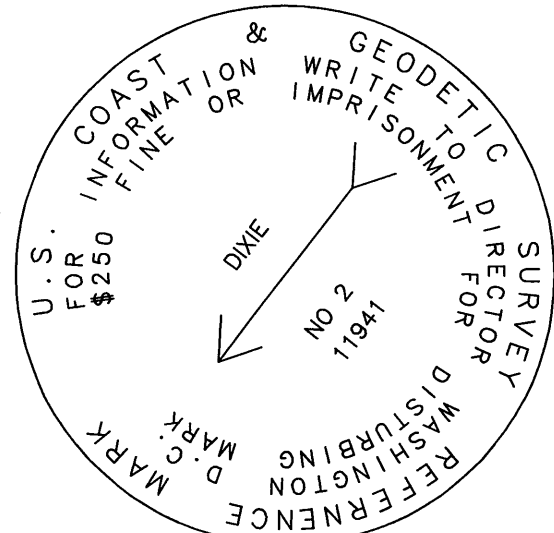


DIXIE RM NO. 2
FOUND 3.5" BRASS DISK

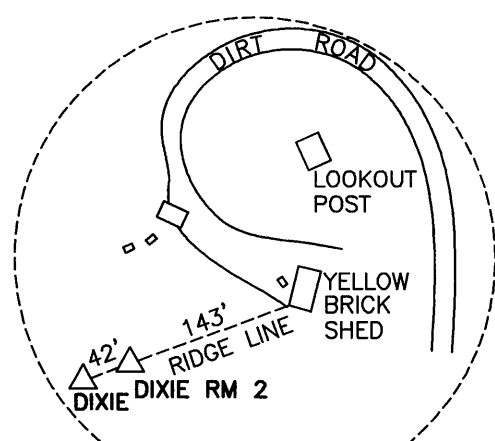


NOT TO SCALE

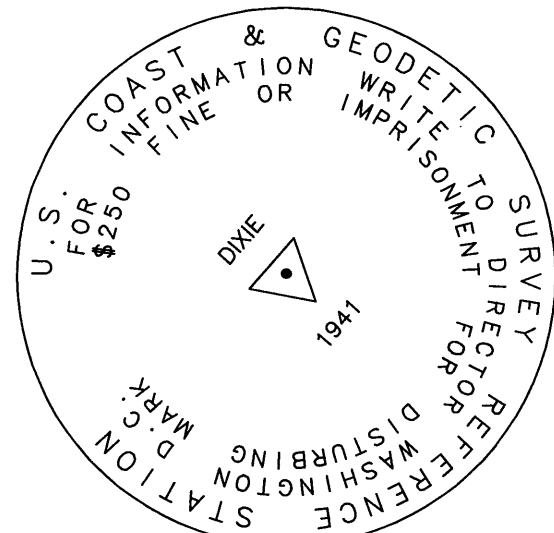

STATION DIXIE
FOUND 3.5" BRASS DISK

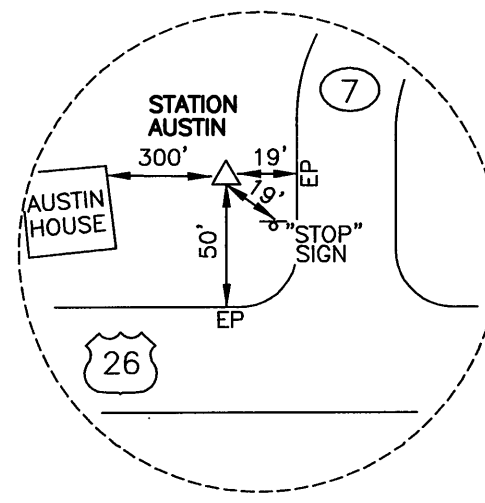

NOT TO SCALE

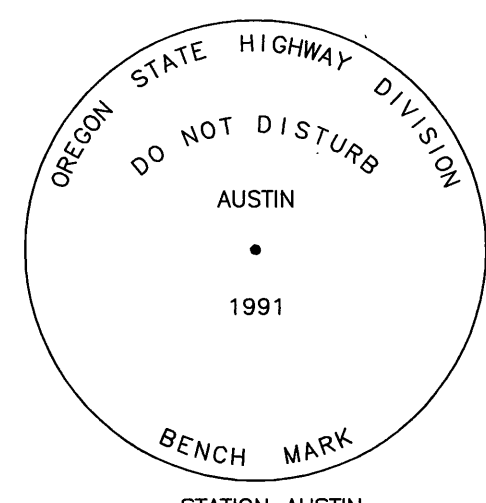

STATION AUSTIN
FOUND 3" BRASS DISK
IN CONCRETE - FLUSH

LEGEND

- △ DENOTES CONTROL POINT SET
- DENOTES RECOVERED AND HELD GEODETIC CONTROL MONUMENT
- ▲ DENOTES OTHER RECOVERED MONUMENT
- - - DENOTES GPS MEASUREMENT

TABLE OF CONTENTS


SHEET 1	1983(91) ADJUSTMENT NETWORK FRAMEWORK (ADJUSTMENT NO.1)
SHEET 2	1983(86) ADJUSTMENT NETWORK FRAMEWORK (ADJUSTMENT NO.2), SHEET LAYOUT
SHEET 3	NARRATIVE, COORDINATE TABLES
SHEET 4	CONTROL POINTS 1-11, RECOVERED MONUMENTS ODOT4 AND ODOT5
SHEET 5	CONTROL POINTS 11-17, RECOVERED MONUMENT ODOT9
SHEET 6	CONTROL POINTS 17-19, RECOVERED MONUMENTS 201, ODOT9, ODOT10, ODOT11
SHEET 7	CONTROL POINTS 19-23, RECOVERED MONUMENTS ODOT11, ODOT12
SHEET 8	CONTROL POINTS 24-29, RECOVERED MONUMENTS 202, ODOT14
SHEET 9	CONTROL POINTS 30-35
SHEET 10	CONTROL POINTS 35-40, RECOVERED MONUMENT 200
SHEET 11	CONTROL POINTS 40-45, RECOVERED MONUMENTS ODOT23, ODOT24
SHEET 12	CONTROL POINTS 45-54, RECOVERED MONUMENTS 203, 204, ODOT24, ODOT27

ADJUSTMENT NO. 1 NETWORK

(SEE NARRATIVE ON SHEET 3)

RECEIVED AND
FILED

DEC. 13, 1997
OFFICE OF CLERK
CLERK

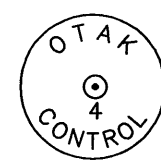

SET PK NAIL
WITH 1-1/2"
BRASS WASHER




SET 5/8" X 30"
IRON ROD WITH 2"
ALUMINUM CAP

TYPICAL MONUMENTS SET

DESCRIPTIONS OF MONUMENTS RECOVERED AND SET
ARE SHOWN ON THE APPROPRIATE SHEET.

STATION PRAIRIE CITY
N. BASE RESET
(NORTH BASE)
FOUND 3.5" BRASS DISK
IN 10"x10" CONC. POST
FLUSH WITH GROUND

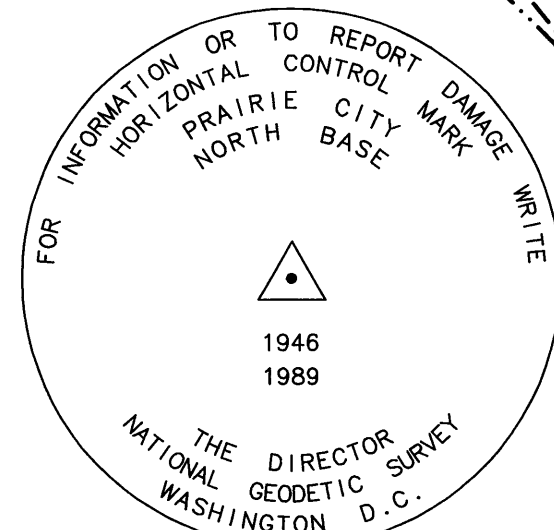

PTS. 2-16
SEE SHEET 2

NORTH BASE
AZIMUTH MARK
SEE SHEET 2

NORTH
BASE
(HELD)

