

8/1999

Field Date

JAC 8/1999

Calculations

MEM 11/1999

Drawn

JAC 11/1999

Checked By Date

REGISTERED
PROFESSIONAL
LAND SURVEYOR

John A. Carlson

OREGON
JULY 15, 1983
JOHN A. CARLSON
2044

RENEWS 12-31-1999

HORIZONTAL CONTROL NETWORK SURVEY

PRAIRIE CITY - DIXIE SUMMIT SECTION

JOHN DAY HIGHWAY

- SW 1/4 SEC. 28, T.11S., R.34E.
- NE 1/4 SEC. 33, T.11S., R.35E.
- SE 1/4 SEC. 31, NE, NW, SW 1/4 SEC. 21, NW 1/4 SEC. 28, NE, SE 1/4 SEC. 29,
- SE 1/4 SEC. 31, NE, NW, SW 1/4 SEC. 32, T.12 S., R.34E.
- NE 1/4 SEC. 1, SE, SW 1/4 SEC. 2, NE 1/4 SEC. 10, SW 1/4 SEC. 11,
- NE 1/4 SEC. 12, NE 1/4 SEC. 14, T.13S., R.33E.
- NE, SE, SW 1/4 SEC. 6, NW 1/4 SEC. 7, T.13S., R.34E.

FOR: OREGON DEPARTMENT OF TRANSPORTATION REGION 5



Incorporated

17355 SW Boones Ferry Rd.
Lake Oswego, Oregon 97035
Phone: (503) 635-3618
FAX: (503) 635-5395

09356-004-004

Project No.

S356S011

File No.

11 OF 12

Sheet No.


LEGEND



DENOTES CONTROL POINT SET



DENOTES OTHER RECOVERED MONUMENT

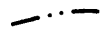

DENOTES GPS MEASUREMENT



DENOTES TERRESTRIAL MEASUREMENT



DENOTES SIGN



300 150 0 300

SCALE 1" = 300'

SEE SHEET 10

SEE SHEET 12


TYPICAL MONUMENTS SET




SET PK NAIL
WITH 1-1/2" BRASS WASHER




SET 5/8" X 30"
IRON ROD WITH 2"
ALUMINUM CAP

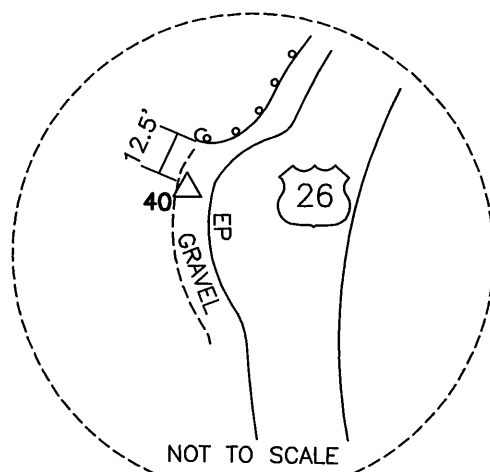


CONTROL POINT #40
SET 5/8" IRON ROD WITH 2"
ALUMINUM CAP STAMPED "OTAK INC., 40",
9.0' FROM EDGE OF PAVEMENT

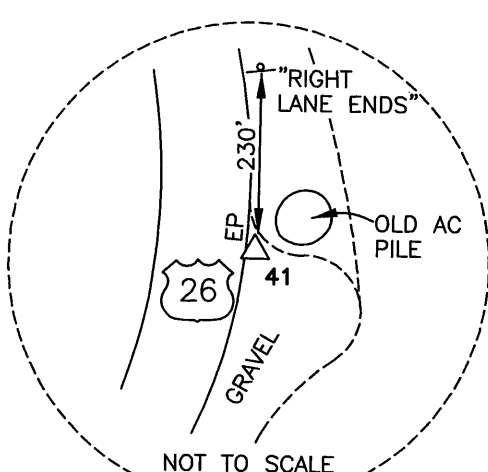


CONTROL POINT #41
SET 5/8" IRON ROD WITH 2"
ALUMINUM CAP STAMPED "OTAK INC., 41",
2.5' FROM EDGE OF PAVEMENT

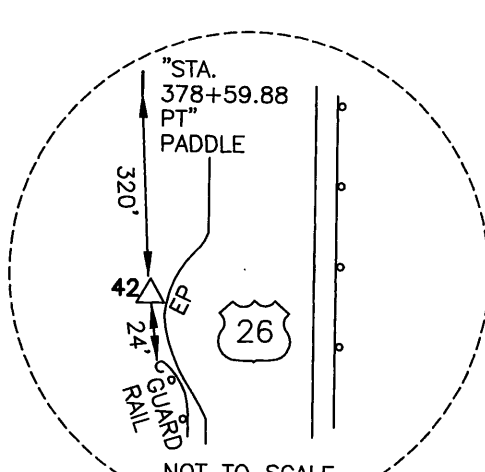


CONTROL POINT #42
SET 5/8" IRON ROD WITH 2"
ALUMINUM CAP STAMPED "OTAK INC., 42",
2' FROM EDGE OF PAVEMENT

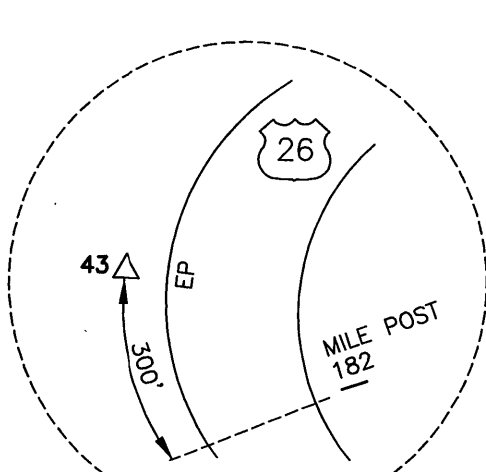

CONTROL POINT #43
SET 5/8" IRON ROD WITH 2"
ALUMINUM CAP STAMPED "OTAK INC., 43",
5' FROM EDGE OF PAVEMENT

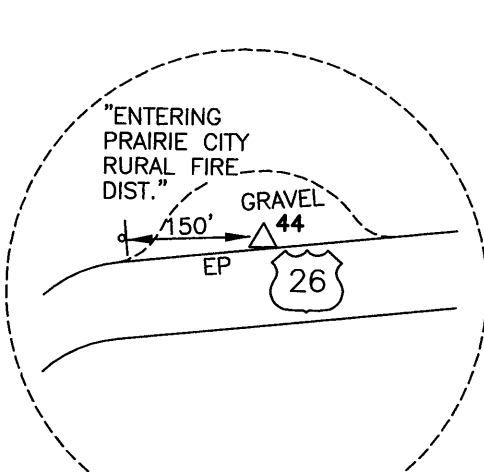


CONTROL POINT #44
SET 5/8" IRON ROD WITH 2"
ALUMINUM CAP STAMPED "OTAK INC., 44",
1.5' FROM EDGE OF PAVEMENT

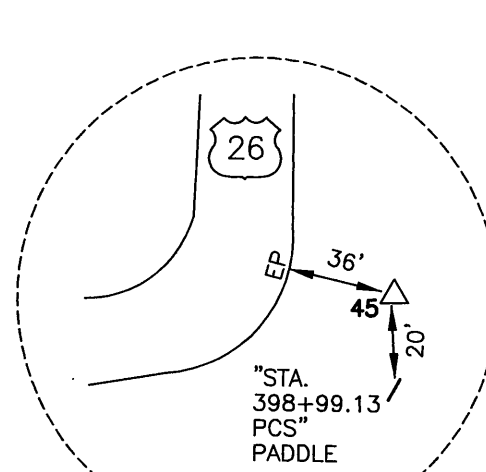

CONTROL POINT #45
SET 5/8" IRON ROD WITH 2"
ALUMINUM CAP STAMPED "OTAK INC., 45"



ODOT CONTROL POINT #23
FOUND 5/8" SMOOTH IRON ROD
WITH 1-1/2" ALUMINUM CAP,
DOWN 0.3'

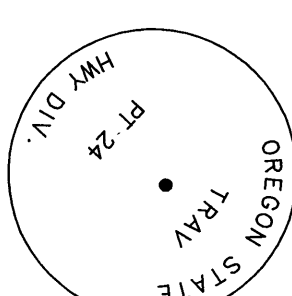

ODOT CONTROL POINT #24
FOUND 5/8" SMOOTH IRON ROD
WITH 1-1/2" ALUMINUM CAP,
UP 0.3'