


LEGEND

- DENOTES CONTROL POINT SET
- DENOTES OTHER RECOVERED MONUMENT
- DENOTES GPS MEASUREMENT
- DENOTES SIGN


TYPICAL MONUMENTS SET

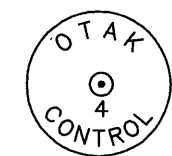


SET PK NAIL
WITH 1-1/2" BRASS WASHER




SET 5/8" X 30"
IRON ROD WITH 2"
ALUMINUM CAP

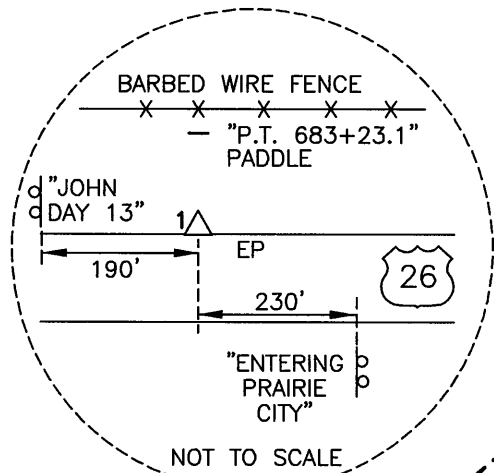


CONTROL POINT #1
SET 5/8" IRON ROD WITH 2"
ALUMINUM CAP STAMPED "OTAK INC., 1",
ALONG THE EDGE OF PAVEMENT

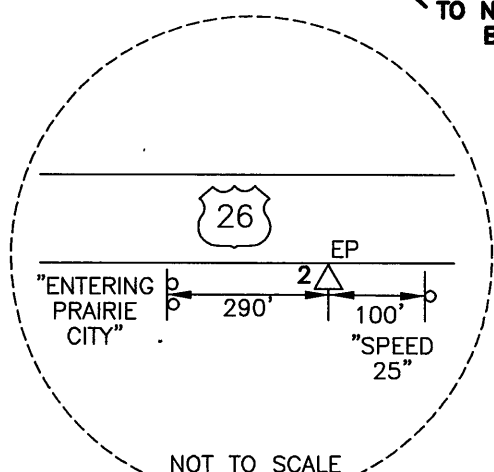


CONTROL POINT #2
SET 5/8" IRON ROD WITH 2"
ALUMINUM CAP STAMPED "OTAK INC., 2",
ALONG EDGE OF PAVEMENT

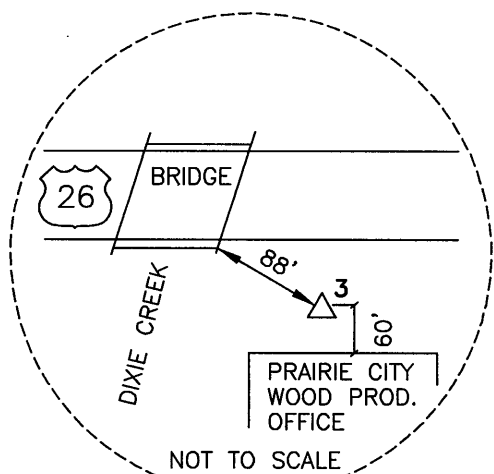


CONTROL POINT #3
SET 5/8" IRON ROD WITH 2"
ALUMINUM CAP STAMPED "OTAK INC., 3",
IN ASPHALT PARKING AREA

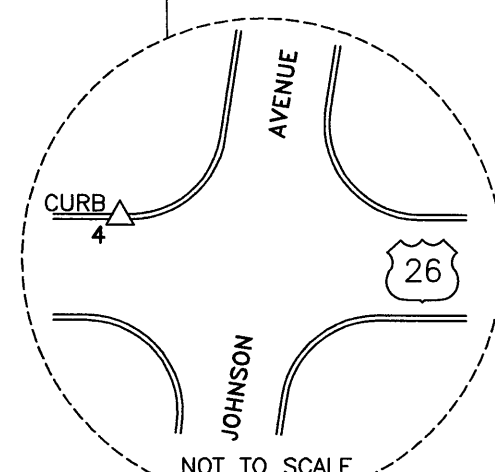


CONTROL POINT #4
SET PK NAIL WITH 1-1/2" BRASS WASHER
STAMPED "OTAK CONTROL, 4" IN CURB

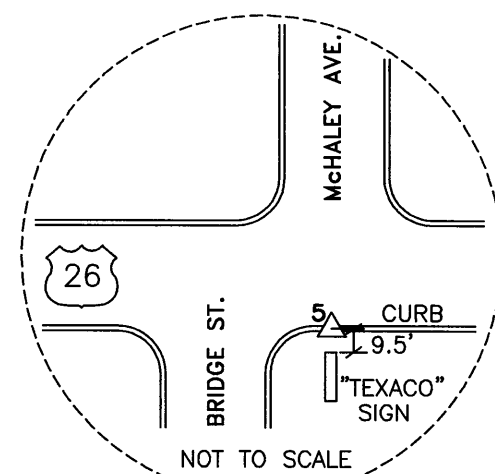


CONTROL POINT #5
SET PK NAIL WITH 1-1/2" BRASS WASHER
STAMPED "OTAK CONTROL, 5" IN CURB

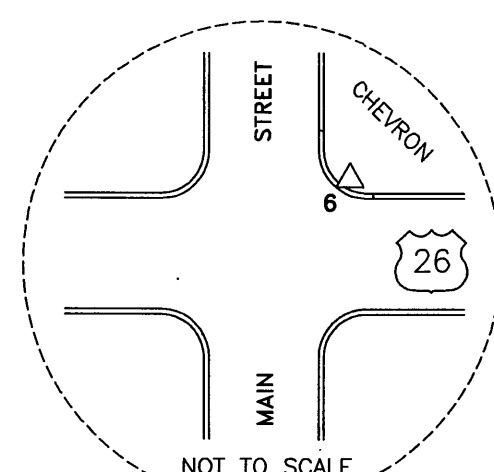


CONTROL POINT #6
SET PK NAIL WITH 1-1/2" BRASS WASHER
STAMPED "OTAK CONTROL, 6" IN
CURB RAMP

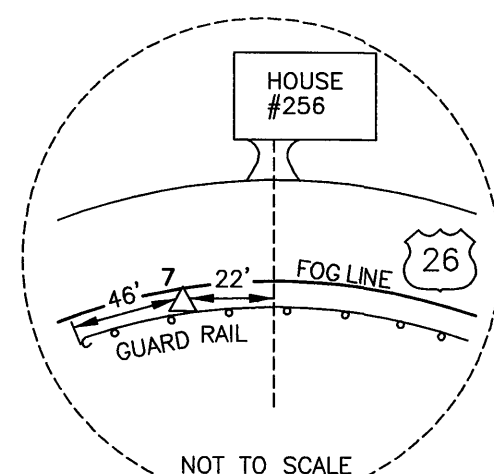


CONTROL POINT #7
SET 5/8" IRON ROD WITH 2"
ALUMINUM CAP STAMPED "OTAK INC., 7",
IN ASPHALT SHOULDER, 2.6' FROM
FACE OF GUARD RAIL

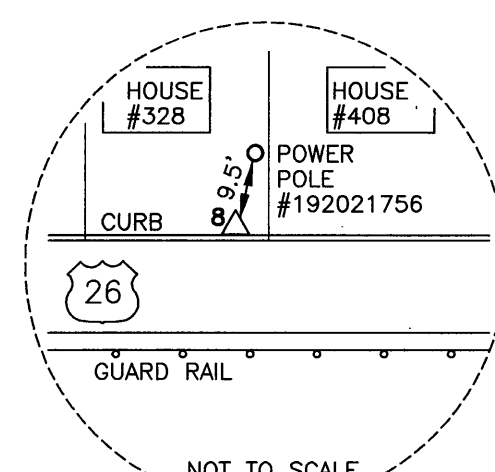


CONTROL POINT #8
SET 5/8" IRON ROD WITH 2"
ALUMINUM CAP STAMPED "OTAK INC., 8"

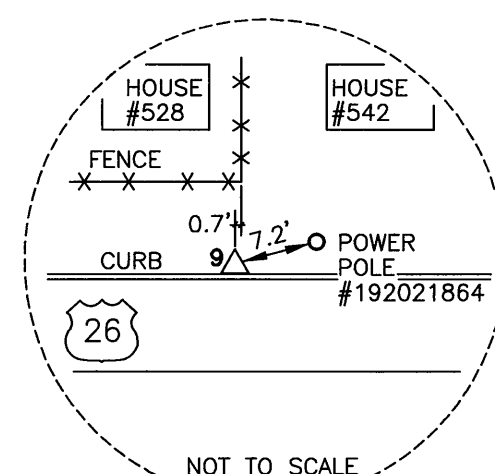

CONTROL POINT #9
SET 5/8" IRON ROD WITH 2"
ALUMINUM CAP STAMPED "OTAK INC., 9",
0.4' NORTH OF BACK OF CURB

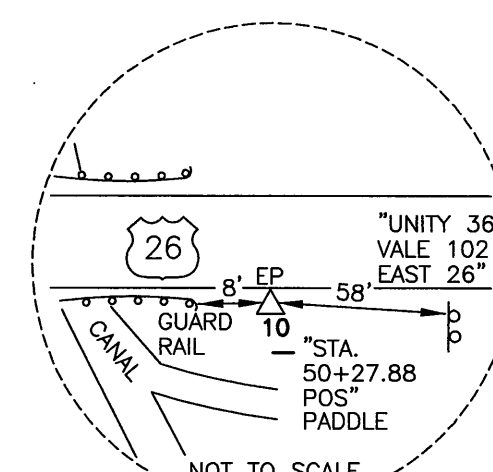

CONTROL POINT #10
SET 5/8" IRON ROD WITH 2"
ALUMINUM CAP STAMPED "OTAK INC., 10"

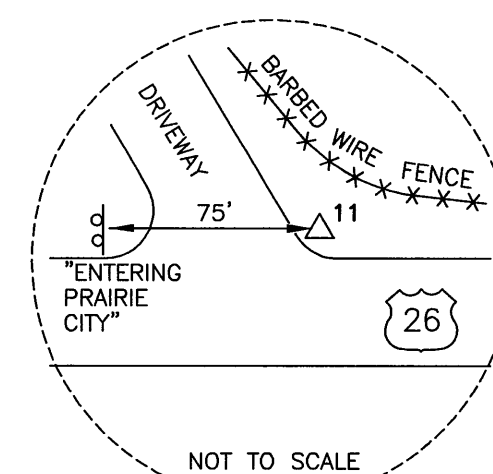

CONTROL POINT #11
SET 5/8" IRON ROD WITH 2"
ALUMINUM CAP STAMPED "OTAK INC., 11",
4' OFF EDGE OF PAVEMENT

SEE SHEET 5

HORIZONTAL CONTROL NETWORK SURVEY

PRAIRIE CITY - DIXIE SUMMIT SECTION

JOHN DAY HIGHWAY
- SW 1/4 SEC. 28, T.11S., R.34E.
- NE 1/4 SEC. 33, T.11S., R.35E.
- SW 1/4 SEC. 16, NW, SW 1/4 SEC. 21, NW 1/4 SEC. 28, NE, SE 1/4 SEC. 29,
SE 1/4 SEC. 31, NE, NW, SW 1/4 SEC. 32, T.12 S., R.34E.
- SE, SW 1/4 SEC. 1, SE, SW 1/4 SEC. 2, NE 1/4 SEC. 10, SW 1/4 SEC. 11,
NE 1/4 SEC. 12, NE 1/4 SEC. 14, T.13S., R.33E.
- NE, SE, SW 1/4 SEC. 6, NW 1/4 SEC. 7, T.13S., R.34E.

FOR: OREGON DEPARTMENT OF TRANSPORTATION REGION 5

8/1999
Field Date
JAC 8/1999
Calculations
MEM 11/1999
Drawn
JAC 11/1999
Checked By Date

REGISTERED
PROFESSIONAL
LAND SURVEYOR

John A. Carlson
OREGON
JULY 15, 1983
JOHN A. CARLSON
2044
RENEWS 12-31-1999

otak
Incorporated

17355 SW Boones Ferry Rd.
Lake Oswego, Oregon 97035
Phone: (503) 635-3618
FAX: (503) 635-5395

09356-004-004

Project No.

S356S004

File No.

4 OF 12

Sheet No.