


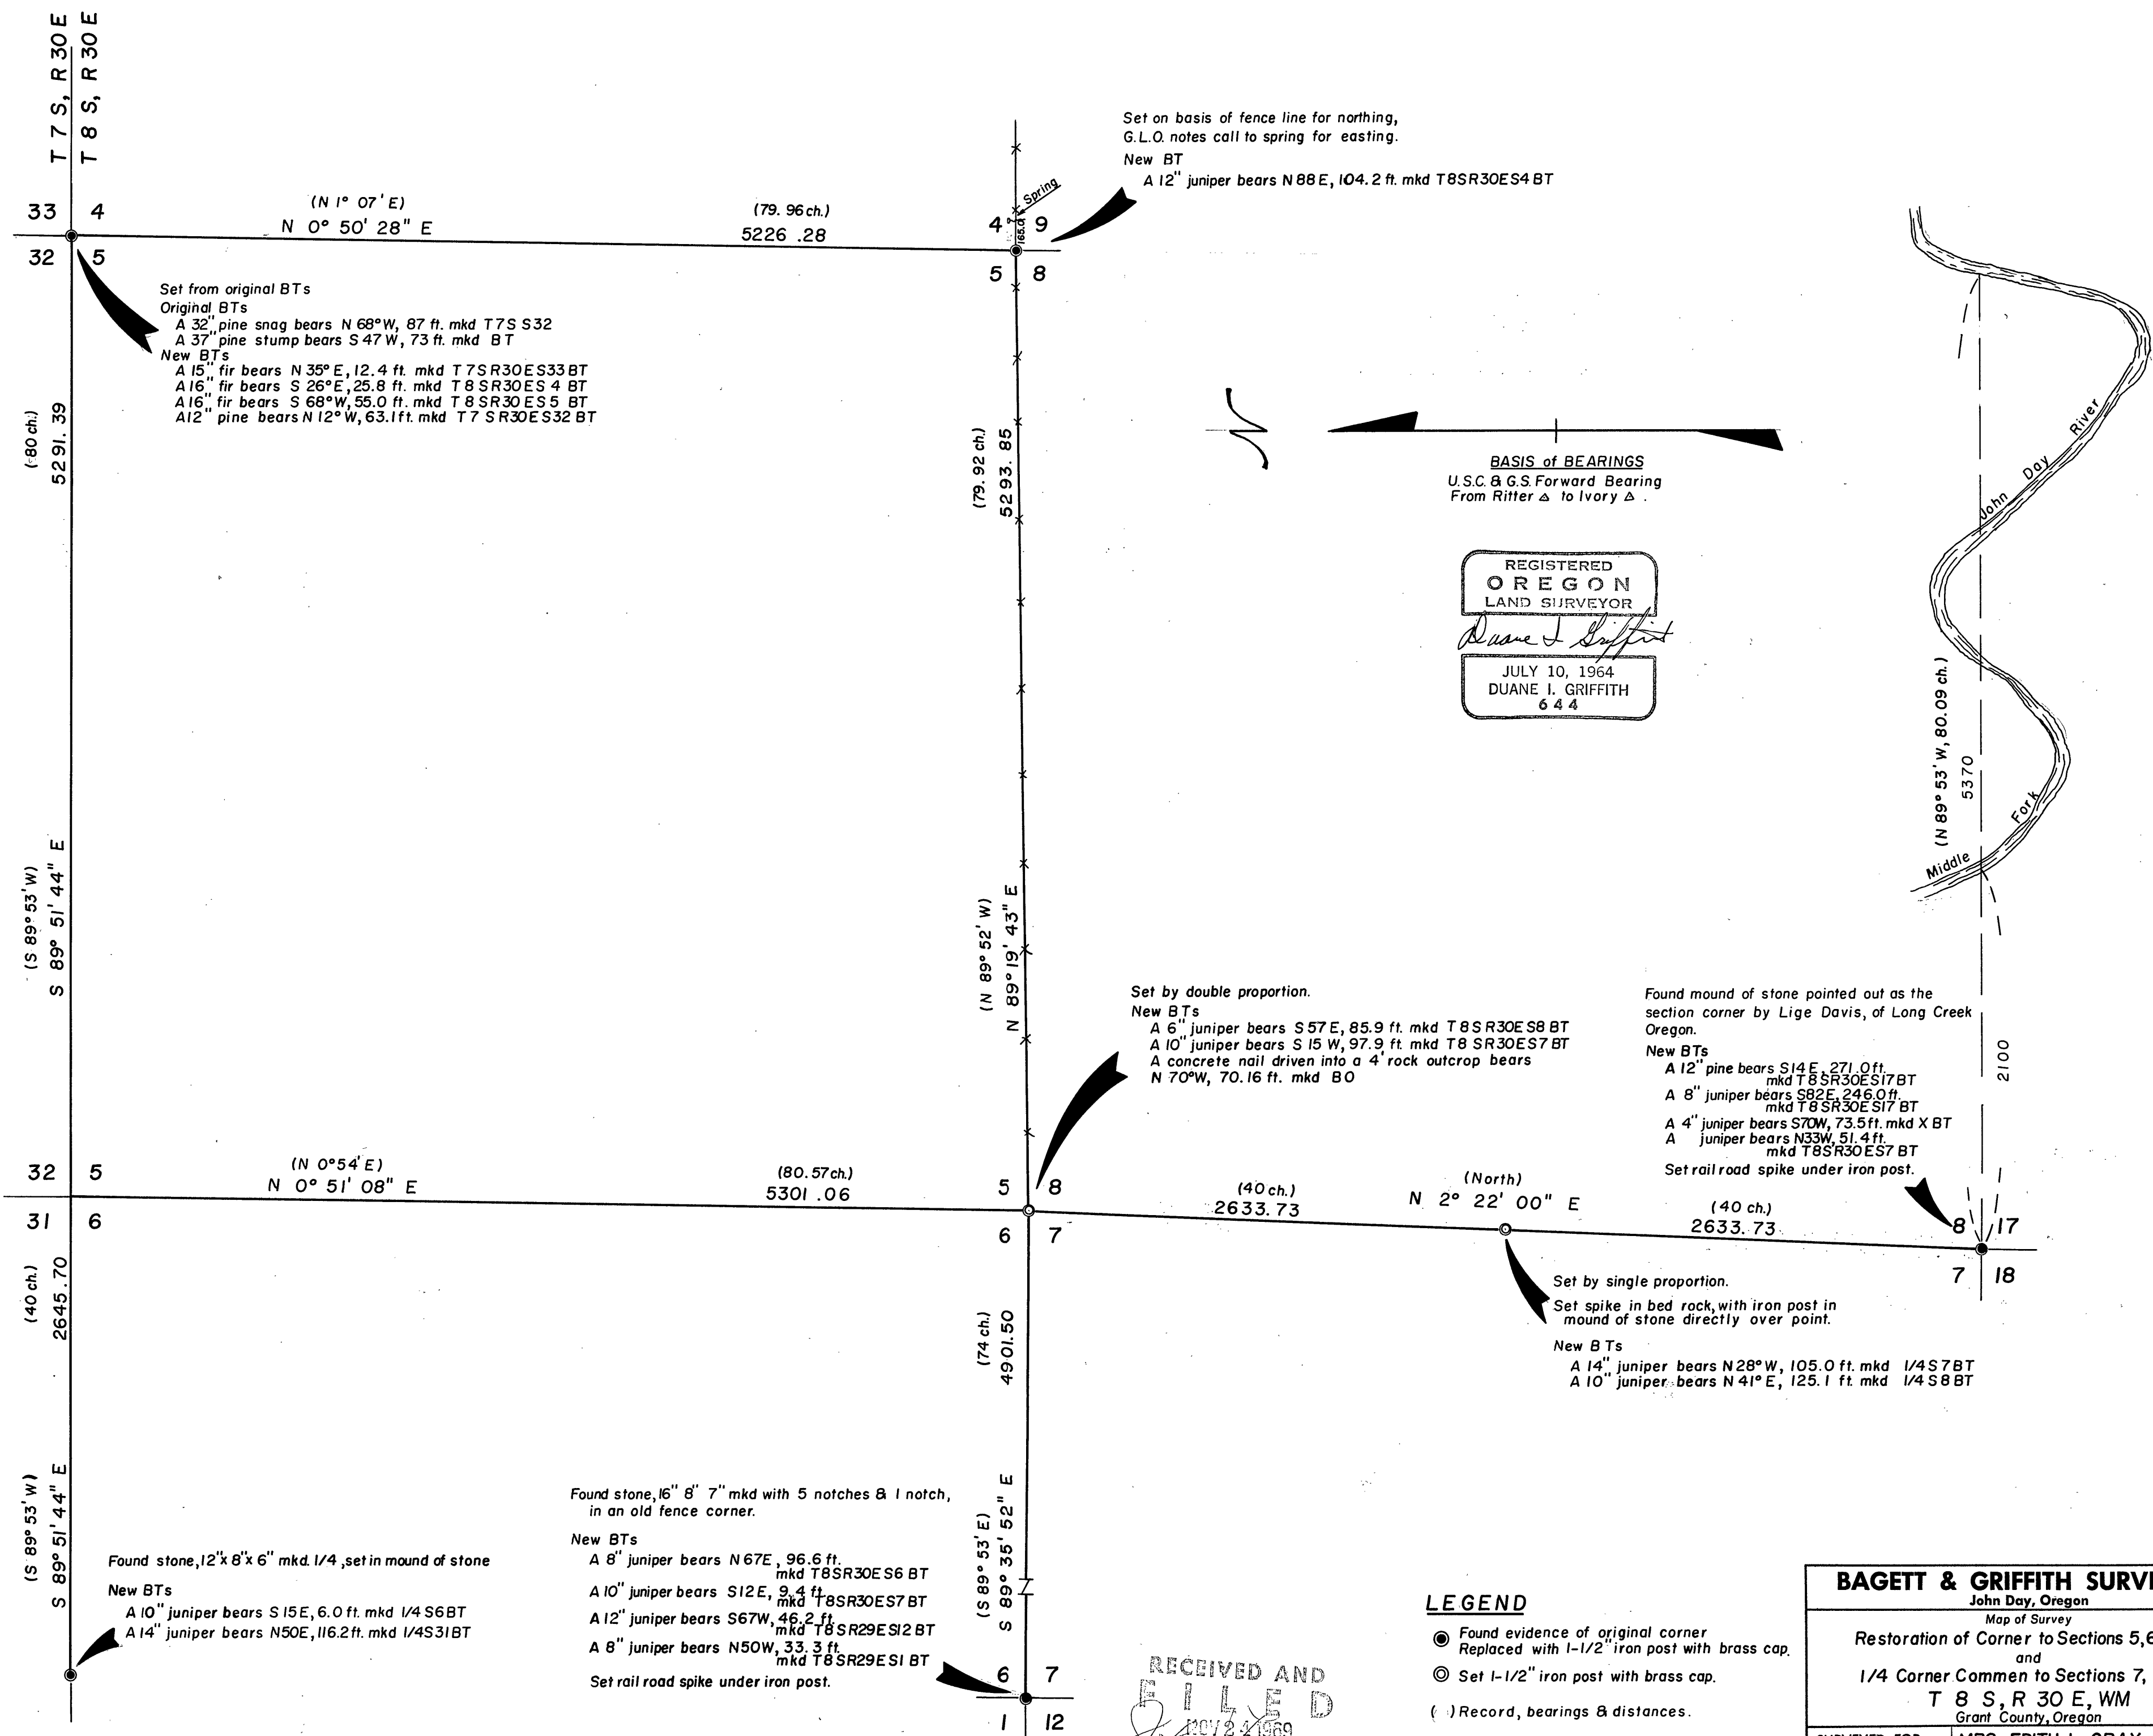

REGISTERED
OREGON
LAND SURVEYOR
Duane J. Griffith
JULY 10, 1964
DUANE J. GRIFFITH
644

BAGETT & GRIFFITH SURVEYING		
John Day, Oregon		
Map of Survey		
Restoration of Corner to Sections 5, 6, 7, 8,		
and		
1/4 Corner Common to Sections 7, & 8.		
T 8 S, R 30 E, WM		
Grant County, Oregon		
SURVEYED FOR	MRS. EDITH L. GRAY	
SURVEYED BY	D.I.G.	10/1/69
Scale: 1" = 600'	Drawn by: D.I.G.	10/1/69