


# BASIS OF BEARINGS

SOLAR OBSERVATION  
Taken at the C1/4 corner of Section 1

# LEGEND

- Found 5/8" iron pin with attached 1 1/2" aluminum cap. See Survey No. 1368
- Set 5/8"x30" iron pin with attached red plastic cap marked CORNERSTONE SURVEYING, INC.
- X—X Fence Line

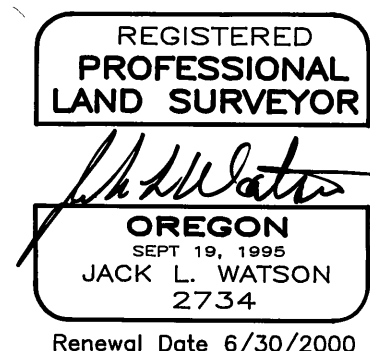

**CORNERSTONE SURVEYING, Inc.**  
233 S. Canyon Blvd., John Day, Oregon 97845  
(541) 575-1813

<b>MAP OF SURVEY</b> <b>PROPOSED PROPERTY LINE ADJUSTMENT</b> <b>SITUATED IN GOV'T LOT 7, SECTION 31</b> <b>T8S, R28E, W.M.</b> GRANT COUNTY, OREGON	
SURVEYED FOR:	<b>CITY OF MONUMENT</b>
SURVEYED BY :	Jack Watson
DATE:	February 24, 2000
DRAWN BY :	Jack Watson

MAP OF SURVEY No. 1546

# NARRATIVE:

This survey was performed at the request of the City of Monument. The purpose of this survey was to survey and monument the property line adjustment as shown.

After searching the available records pertaining to this survey, I found that the W1/4 corner of Section 31 was monumented by the Grant County Surveyor. County Road No. 4 was surveyed and monumented in 1995, see Map of Survey No. 1368, recorded in the office of the Grant County Surveyor. The location of the proposed adjusted property line was agreed to by Mr. Maynard and the City of Monument. No attempt was made to subdivide this section and the lines of the Gov't Lots are shown in their approximate locations.

RECEIVED AND  
FILED

MAR 6, 2000  
OFFICE OF COUNTY SURVEYOR  
JACK L. WATSON