


TOWNSHIP 14 SOUTH, RANGE 29 EAST, OF THE WILLAMETTE MERIDIAN, OREGON

SHEET 1 OF 2

DEPENDENT RESURVEY

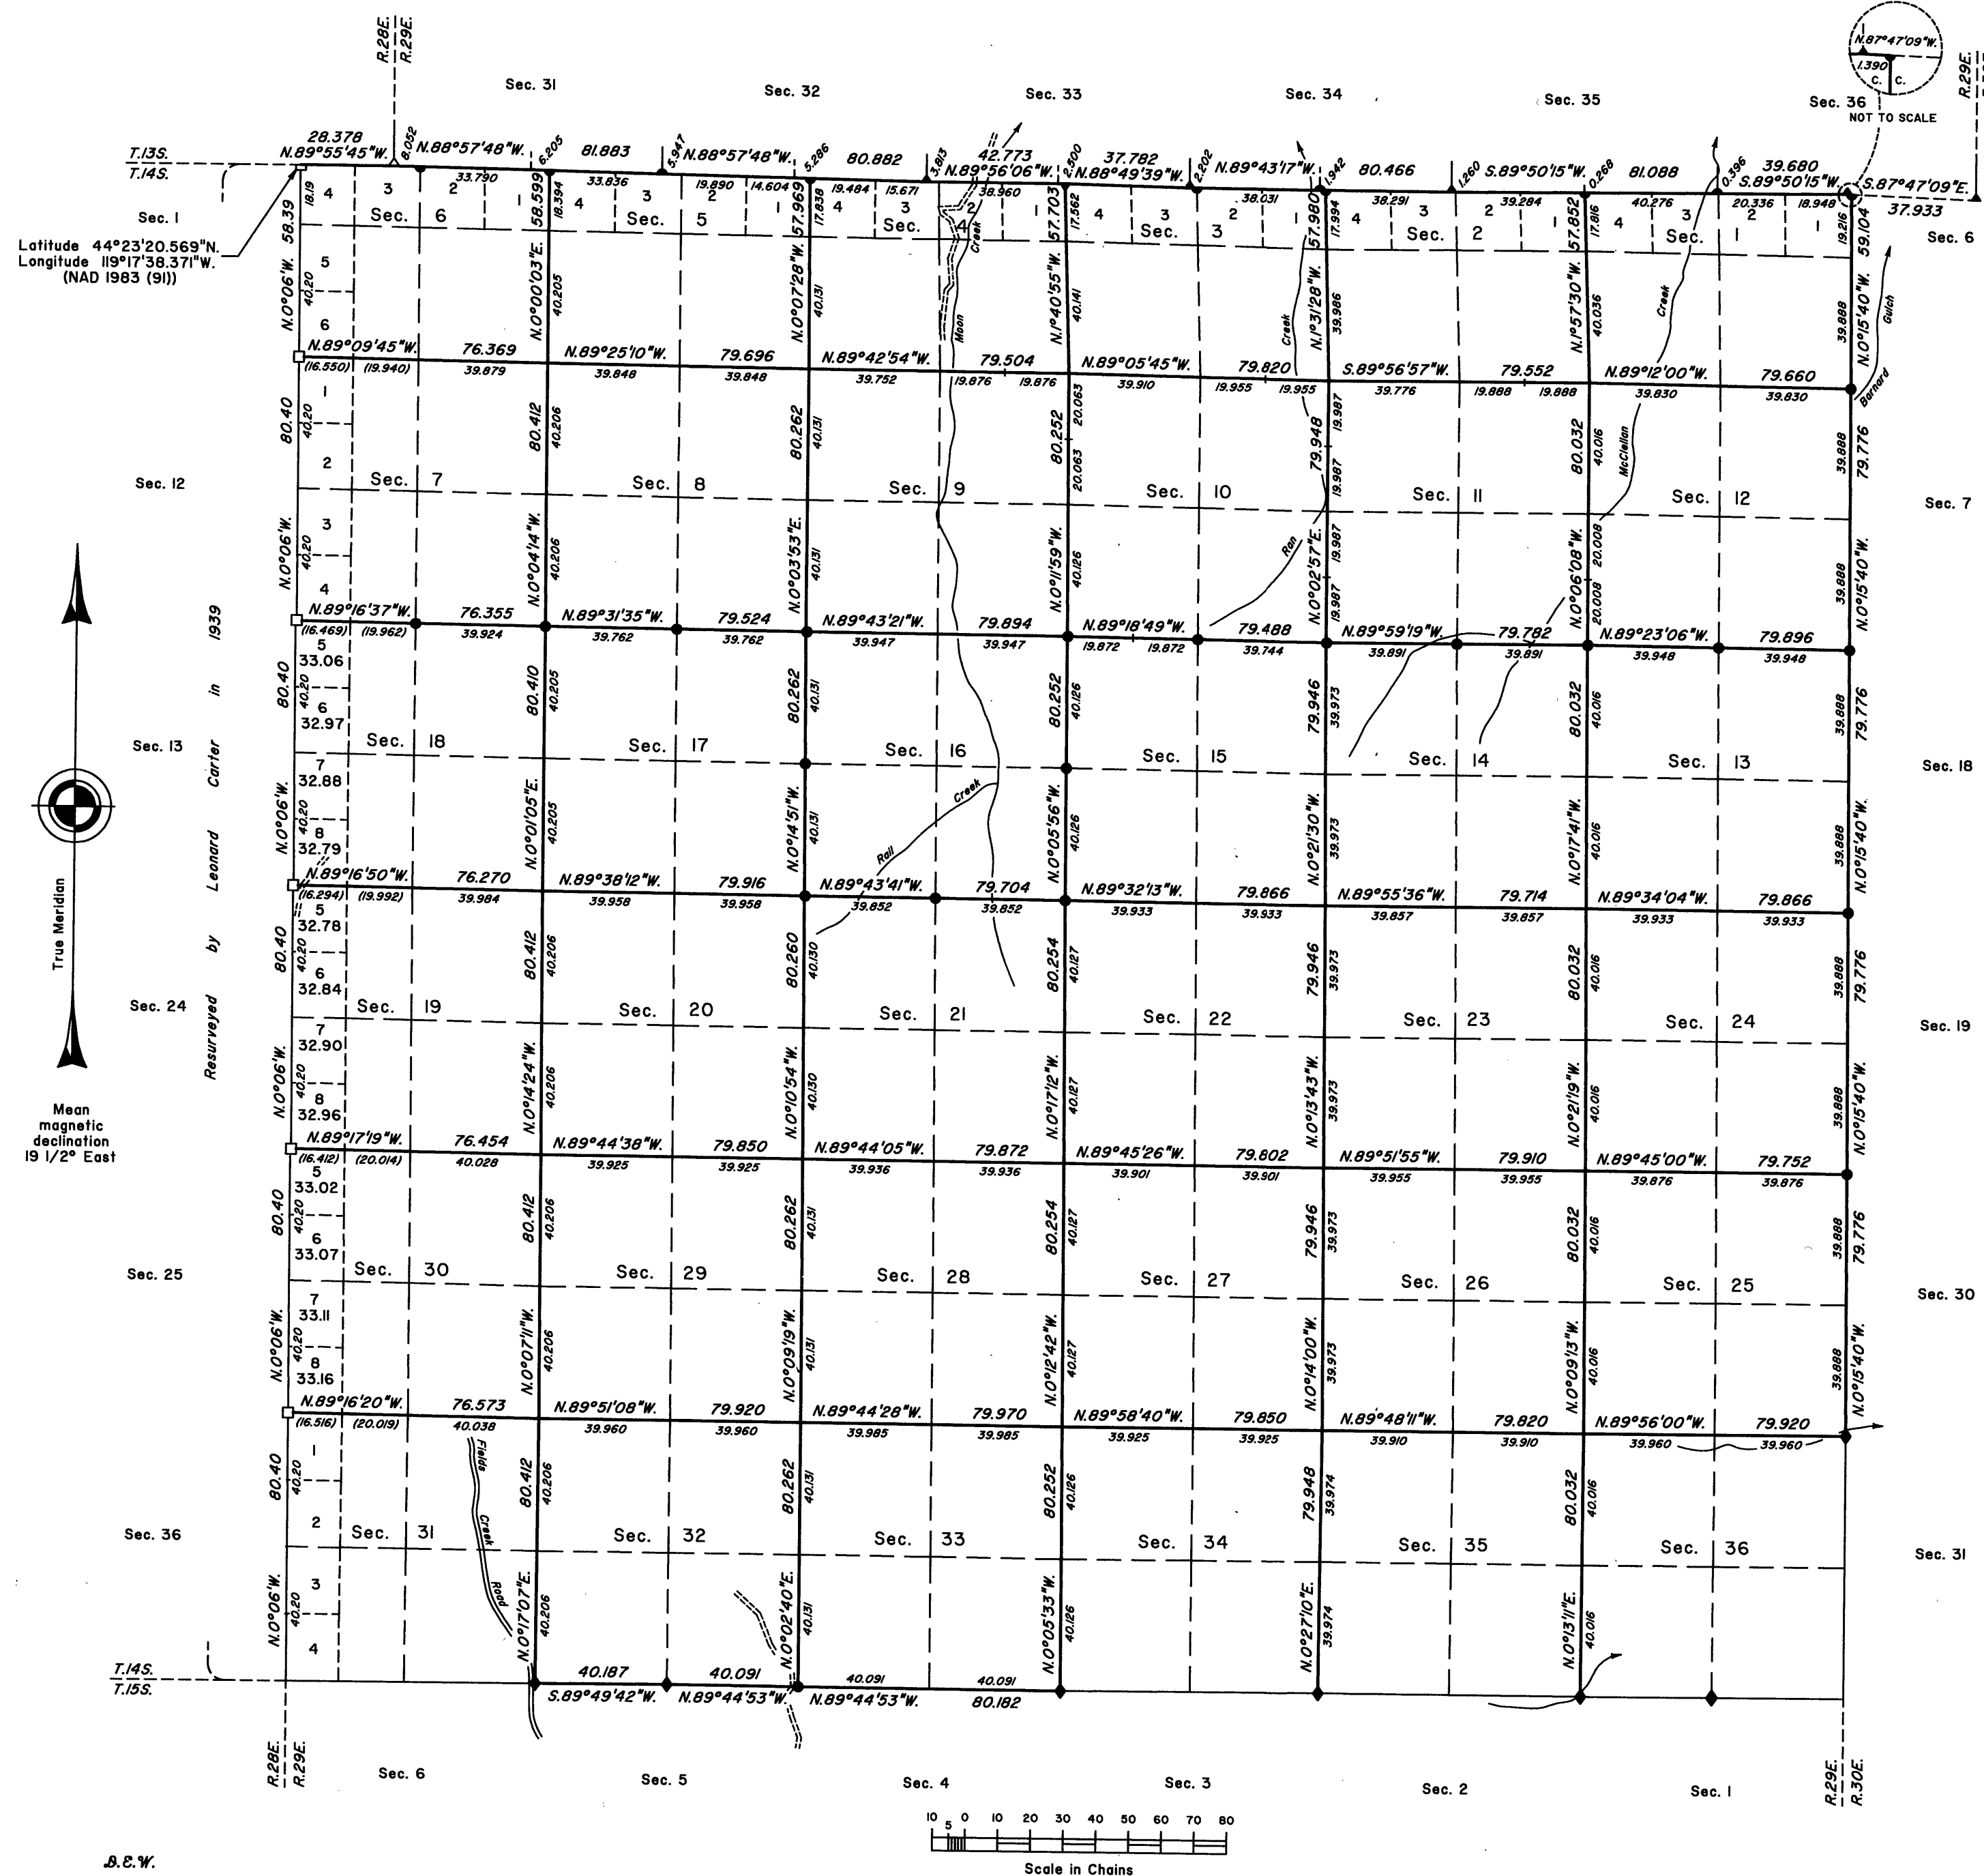

A history of surveys is contained in the field notes.

This plat represents a dependent resurvey of a portion of the south and east boundaries, the north boundary, and the subdivisional lines, T. 14 S., R. 29 E., Willamette Meridian, Oregon, designed to restore the corners in their true original locations according to the best available evidence.

Measured distances and directions have been adjusted by Cadastral Measurement Management (CMM), computer software that incorporates a least squares adjustment routine. The adjusted bearings and distances are reported to the nearest second and 0.01 foot.

Except as shown hereon, the lottings and areas are as shown on the plat approved May 21, 1885.

The survey was executed by Daniel E. Weller and James L. Carter, Cadastral Surveyors, beginning August 12, 1996, and completed August 7, 1997, pursuant to Special Instructions dated July 23, 1996, under Group Number 1813, Oregon.

Timber in this area consists of fir, pine, tamarack, hemlock, juniper, and cottonwood.

At the request of the U.S. Forest Service, the true area for each quarter-quarter section is reported for all lands under their jurisdiction. Where the true area is within 5% of the record area, the quarter-quarter section will retain its aliquot part designation even though the area changes. The quarter-quarter section will continue to be divided by legal subdivision. Where the record area changes by more than 5% or the quarter-quarter section is badly distorted, it has been assigned a lot number and may be further divided only by supplemental plat.

NOTE:

The true areas for each quarter-quarter section, divided by legal subdivision are located on Sheet 2 of 2.

LEGEND

- Original corner previously remonumented
- Original corner remonumented this survey
- Corner previously established or reestablished
- Corner established or reestablished this survey

UNITED STATES DEPARTMENT OF THE INTERIOR
BUREAU OF LAND MANAGEMENT

Portland, Oregon

January 12, 2000

This plat is strictly conformable to the approved field notes, and the survey, having been correctly executed in accordance with the requirements of law and the regulations of this Bureau, is hereby accepted.

For the Director

Wayne M. Hansen

Chief Cadastral Surveyor of Oregon