

TOWNSHIP 14 SOUTH, RANGE 29 EAST, OF THE WILLAMETTE MERIDIAN, OREGON

SHEET 2 OF 2

DEPENDENT RESURVEY

LEGAL SUBDIVISION	OFFICIAL AREA
SECTION 13	
NE 1/4 NE 1/4	39.85 Acres
SE 1/4 NE 1/4	39.84 Acres
SW 1/4 NE 1/4	39.88 Acres
NW 1/4 NE 1/4	39.88 Acres
NE 1/4 SE 1/4	39.84 Acres
SE 1/4 SE 1/4	39.83 Acres
SW 1/4 SE 1/4	39.87 Acres
NW 1/4 SE 1/4	39.87 Acres
NE 1/4 SW 1/4	39.90 Acres
SE 1/4 SW 1/4	39.90 Acres
SW 1/4 SW 1/4	39.93 Acres
NW 1/4 SW 1/4	39.93 Acres
NE 1/4 NW 1/4	39.91 Acres
SE 1/4 NW 1/4	39.91 Acres
SW 1/4 NW 1/4	39.94 Acres
NW 1/4 NW 1/4	39.94 Acres

LEGAL SUBDIVISION	OFFICIAL AREA
SECTION 14	
NE 1/4 NE 1/4	39.90 Acres
SE 1/4 NE 1/4	39.89 Acres
SW 1/4 NE 1/4	39.88 Acres
NW 1/4 NE 1/4	39.89 Acres
NE 1/4 SE 1/4	39.88 Acres
SE 1/4 SE 1/4	39.87 Acres
SW 1/4 SE 1/4	39.86 Acres
NW 1/4 SE 1/4	39.87 Acres
NE 1/4 SW 1/4	39.86 Acres
SE 1/4 SW 1/4	39.85 Acres
SW 1/4 SW 1/4	39.84 Acres
NW 1/4 SW 1/4	39.85 Acres
NE 1/4 NW 1/4	39.88 Acres
SE 1/4 NW 1/4	39.87 Acres
SW 1/4 NW 1/4	39.86 Acres
NW 1/4 NW 1/4	39.87 Acres

LEGAL SUBDIVISION	OFFICIAL AREA
SECTION 15	
NE 1/4 NE 1/4	39.76 Acres
SE 1/4 NE 1/4	39.80 Acres
SW 1/4 NE 1/4	39.84 Acres
NW 1/4 NE 1/4	39.79 Acres
NE 1/4 SE 1/4	39.85 Acres
SE 1/4 SE 1/4	39.90 Acres
SW 1/4 SE 1/4	39.93 Acres
NW 1/4 SE 1/4	39.89 Acres
NE 1/4 SW 1/4	39.93 Acres
SE 1/4 SW 1/4	39.97 Acres
SW 1/4 SW 1/4	40.01 Acres
NW 1/4 SW 1/4	39.97 Acres
NE 1/4 NW 1/4	39.83 Acres
SE 1/4 NW 1/4	39.88 Acres
SW 1/4 NW 1/4	39.92 Acres
NW 1/4 NW 1/4	39.87 Acres

LEGAL SUBDIVISION	OFFICIAL AREA
SECTION 17	
NE 1/4 NE 1/4	39.93 Acres
SE 1/4 NE 1/4	39.97 Acres
SW 1/4 NE 1/4	39.99 Acres
NW 1/4 NE 1/4	39.94 Acres
NE 1/4 SE 1/4	40.02 Acres
SE 1/4 SE 1/4	40.07 Acres
SW 1/4 SE 1/4	40.09 Acres
NW 1/4 SE 1/4	40.04 Acres
NE 1/4 SW 1/4	40.06 Acres
SE 1/4 SW 1/4	40.11 Acres
SW 1/4 SW 1/4	40.13 Acres
NW 1/4 SW 1/4	40.08 Acres
NE 1/4 NW 1/4	39.96 Acres
SE 1/4 NW 1/4	40.01 Acres
SW 1/4 NW 1/4	40.03 Acres
NW 1/4 NW 1/4	39.98 Acres

LEGAL SUBDIVISION	OFFICIAL AREA
SECTION 18	
NE 1/4 NE 1/4	40.14 Acres
SE 1/4 NE 1/4	40.15 Acres
SW 1/4 NE 1/4	40.15 Acres
NW 1/4 NE 1/4	40.14 Acres
NE 1/4 SE 1/4	40.16 Acres
SE 1/4 SE 1/4	40.17 Acres
SW 1/4 SE 1/4	40.17 Acres
NW 1/4 SE 1/4	40.16 Acres
NE 1/4 SW 1/4	40.16 Acres
SE 1/4 SW 1/4	40.17 Acres
NE 1/4 NW 1/4	40.14 Acres
SE 1/4 NW 1/4	40.15 Acres

LEGAL SUBDIVISION	OFFICIAL AREA
SECTION 19	
NE 1/4 NE 1/4	40.19 Acres
SE 1/4 NE 1/4	40.20 Acres
SW 1/4 NE 1/4	40.20 Acres
NW 1/4 NE 1/4	40.19 Acres
NE 1/4 SE 1/4	40.21 Acres
SE 1/4 SE 1/4	40.22 Acres
SW 1/4 SE 1/4	40.22 Acres
NW 1/4 SE 1/4	40.21 Acres
NE 1/4 SW 1/4	40.21 Acres
SE 1/4 SW 1/4	40.22 Acres
NE 1/4 NW 1/4	40.19 Acres
SE 1/4 NW 1/4	40.20 Acres

LEGAL SUBDIVISION	OFFICIAL AREA
SECTION 20	
NE 1/4 NE 1/4	40.09 Acres
SE 1/4 NE 1/4	40.08 Acres
SW 1/4 NE 1/4	40.10 Acres
NW 1/4 NE 1/4	40.11 Acres
NE 1/4 SE 1/4	40.07 Acres
SE 1/4 SE 1/4	40.07 Acres
SW 1/4 SE 1/4	40.09 Acres
NW 1/4 SE 1/4	40.09 Acres
NE 1/4 SW 1/4	40.11 Acres
SE 1/4 SW 1/4	40.10 Acres
SW 1/4 SW 1/4	40.12 Acres
NW 1/4 SW 1/4	40.13 Acres
NE 1/4 NW 1/4	40.13 Acres
SE 1/4 NW 1/4	40.12 Acres
SW 1/4 NW 1/4	40.14 Acres
NW 1/4 NW 1/4	40.15 Acres

LEGAL SUBDIVISION	OFFICIAL AREA
SECTION 21	
NE 1/4 NE 1/4	39.99 Acres
SE 1/4 NE 1/4	40.01 Acres
SW 1/4 NE 1/4	40.01 Acres
NW 1/4 NE 1/4	39.99 Acres
NE 1/4 SE 1/4	40.03 Acres
SE 1/4 SE 1/4	40.05 Acres
SW 1/4 SE 1/4	40.05 Acres
NW 1/4 SE 1/4	40.03 Acres
NE 1/4 SW 1/4	40.03 Acres
SE 1/4 SW 1/4	40.05 Acres
SW 1/4 SW 1/4	40.05 Acres
NW 1/4 SW 1/4	40.03 Acres
NE 1/4 NW 1/4	39.99 Acres
SE 1/4 NW 1/4	40.01 Acres
SW 1/4 NW 1/4	40.01 Acres
NW 1/4 NW 1/4	39.99 Acres

LEGAL SUBDIVISION	OFFICIAL AREA
SECTION 22	
NE 1/4 NE 1/4	39.92 Acres
SE 1/4 NE 1/4	39.91 Acres
SW 1/4 NE 1/4	39.95 Acres
NW 1/4 NE 1/4	39.96 Acres
NE 1/4 SE 1/4	39.90 Acres
SE 1/4 SE 1/4	39.89 Acres
SW 1/4 SE 1/4	39.93 Acres
NW 1/4 SE 1/4	39.94 Acres
NE 1/4 SW 1/4	39.98 Acres
SE 1/4 SW 1/4	39.97 Acres
SW 1/4 SW 1/4	40.01 Acres
NW 1/4 SW 1/4	40.02 Acres
NE 1/4 NW 1/4	40.00 Acres
SE 1/4 NW 1/4	39.99 Acres
SW 1/4 NW 1/4	40.03 Acres
NW 1/4 NW 1/4	40.04 Acres

LEGAL SUBDIVISION	OFFICIAL AREA
SECTION 23	
NE 1/4 NE 1/4	39.88 Acres
SE 1/4 NE 1/4	39.90 Acres
SW 1/4 NE 1/4	39.89 Acres
NW 1/4 NE 1/4	39.87 Acres
NE 1/4 SE 1/4	39.93 Acres
SE 1/4 SE 1/4	39.95 Acres
SW 1/4 SE 1/4	39.94 Acres
NW 1/4 SE 1/4	39.92 Acres
NE 1/4 SW 1/4	39.98 Acres
SE 1/4 SW 1/4	39.91 Acres
SW 1/4 SW 1/4	39.92 Acres
NW 1/4 SW 1/4	39.90 Acres
NE 1/4 NW 1/4	39.86 Acres
SE 1/4 NW 1/4	39.88 Acres
SW 1/4 NW 1/4	39.87 Acres
NW 1/4 NW 1/4	39.85 Acres

LEGAL SUBDIVISION	OFFICIAL AREA
SECTION 24	
NE 1/4 NE 1/4	39.83 Acres
SE 1/4 NE 1/4	39.82 Acres
SW 1/4 NE 1/4	39.85 Acres
NW 1/4 NE 1/4	39.86 Acres
NE 1/4 SE 1/4	39.79 Acres
SE 1/4 SE 1/4	39.78 Acres
SW 1/4 SE 1/4	39.82 Acres
NW 1/4 SE 1/4	39.82 Acres
NE 1/4 SW 1/4	39.86 Acres
SE 1/4 SW 1/4	39.85 Acres
SW 1/4 SW 1/4	39.89 Acres
NW 1/4 SW 1/4	39.89 Acres
NE 1/4 NW 1/4	39.89 Acres
SE 1/4 NW 1/4	39.88 Acres
SW 1/4 NW 1/4	39.91 Acres
NW 1/4 NW 1/4	39.92 Acres

LEGAL SUBDIVISION	OFFICIAL AREA
SECTION 25	
NE 1/4 NE 1/4	39.79 Acres
SE 1/4 NE 1/4	39.81 Acres
SW 1/4 NE 1/4	39.84 Acres
NW 1/4 NE 1/4	39.82 Acres
NE 1/4 SE 1/4	39.83 Acres
SE 1/4 SE 1/4	39.85 Acres
SW 1/4 SE 1/4	39.88 Acres
NW 1/4 SE 1/4	39.86 Acres
NE 1/4 SW 1/4	39.90 Acres
SE 1/4 SW 1/4	39.92 Acres
SW 1/4 SW 1/4	39.95 Acres
NW 1/4 SW 1/4	39.93 Acres
NE 1/4 NW 1/4	39.86 Acres
SE 1/4 NW 1/4	39.88 Acres
SW 1/4 NW 1/4	39.91 Acres
NW 1/4 NW 1/4	39.89 Acres

LEGAL SUBDIVISION	OFFICIAL AREA
SECTION 26	
NE 1/4 NE 1/4	39.96 Acres
SE 1/4 NE 1/4	39.95 Acres
SW 1/4 NE 1/4	39.94 Acres
NW 1/4 NE 1/4	39.95 Acres
NE 1/4 SE 1/4	39.94 Acres
SE 1/4 SE 1/4	39.92 Acres
SW 1/4 SE 1/4	39.91 Acres
NW 1/4 SE 1/4	39.93 Acres
NE 1/4 SW 1/4	39.91 Acres
SE 1/4 SW 1/4	39.90 Acres
SW 1/4 SW 1/4	39.89 Acres
NW 1/4 SW 1/4	39.90 Acres
NE 1/4 NW 1/4	39.94 Acres
SE 1/4 NW 1/4	39.93 Acres
SW 1/4 NW 1/4	39.92 Acres
NW 1/4 NW 1/4	39.93 Acres

LEGAL SUBDIVISION	OFFICIAL AREA
SECTION 27	
NE 1/4 NE 1/4	39.90 Acres
SE 1/4 NE 1/4	39.90 Acres
SW 1/4 NE 1/4	39.94 Acres
NW 1/4 NE 1/4	39.94 Acres
NE 1/4 SE 1/4	39.91 Acres
SE 1/4 SE 1/4	39.91 Acres
SW 1/4 SE 1/4	39.95 Acres
NW 1/4 SE 1/4	39.95 Acres
NE 1/4 SW 1/4	39.99 Acres
SE 1/4 SW 1/4	39.99 Acres
SW 1/4 SW 1/4	40.03 Acres
NW 1/4 SW 1/4	40.02 Acres
NE 1/4 NW 1/4	39.97 Acres
SE 1/4 NW 1/4	39.98 Acres
SW 1/4 NW 1/4	40.02 Acres
NW 1/4 NW 1/4	40.01 Acres

LEGAL SUBDIVISION	OFFICIAL AREA
SECTION 28	
NE 1/4 NE 1/4	40.07 Acres
SE 1/4 NE 1/4	40.08 Acres
SW 1/4 NE 1/4	40.08 Acres
NW 1/4 NE 1/4	40.07 Acres
NE 1/4 SE 1/4	40.09 Acres
SE 1/4 SE 1/4	40.10 Acres
SW 1/4 SE 1/4	40.10 Acres
NW 1/4 SE 1/4	40.09 Acres
NE 1/4 SW 1/4	40.10 Acres
SE 1/4 SW 1/4	40.10 Acres
SW 1/4 SW 1/4	40.11 Acres
NW 1/4 SW 1/4	40.10 Acres
NE 1/4 NW 1/4	40.07 Acres
SE 1/4 NW 1/4	40.08 Acres
SW 1/4 NW 1/4	40.09 Acres
NW 1/4 NW 1/4	40.07 Acres

LEGAL SUBDIVISION	OFFICIAL AREA
SECTION 29	
NE 1/4 NE 1/4	40.07 Acres
SE 1/4 NE 1/4	40.08 Acres
SW 1/4 NE 1/4	40.10 Acres
NW 1/4 NE 1/4	40.09 Acres
NE 1/4 SE 1/4	40.09 Acres
SE 1/4 SE 1/4	40.09 Acres
SW 1/4 SE 1/4	40.11 Acres
NW 1/4 SE 1/4	40.10 Acres
NE 1/4 SW 1/4	40.12 Acres
SE 1/4 SW 1/4	40.13 Acres
SW 1/4 SW 1/4	40.15 Acres
NW 1/4 SW 1/4	40.14 Acres
NE 1/4 NW 1/4	40.11 Acres
SE 1/4 NW 1/4	40.12 Acres
SW 1/4 NW 1/4	40.14 Acres
NW 1/4 NW 1/4	40.13 Acres

LEGAL SUBDIVISION	OFFICIAL AREA
SECTION 30	
NE 1/4 NE 1/4	40.24 Acres
SE 1/4 NE 1/4	40.24 Acres
SW 1/4 NE 1/4	40.24 Acres
NW 1/4 NE 1/4	40.24 Acres
NE 1/4 SE 1/4	40.23 Acres
SE 1/4 SE 1/4	40.23 Acres
SW 1/4 SE 1/4	40.23 Acres
NW 1/4 SE 1/4	40.23 Acres
NE 1/4 SW 1/4	40.23 Acres
SE 1/4 SW 1/4	40.23 Acres
NE 1/4 NW 1/4	40.24 Acres
SE 1/4 NW 1/4	40.23 Acres

LEGAL SUBDIVISION	OFFICIAL AREA
SECTION 32	
NE 1/4 NE 1/4	40.12 Acres
SE 1/4 NE 1/4	40.15 Acres
SW 1/4 NE 1/4	40.17 Acres
NW 1/4 NE 1/4	40.14 Acres
NE 1/4 SE 1/4	40.15 Acres
SE 1/4 SE 1/4	40.18 Acres
SW 1/4 SE 1/4	40.12 Acres
NW 1/4 SE 1/4	40.09 Acres
NE 1/4 SW 1/4	40.17 Acres
SE 1/4 SW 1/4	40.22 Acres
SW 1/4 SW 1/4	40.32 Acres
NW 1/4 SW 1/4	40.26 Acres
NE 1/4 NW 1/4	40.17 Acres
SE 1/4 NW 1/4	40.22 Acres
SW 1/4 NW 1/4	40.24 Acres
NW 1/4 NW 1/4	40.19 Acres

LEGAL SUBDIVISION	OFFICIAL AREA
SECTION 33	
NE 1/4 NE 1/4	40.13 Acres
SE 1/4 NE 1/4	40.15 Acres
SW 1/4 NE 1/4	40.15 Acres
NW 1/4 NE 1/4	40.13 Acres
NE 1/4 SE 1/4	40.18 Acres
SE 1/4 SE 1/4	40.20 Acres
SW 1/4 SE 1/4	40.20 Acres
NW 1/4 SE 1/4	40.18 Acres
NE 1/4 SW 1/4	40.18 Acres
SE 1/4 SW 1/4	40.21 Acres
SW 1/4 SW 1/4	40.21 Acres
NW 1/4 SW 1/4	40.18 Acres
NE 1/4 NW 1/4	40.13 Acres
SE 1/4 NW 1/4	40.15 Acres
SW 1/4 NW 1/4	40.15 Acres
NW 1/4 NW 1/4	40.13 Acres


UNITED STATES DEPARTMENT OF THE INTERIOR
BUREAU OF LAND MANAGEMENT

Portland, Oregon


January 12, 2000

This plat is strictly conformable to the approved field notes, and the survey, having been correctly executed in accordance with the requirements of law and the regulations of this Bureau, is hereby accepted.

For the Director

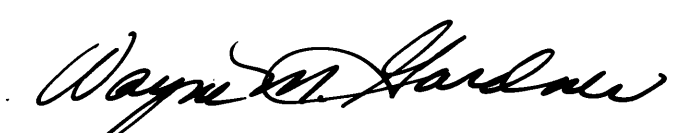
Chief Cadastral Surveyor of OregonRECEIVED AND
FILED

MAR. 31, 2000

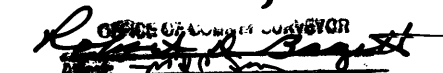

R.F.B.

MAP OF SURVEY NO. 1549