
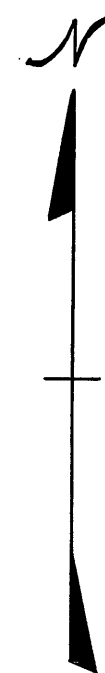


New BT's

A 12" juniper bears S56° E, 127.5 ft., mkd T13SR29ES20BT
 A 16" juniper bears N45° E, 119.3 ft., mkd T13SR29ESI7BT
 A 10" juniper bears N26° W, 45.1 ft., mkd T13SR29ESI8BT
 A 12" juniper bears S20° W, 75.3 ft., mkd T13SR29ESI9BT

New BT's

A 14" juniper bears S39° E, 124.3 ft., mkd T13SR29ES21BT
 A 14" juniper bears N63° E, 171.5 ft., mkd T13SR29ESI6BT
 A 3" juniper bears S15° W, 25.4 ft., mkd X BT

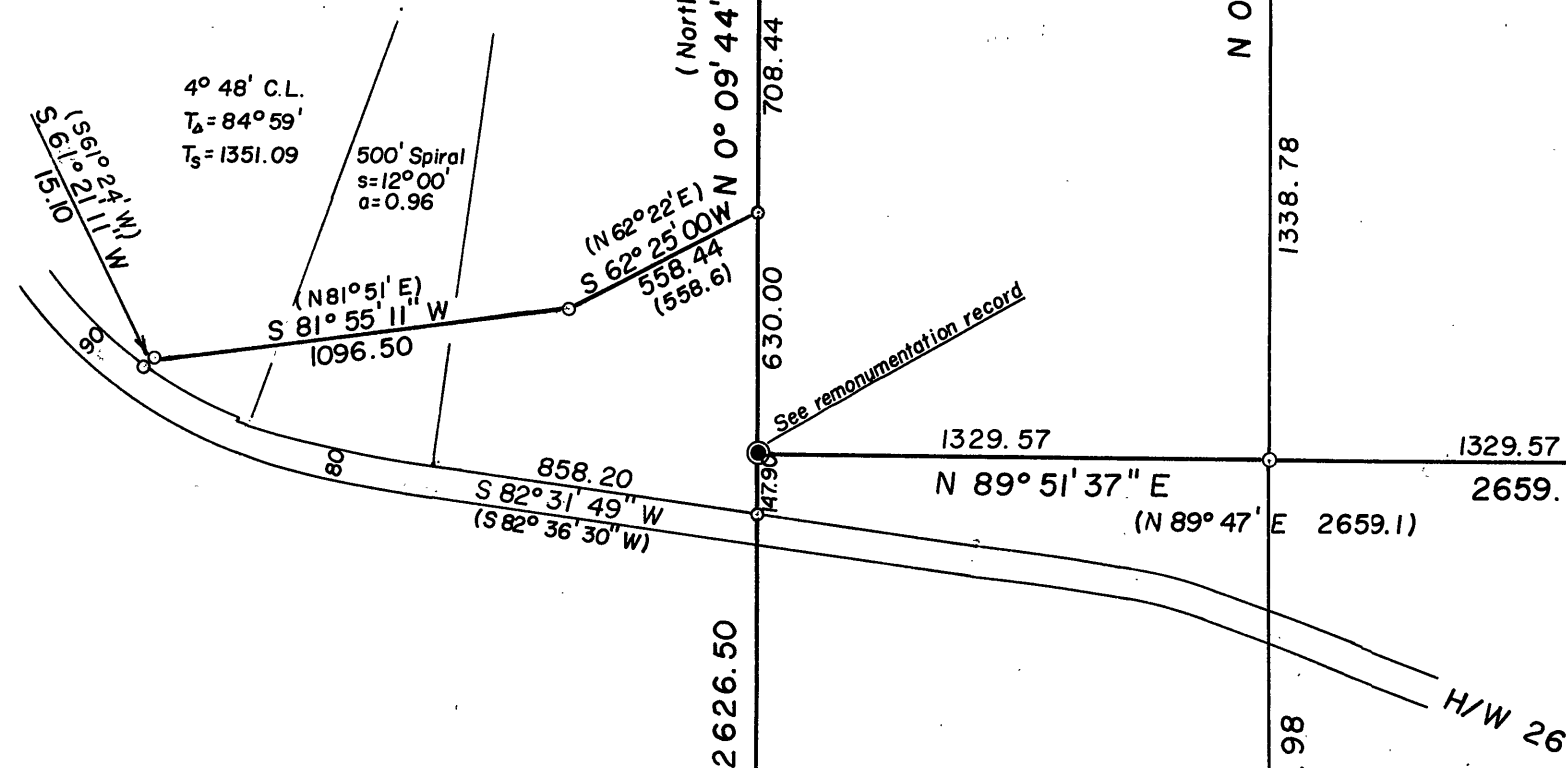

Basis of Bearings
 Solar Observations

REFERENCE MATERIAL

Ore. St. H/W Drg. no. 7B-20-5
 G.L.O. Notes
 Surveyors record book I, p.88
 Deed vol. 68 page 81
 " " 68 " 274
 " " 88 " 359

RECEIVED AND
 FILED
 JUL 12 1969
 JOHN LIVEIRA, County Clerk
 By _____ Deputy.

REGISTERED
 OREGON
 LAND SURVEYOR

JULY 10, 1964
 DUANE I. GRIFFITH
 644

LEGEND

- Fd. cor. evidence, remonumented with 1 1/2" x 30" iron pipe with brass cap.
- Set 5/8" x 30" iron pin.
- () Record bearings & dist.

BAGETT & GRIFFITH SURVEYING

John Day, Oregon

Portions of Sections 19 & 20

T 13 S. R. 29 E. W.M.

Grant County, Oregon

SURVEYED FOR	JOHN KALITA	
SURVEYED BY	D.I.G. & R.D.B.	8 - 1969
Scale: 1" = 500'	Drawn by: D.I.G.	9 - 1969

Survey # 156