

Scale 1"=100'

BASIS OF BEARINGS RECORD SURVEY NO. 1387

LEGEND

- Found monument of record as shown.
- Found 5/8" iron pin, see Survey No. 441.
- Set 5/8"x30" iron pin with attached red plastic cap marked CORNERSTONE SURVEYING, INC.
- X—X Fence Line
- () Record bearing and distance.


NARRATIVE

This survey was performed at the request of Jim Hammett. The purpose of this survey was to locate the east boundary of Mr. Hammett's property as described in Deed Instrument No. 941479.

After searching the available records pertaining to this survey, I found Survey No. 441 and Survey No. 1387. The section line is Mr. Hammett's easterly property line. I found and accepted the monuments at the E1/4 corner and the NE corner of Section 26. I located the existing centerline of the county road and set the NE corner of Mr. Hammett's property on the section line and 30 feet from the existing road center line.

RECEIVED AND
FILED

SEP 22 2000
OFFICE OF COUNTY SURVEYOR
Grant County, Oregon

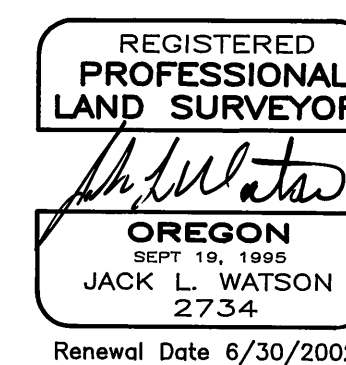

CORNERSTONE SURVEYING, Inc.
233 S. Canyon Blvd., John Day, Oregon 97845
(541) 575-1813

MAP OF SURVEY SITUATED IN THE NE1/4 SECTION 26 T13S, R30E, W.M. GRANT COUNTY, OREGON	
SURVEYED FOR:	Jim Hammett
SURVEYED BY :	Jack Watson
DATE:	9/04/2000
DRAWN BY :	Jack Watson

MAP OF SURVEY NO. 1574