


Pt. No.	Northing	Easting	Description
37	310742.16	8691321.07	DTAK INC CAP
38	311756.57	8691613.51	DTAK INC CAP
39	312697.91	8691532.82	DTAK INC CAP
200	311099.35	8690900.43	ALUM. CAPPED MONUMENT

Pt. No.	Northing	Easting	Description
37	310742.16	8691321.07	DTAK INC CAP
38	311756.57	8691613.51	DTAK INC CAP
39	312697.91	8691532.82	DTAK INC CAP
200	311099.35	8690900.43	ALUM. CAPPED MONUMENT


Pt. No.	Northing	Easting	Description
40	313572.77	8691541.94	DTAK INC CAP
41	314726.37	8691945.37	DTAK INC CAP
42	315594.11	8692048.65	DTAK INC CAP

REGISTERED PROFESSIONAL LAND SURVEYOR
DOUGLAS M. FERGUSON
848
RENEWAL DATE: 12/31/01

REGISTERED PROFESSIONAL LAND SURVEYOR
KENNETH H. DELANO JR.
4965
RENEWAL DATE: 12/31/01

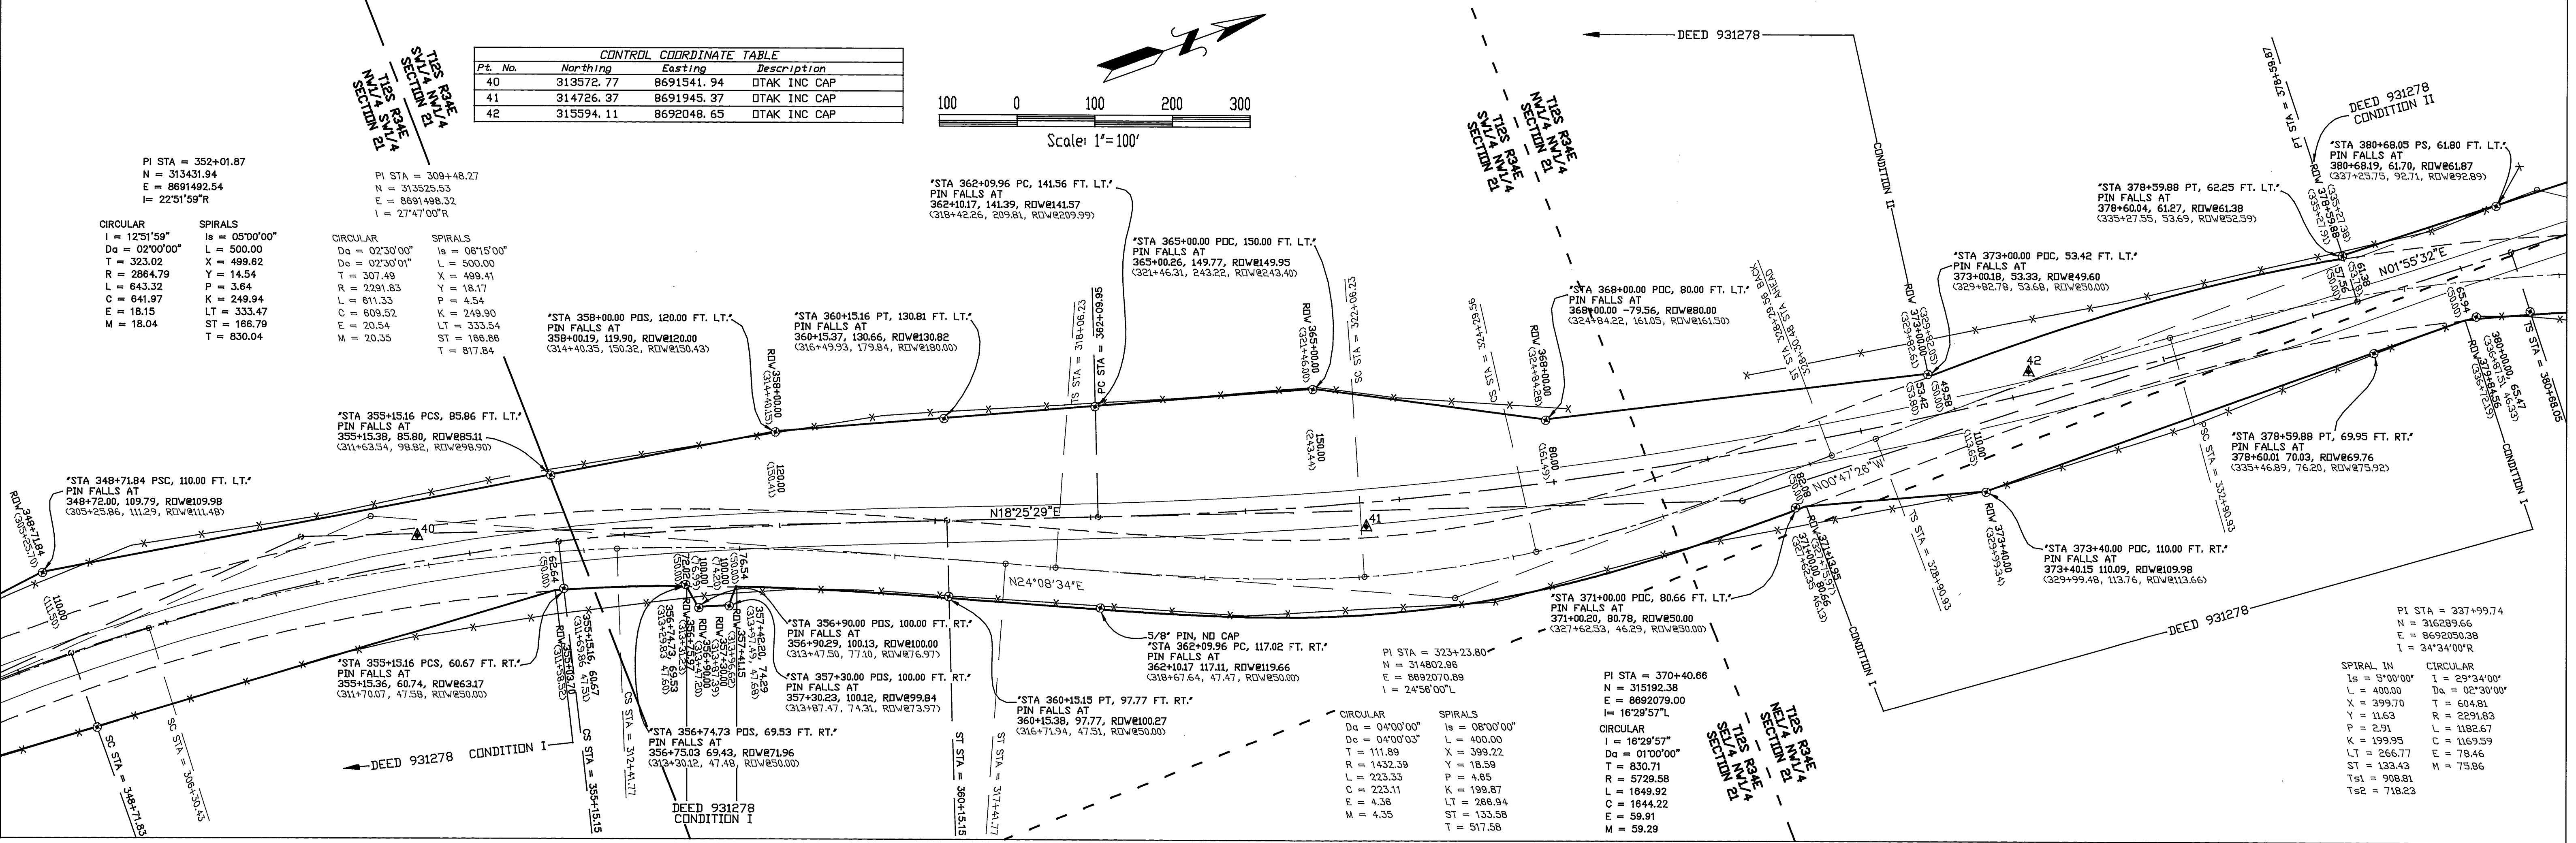

Pt. No.	Northing	Easting	Description
40	313572.77	8691541.94	DTAK INC CAP
41	314726.37	8691945.37	DTAK INC CAP
42	315594.11	8692048.65	DTAK INC CAP

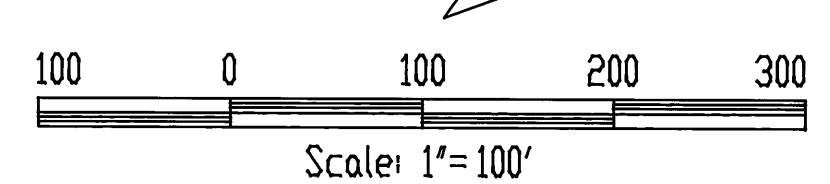

Pt. No.	Northing	Easting	Description
37	310742.16	8691321.07	DTAK INC CAP
38	311756.57	8691613.51	DTAK INC CAP
39	312697.91	8691532.82	DTAK INC CAP
200	311099.35	8690900.43	ALUM. CAPPED MONUMENT

Pt. No.	Northing	Easting	Description
37	310742.16	8691321.07	DTAK INC CAP
38	311756.57	8691613.51	DTAK INC CAP
39	312697.91	8691532.82	DTAK INC CAP
200	311099.35	8690900.43	ALUM. CAPPED MONUMENT

Pt. No.	Northing	Easting	Description
40	313572.77	8691541.94	DTAK INC CAP
41	314726.37	8691945.37	DTAK INC CAP
42	315594.11	8692048.65	DTAK INC CAP

REGISTERED PROFESSIONAL LAND SURVEYOR
DOUGLAS M. FERGUSON
848
RENEWAL DATE: 12/31/01

REGISTERED PROFESSIONAL LAND SURVEYOR
KENNETH H. DELANO JR.
4965
RENEWAL DATE: 12/31/01