


Scale 1"=200'

T13S R31E

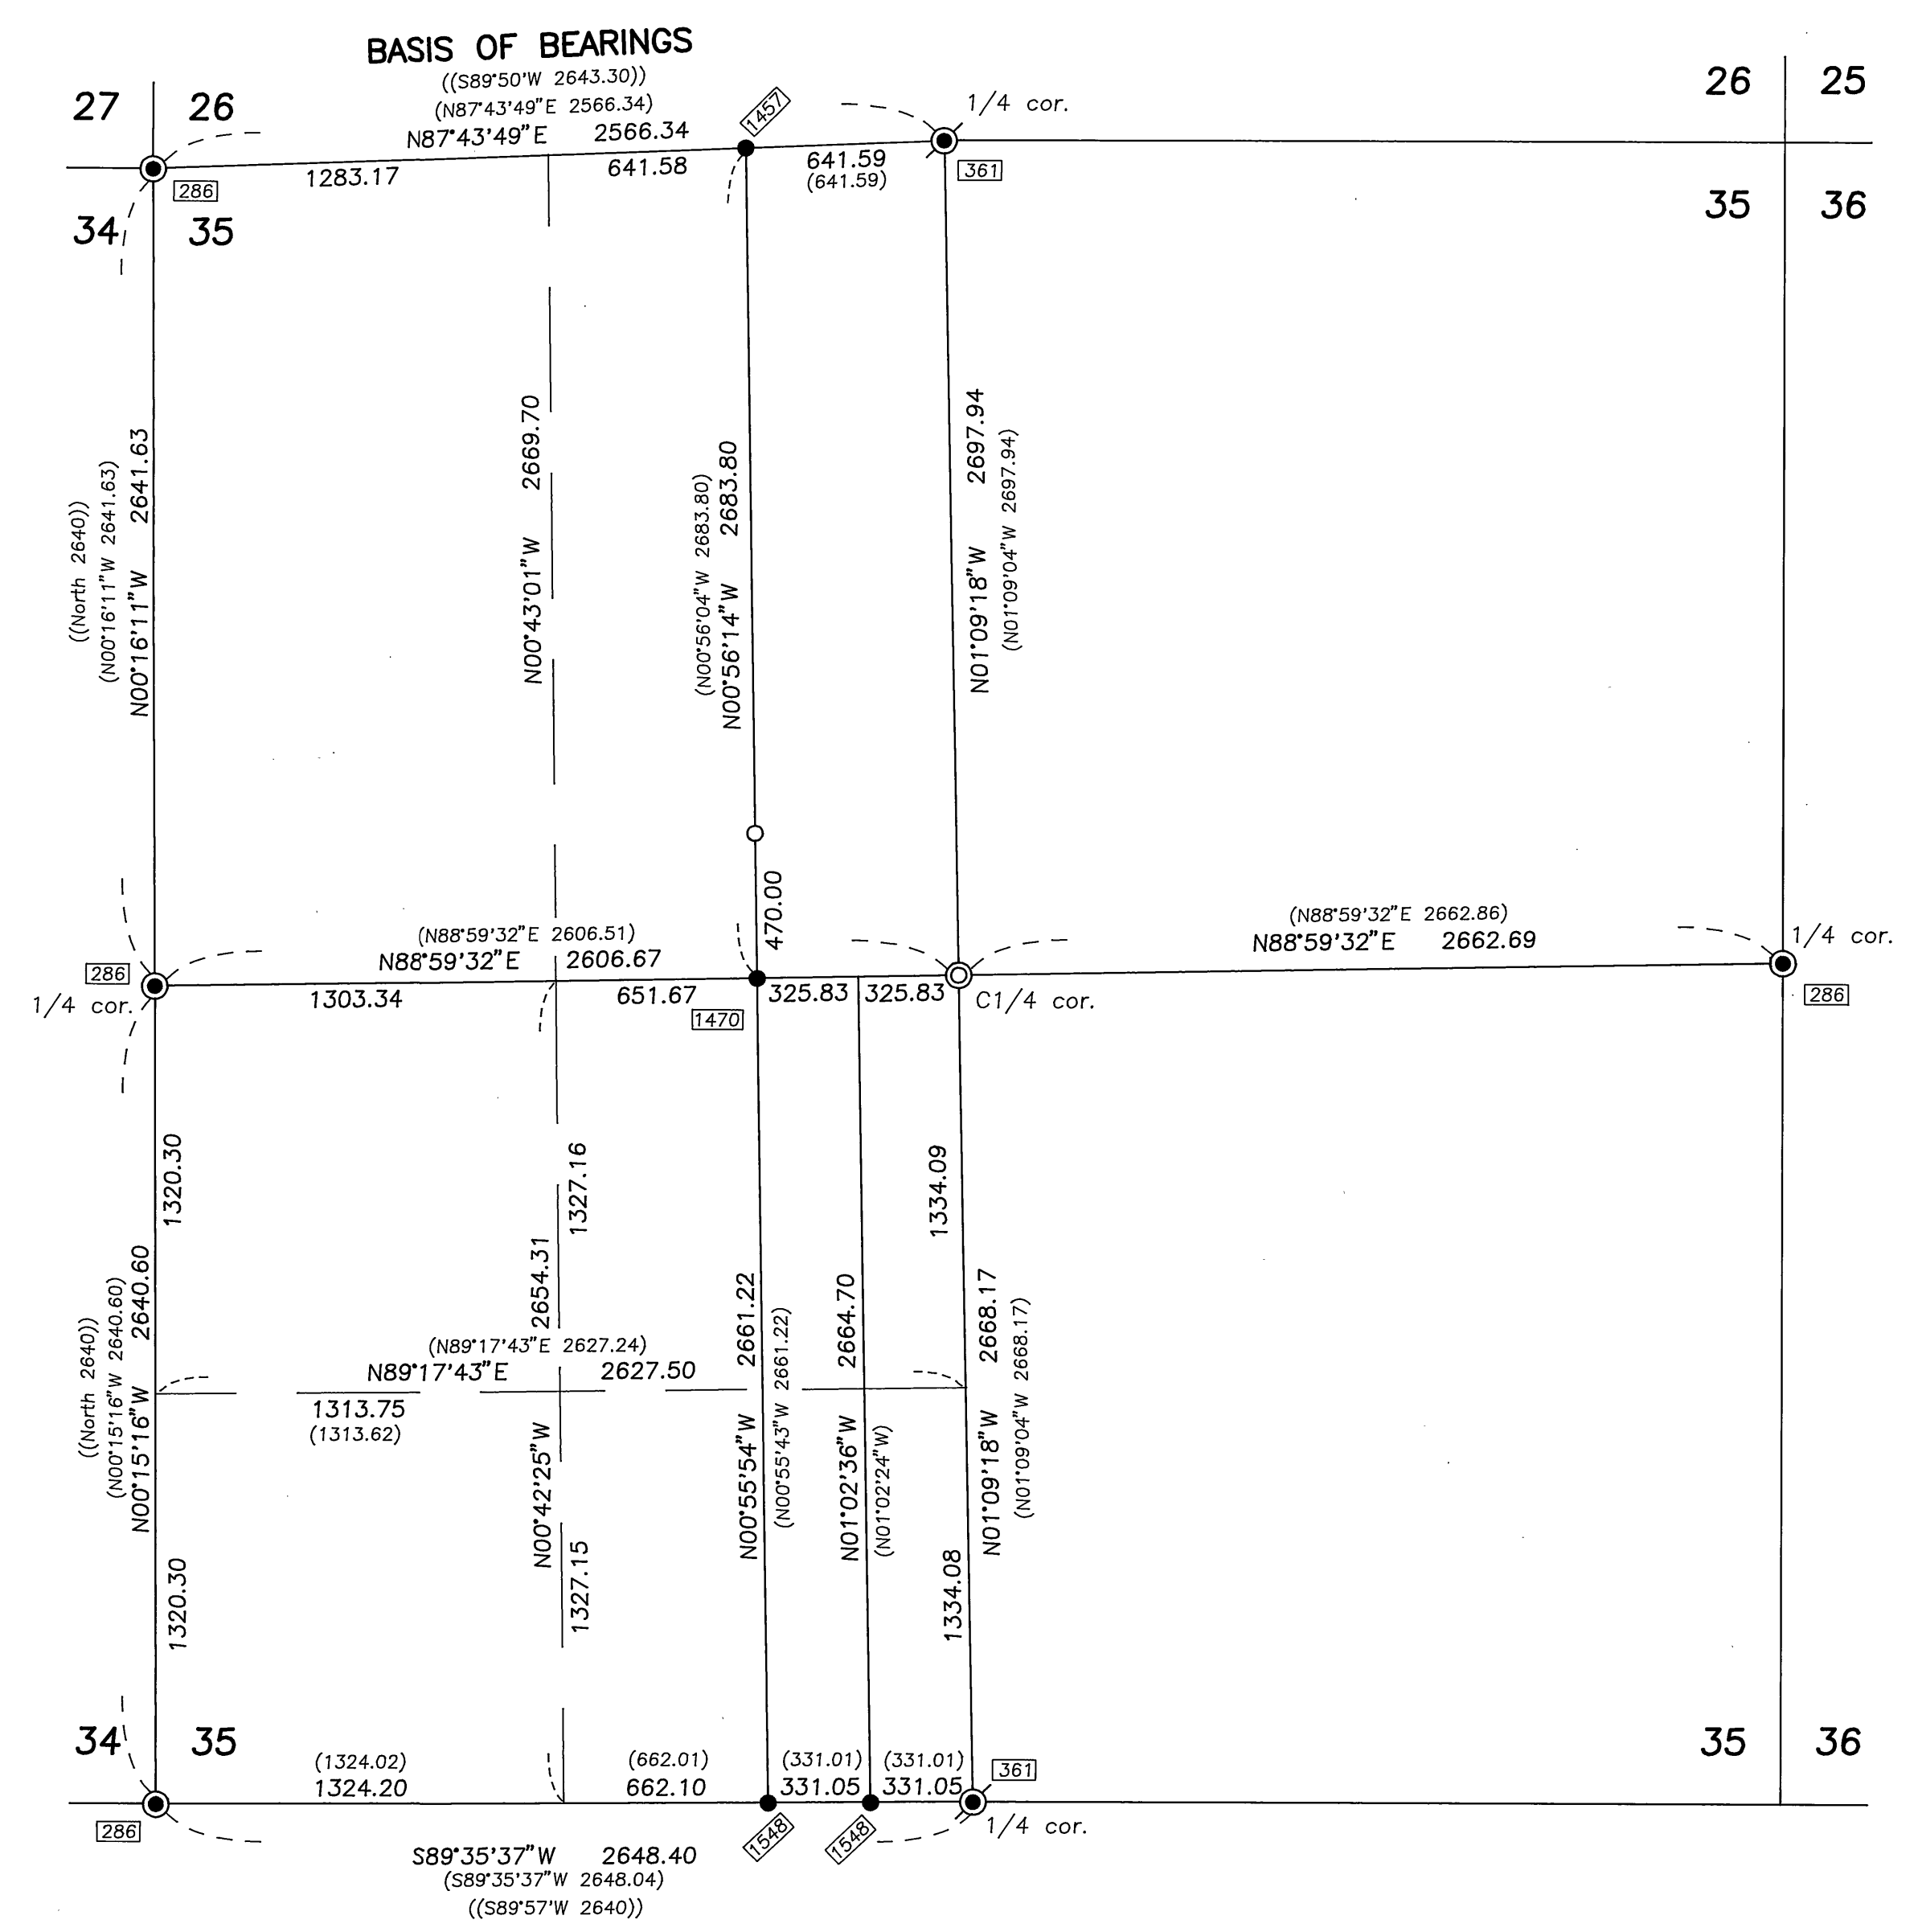

Scale 1"=500'

BASIS OF BEARINGS
Map of Survey No. 1470

LEGEND

- Found 3" iron pipe with attached 3" BLM brass cap.
- ⊙ Found 1 1/2" iron pipe with attached Grant County Surveyor brass cap.
- Found 5/8" iron pin with attached red plastic cap, marked CORNERSTONE SURVEYING, INC.
- Set 5/8"x30" iron pin with attached red plastic cap marked CORNERSTONE SURVEYING, INC.
- ⊙ Set 5/8"x 24" iron pin with attached 2" alum. cap. see corner restoration sheet for details.
- (()) GLO record bearing and distance.
- () Record bearing and distance.
- Found monument, see record map of survey number shown in box.

NARRATIVE

This survey was performed at the request of David Fields, acting on behalf of Canyon Mountain Heights, LLC. The purpose of this survey is to monument the boundaries of the property described in Deed Instrument No. 210501 and the boundary agreements and property adjustment lines described in Deed Instrument No.'s 210896 and 210897.

A search was made of the available records pertaining to this survey. The monuments of Survey No. 411 were recovered and found to be out of position by more than 3 feet, see the explanation in the narrative of Survey No. 1548. The adjoining property owners have agreed to accept the monuments and exchange deeds to create a new property line using the found monuments. They have also agreed to exchange property for their mutual benefit. The new property line has been monumented and shown. I found the appurtenant monuments from Survey No.'s 1470 and 1548. These monuments are in good condition and I accept them as shown.

REGISTERED
PROFESSIONAL
LAND SURVEYOR
Jack L. Watson
OREGON
SEPT. 19, 1995
JACK L. WATSON
2734
Renewal Date 6/30/2002

CORNERSTONE SURVEYING, Inc.
233 S. Canyon Blvd., John Day, Oregon
(541) 575-1813

MAP OF SURVEY
PARCEL 2 OF LAND PARTITION NO. 2000-9
SITUATED IN SECTION 35, T13S, R31E, W.M.
CITY OF CANYON CITY
GRANT COUNTY, OREGON

SURVEYED FOR: Canyon Mountain Heights, LLC
SURVEYED BY: Jack Watson Date: 3/21/2001
DRAWN BY: Jack Watson