


RECEIVED AND
FILED
NOV 19 1969
JOHN LIVEIRA, County Clerk
BY _____

- LEGEND
- Fd. monuments of record.
 - Set 5/8 x 30 in. iron pin.

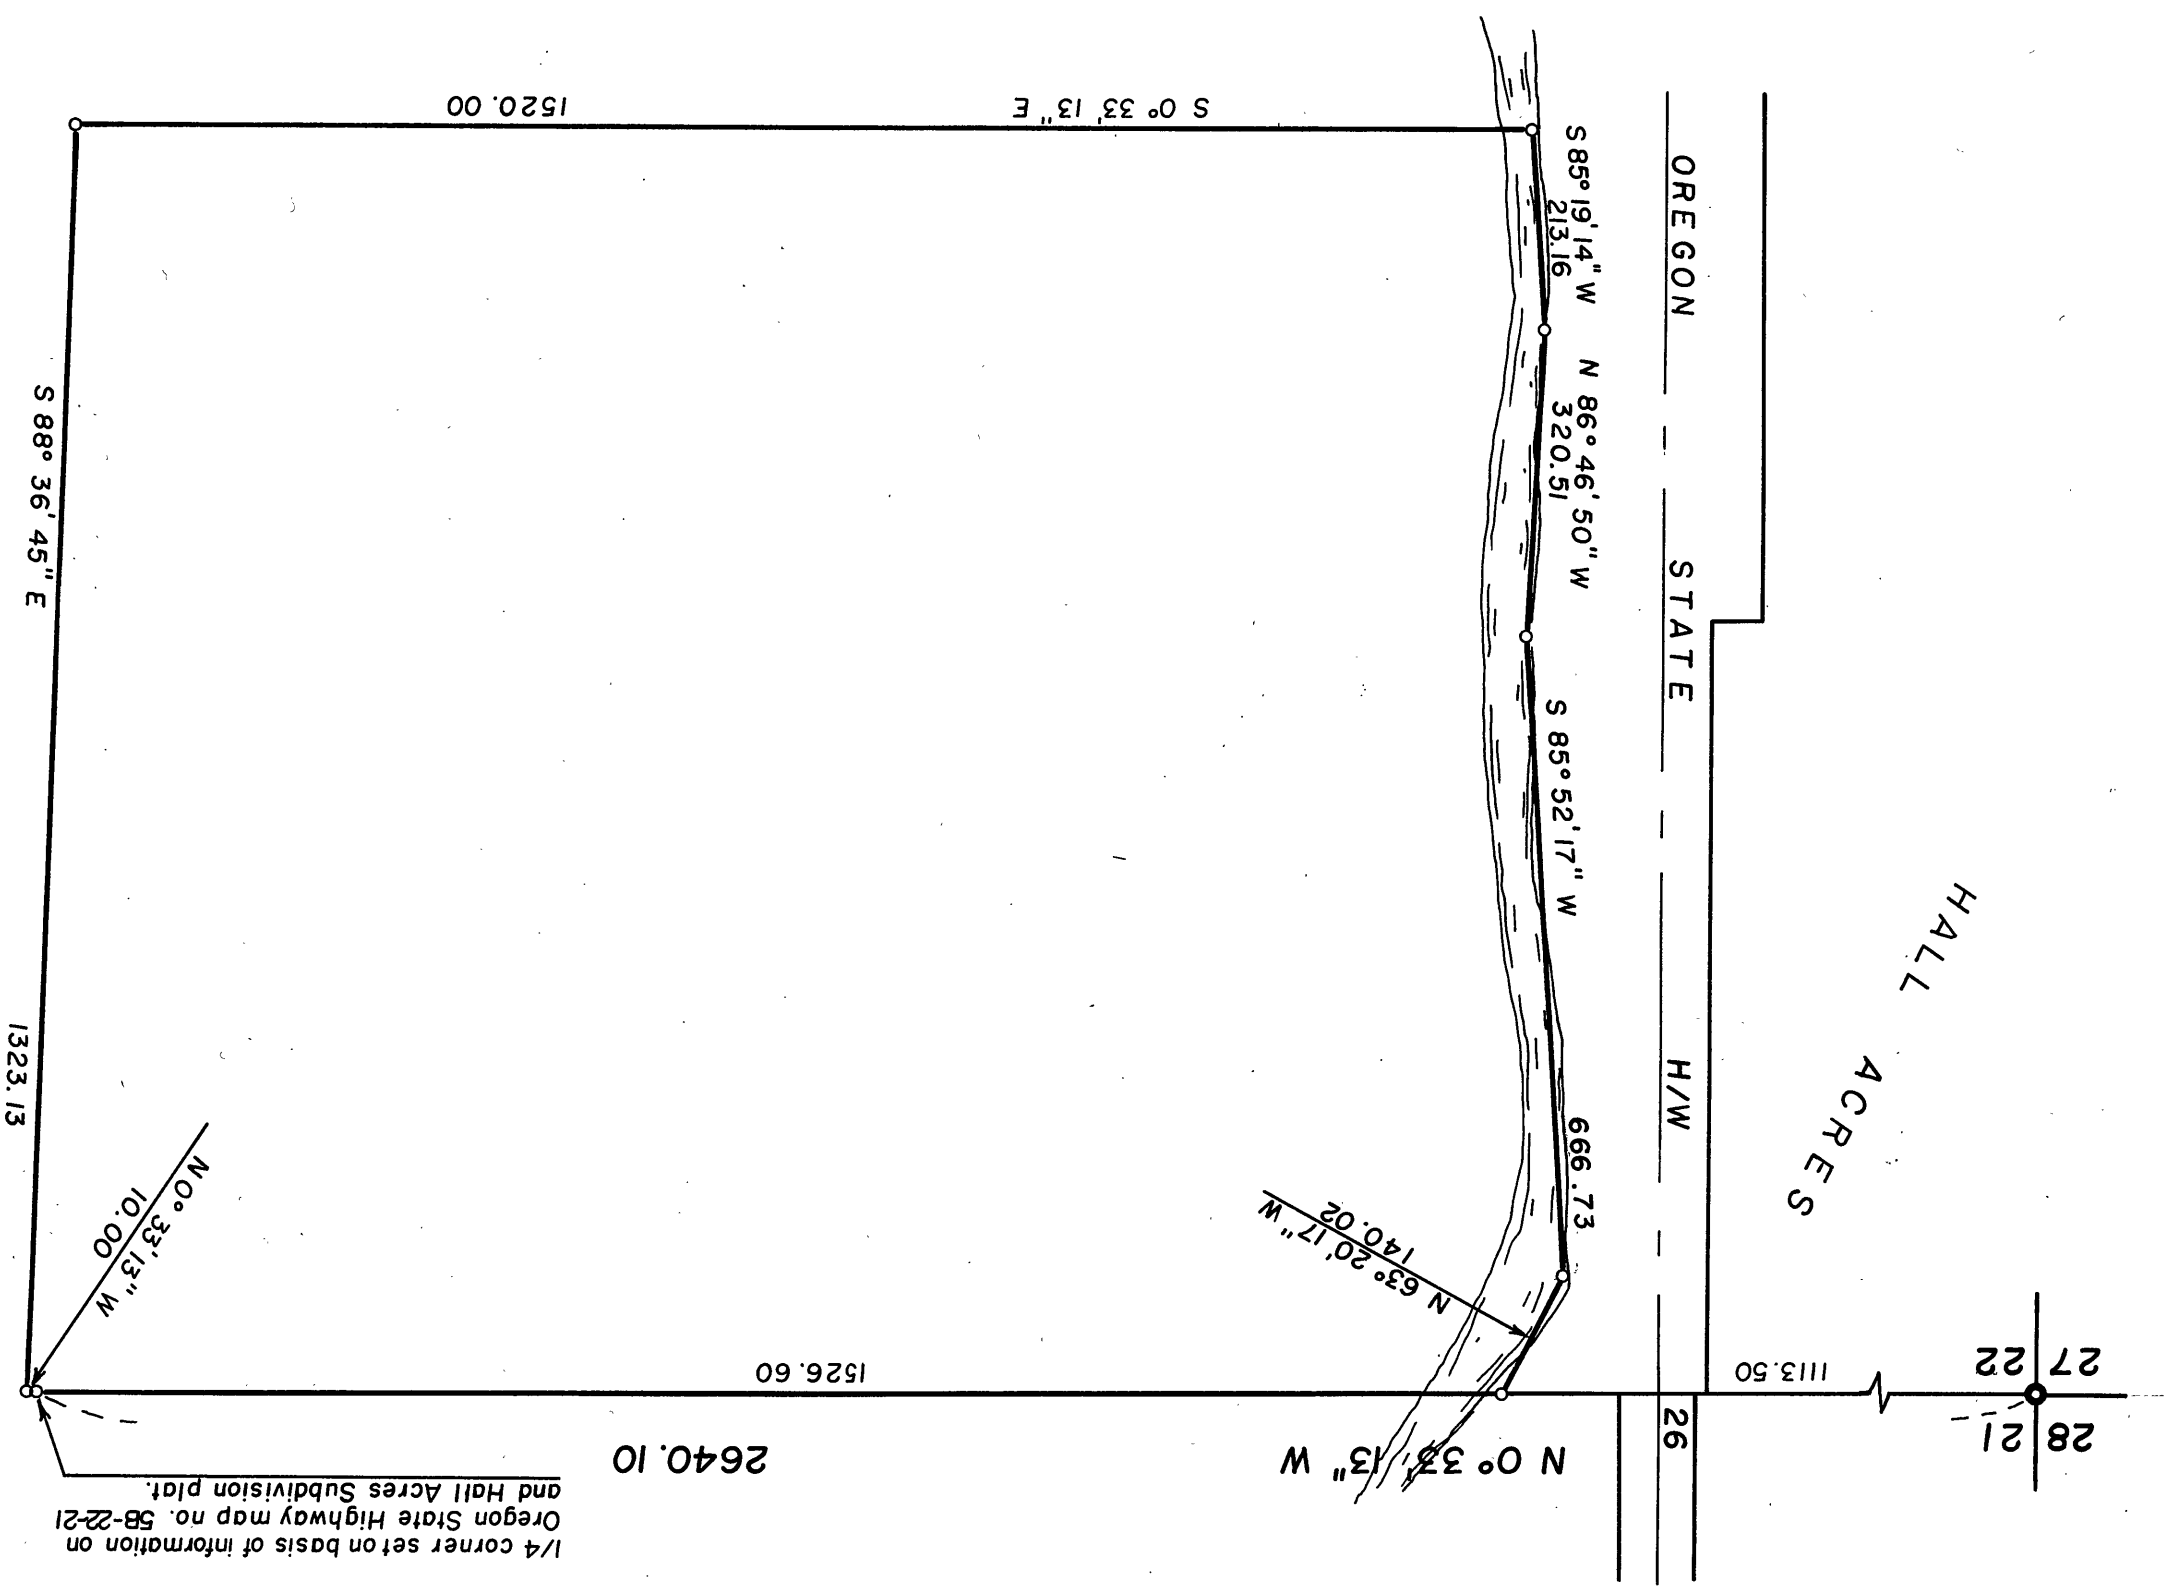

1/4 corner set on basis of information on
Oregon State Highway map no. 58-22-21
and Hall Acres Subdivision plat.
BASIS of BEARINGS
U.S.C. and G.S. Forward bearing
from Δ DAY to Δ JOHN DAY

REGISTERED
OREGON
LAND SURVEYOR
Duane I. Griffith
JULY 10, 1964
DUANE I. GRIFFITH
644

SURVEYED FOR		HINES LUMBER CO.	
SURVEYED BY		D.I.G. - R.D.B.	
Scale: 1" = 200'		Drawn by: D.I.G.	
11 / 1969		11 / 1969	

A Portion the S W 1/4 Section 22
T 13 S, R 31 E, W.M.
Grant County, Oregon
Map of Survey
John Day, Oregon

Survey no. 160