

T 12 S, R 35 1/2 E, W. M. (UNSURVEYED)
 SW 1/4 SEC. 6, T 12 S, R. 36 E, W. M.

THIS PLAT USES OACES APPROVED
 INK/MYLAR COMBINATION
 HP c4871a/51642b

L449
 FD. 3" BR DISK MARKED
 "L449, 460+28.00, 66.00 FT"
 S33°50'18"W 20.129m
 TO STA [460+28.00]
 N 100371.310
 E 2671303.969

K449
 FND. 75mm (3") BR DISK MKD.
 "K449, 460+28.00, 66.00 FT"
 N33°50'18"E 20.041m
 TO STA. [460+28.00]
 N 100337.944
 E 2671281.600

M449
 FND. 3" BR DISK
 MARKED "M449
 466+22.5"
 N 100236.711
 E 2671432.088

N449
 FND. 75mm (3") BRASS
 DISK IN CONC. COLLAR.
 N 100139.426
 E 2671612.718

NOTES

- ① STATION [460+28.00] ESTABLISHED BY BEARING - BEARING INTERSECTION OF U.S.F.S. EASEMENT CENTERLINE AND THE LINE BETWEEN MONUMENTS L449 AND K449
 N 100354.591
 E 2671292.760

Note: Existing ("Extg.") Stationing determined from Bureau of Public Roads Project No. 36-B3 dated 5/14/56.

38+800.000 P.O.T. =
 [466+62.327]
 N 100246.712
 E 2671453.206
 ENGLISH ST ATTOMING
 BROUGHT FORWARD
 FROM STA. [460+28.00]

REGISTERED
 PROFESSIONAL
 LAND SURVEYOR

Robert E. Butler

OREGON
 JULY 25, 1995
 ROBERT E. BUTLER
 2733

EXPIRES 12/31/2003

MALHEUR NATIONAL FOREST



T. 12 S., R. 35 1/2 E., W.M.
 (UNSURVEYED)

SECTION 6, T. 12 S., R. 36 E., W.M.


- [] DATA DERIVED USING BUREAU OF PUBLIC ROADS CONSTRUCTION PLANS FH-36
- () RECORD DATA AS NOTED
- ☆ FND. GPS POINT, CS 1205, 1206
- FND. 75mm (3") BR DISC IN CONC. COLLAR AS DESCRIBED BUREAU OF PUBLIC ROADS CONSTRUCTION PLANS FH-36
- U.S.F.S. EASEMENT CENTERLINE
- U.S.F.S. EASEMENT LINE
- TOWNSHIP LINE

S70°16'59"E 1218.294

SQUAW
 FND. 3" BR DISK
 SET IN CONC.
 MARKED "SQUAW, 1991"
 CS 1205, 1206
 N 99835.691
 E 2672600.072

S71°31'34"E 801.845m
 (S71°31'34.0"E 2630.73'), CS 1206

SQUAW AZ.
 FND. 75mm (3") BR DISK
 SET IN CONCRETE MARKED
 "SQUAW AZ MK, 1991"
 CS 1205, 1206
 N 99581.609
 E 2673360.597

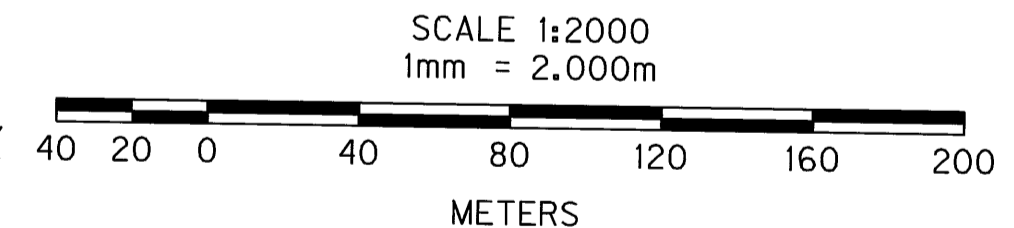

TO CONVERT METERS TO S. I. FEET DIVIDE BY 0.3048

OREGON DEPARTMENT OF TRANSPORTATION
 HORIZONTAL CONTROL, RECOVERY AND RETRACEMENT MAP
 OF THE 1953 AND 2000 ALIGNMENT OF THE
 JOHN DAY HIGHWAY (AUSTIN JCT. - BAKER CO. LINE SECTION)
 GRANT COUNTY, OREGON
 AUG. 3, 1999 TO OCT. 17, 2001 FOR O.D.O.T. REGION 5
 3012 ISLAND AVE., LA GRANDE, OREGON 97850
 2000 ALIGNMENT SHEET 21 OF 21