



Scale 1"=60'

BASIS OF BEARINGS


Land Partition No. 94-08

BASIS OF BEARINGS

(N81°50'00"E 791.72)
N81°50'00"E 791.72

LEGEND

- Found 5/8" iron pin with attached alum. cap, see Survey No. 1313
- ✱ Found 5/8" iron pin with attached yellow plastic cap, see Land Partition No. 94-08.
- Found 5/8" iron pin with attached red plastic cap, see Land Partition No. 2002-02, unless otherwise shown.
- ⊙ Found 5/8" iron pin with attached red plastic cap. This monument was set for Little Canyon Heights subdivision which has not been recorded yet.
- Set 5/8"x30" iron pin with attached 2" alum. cap, marked CORNERSTONE SURVEYING, INC., the centerline station and the offset from center line are also marked on the cap.
- () Record bearing and distance.
- Found monument, see record map of survey number shown in box.

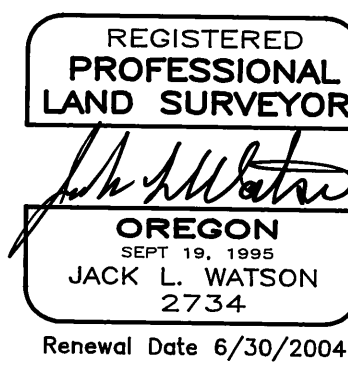

NARRATIVE

This survey was performed at the request of Jim Walker, on behalf of the Grant County Road Department. The purpose of this survey was to locate the existing road and establish the right of way lines for County Road No. 78.

A search was made of the available records pertaining to this survey. Field measurements were made to locate the existing road, the cut and fill slopes, and the existing survey monuments as shown hereon. The right of way was established to include the cut and fill slopes along the existing road.

RECEIVED AND FILED

MAR 20 2003

OFFICE OF COUNTY SURVEYOR

Grant County, Oregon

CORNERSTONE SURVEYING, Inc.
233 S. Canyon Blvd., John Day, Oregon
(541) 575-1813

MAP OF SURVEY
ELK VIEW LANE - COUNTY ROAD NO. 78
SITUATED IN GOVT LOTS 1, 2 AND 3 AND IN THE SE1/4
OF SECTION 2, T14S, R31E, W.M.

GRANT COUNTY, OREGON
SURVEYED FOR: Grant County
SURVEYED BY: Jack Watson Date: 6/12/2002
DRAWN BY: Jack Watson

Sheet 1 of 2

MAP OF SURVEY NO. 1638