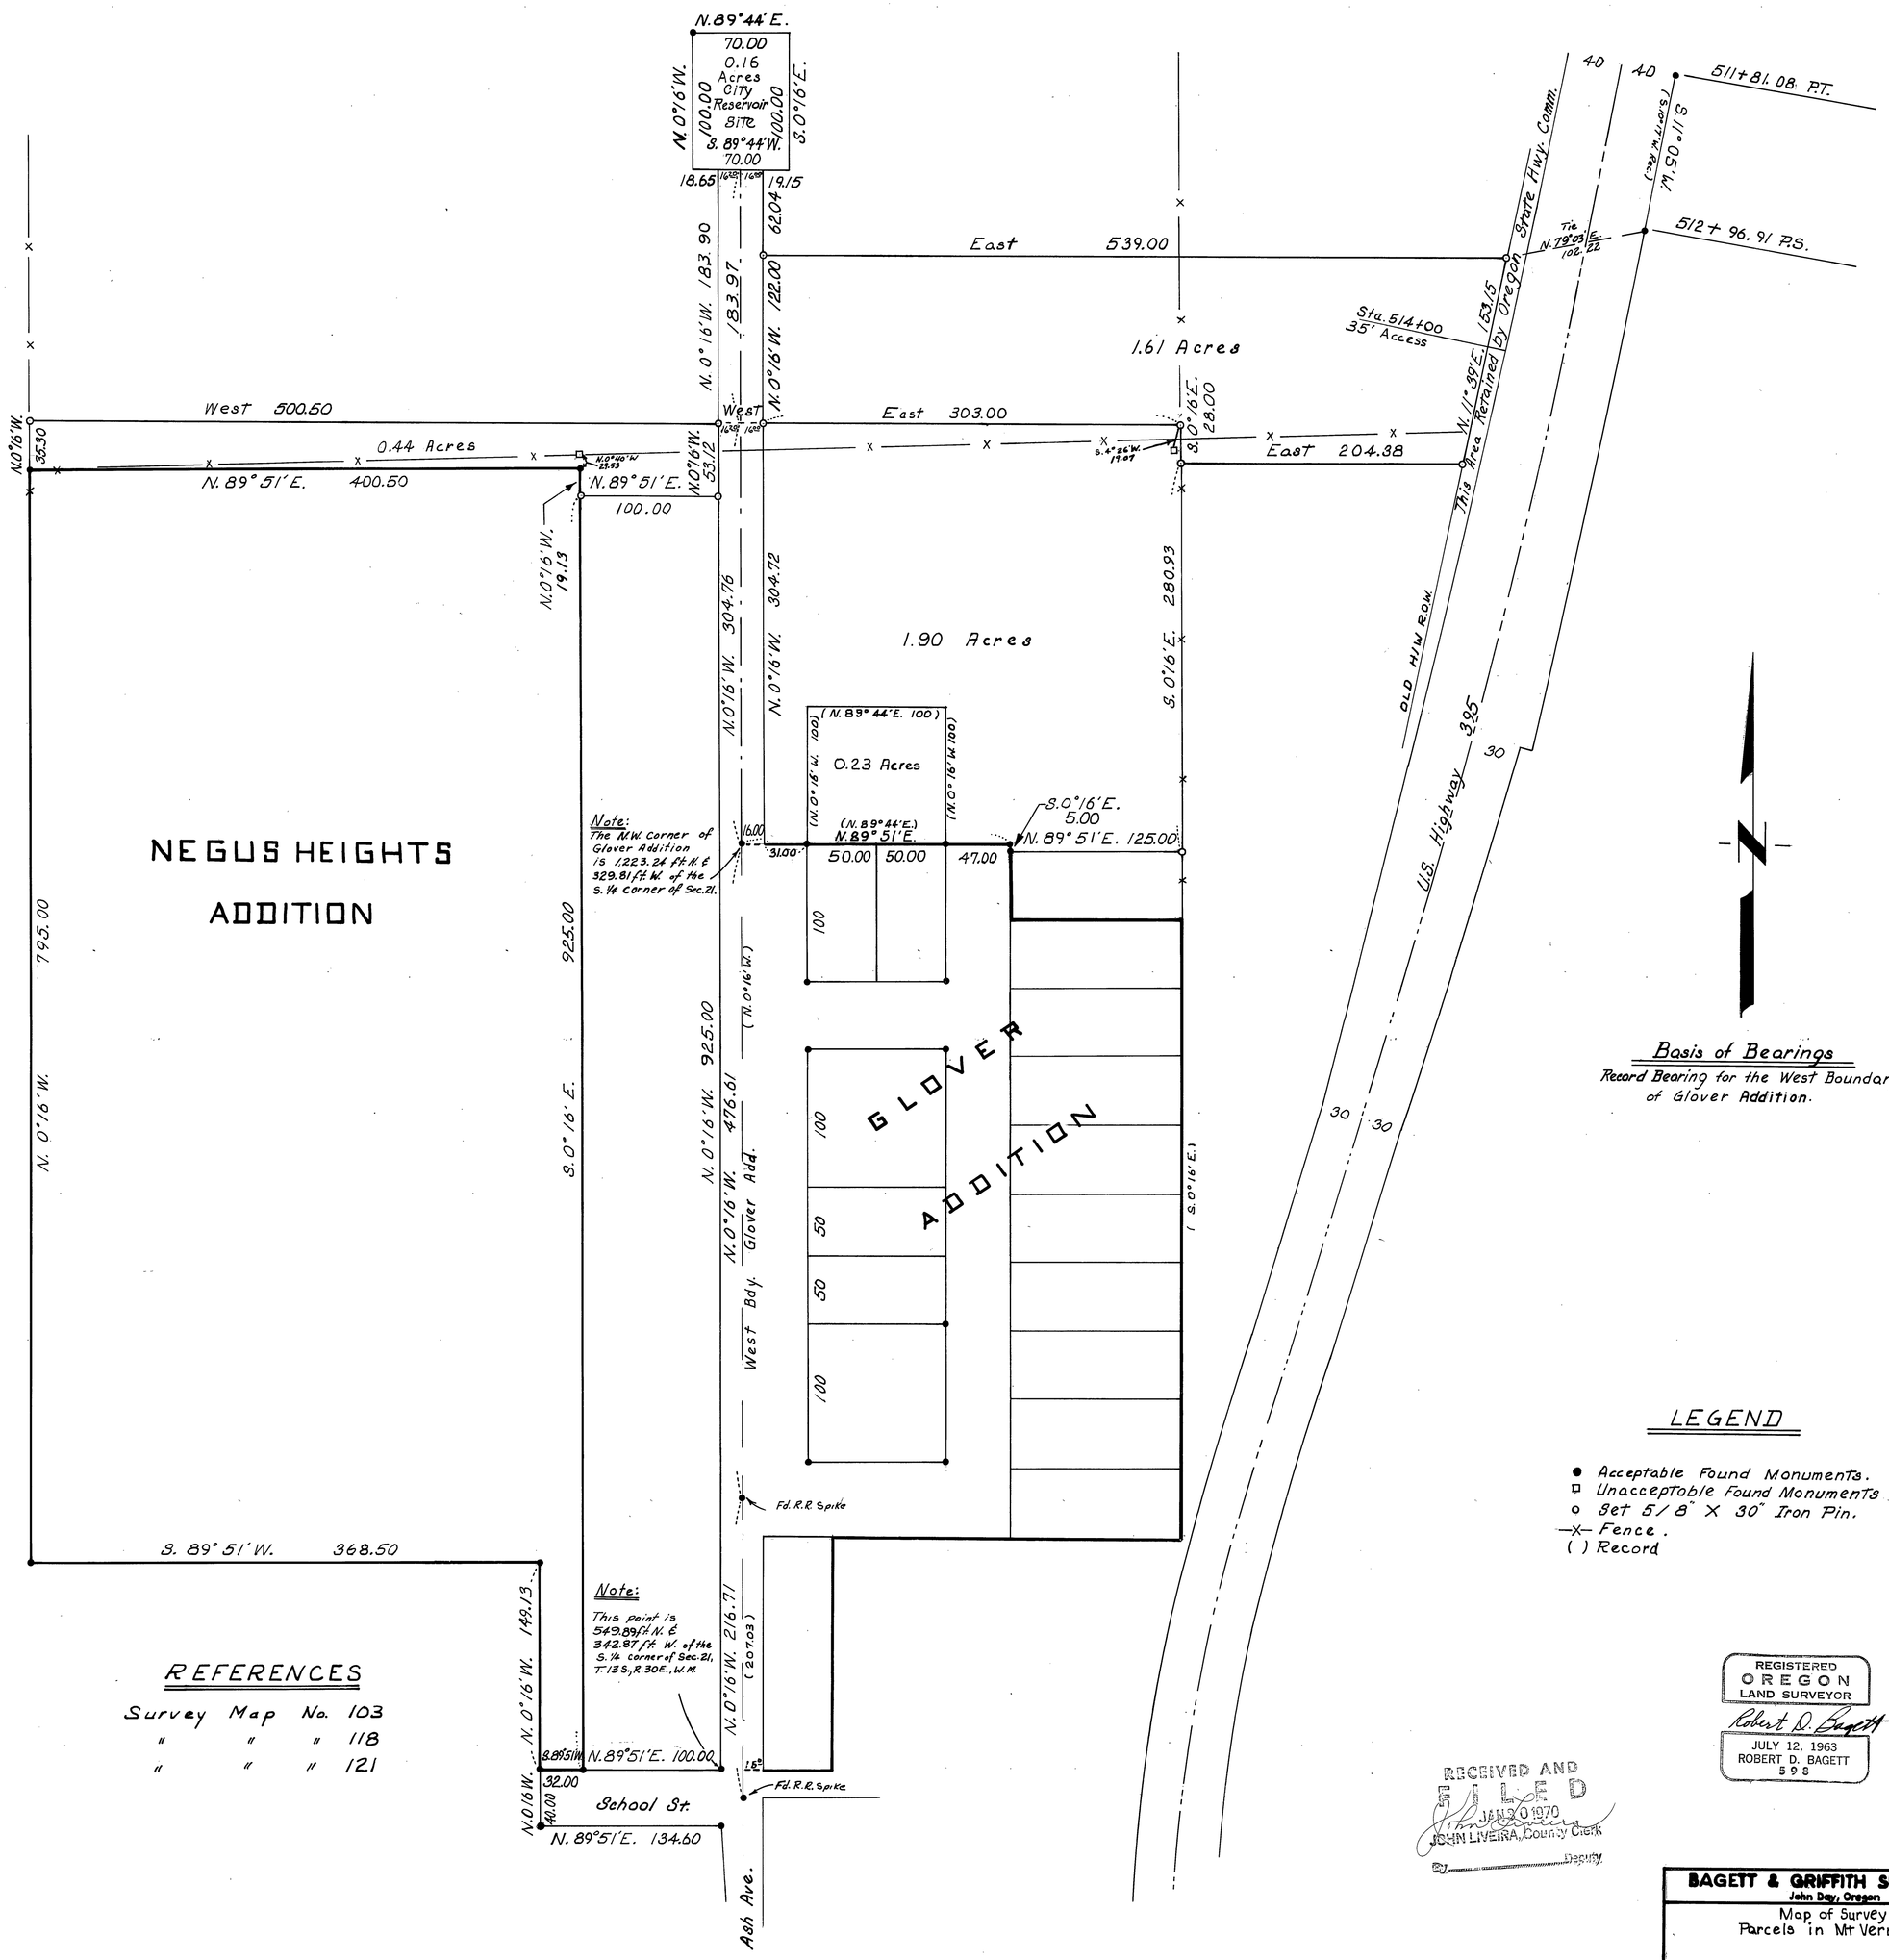

Survey No. 164