
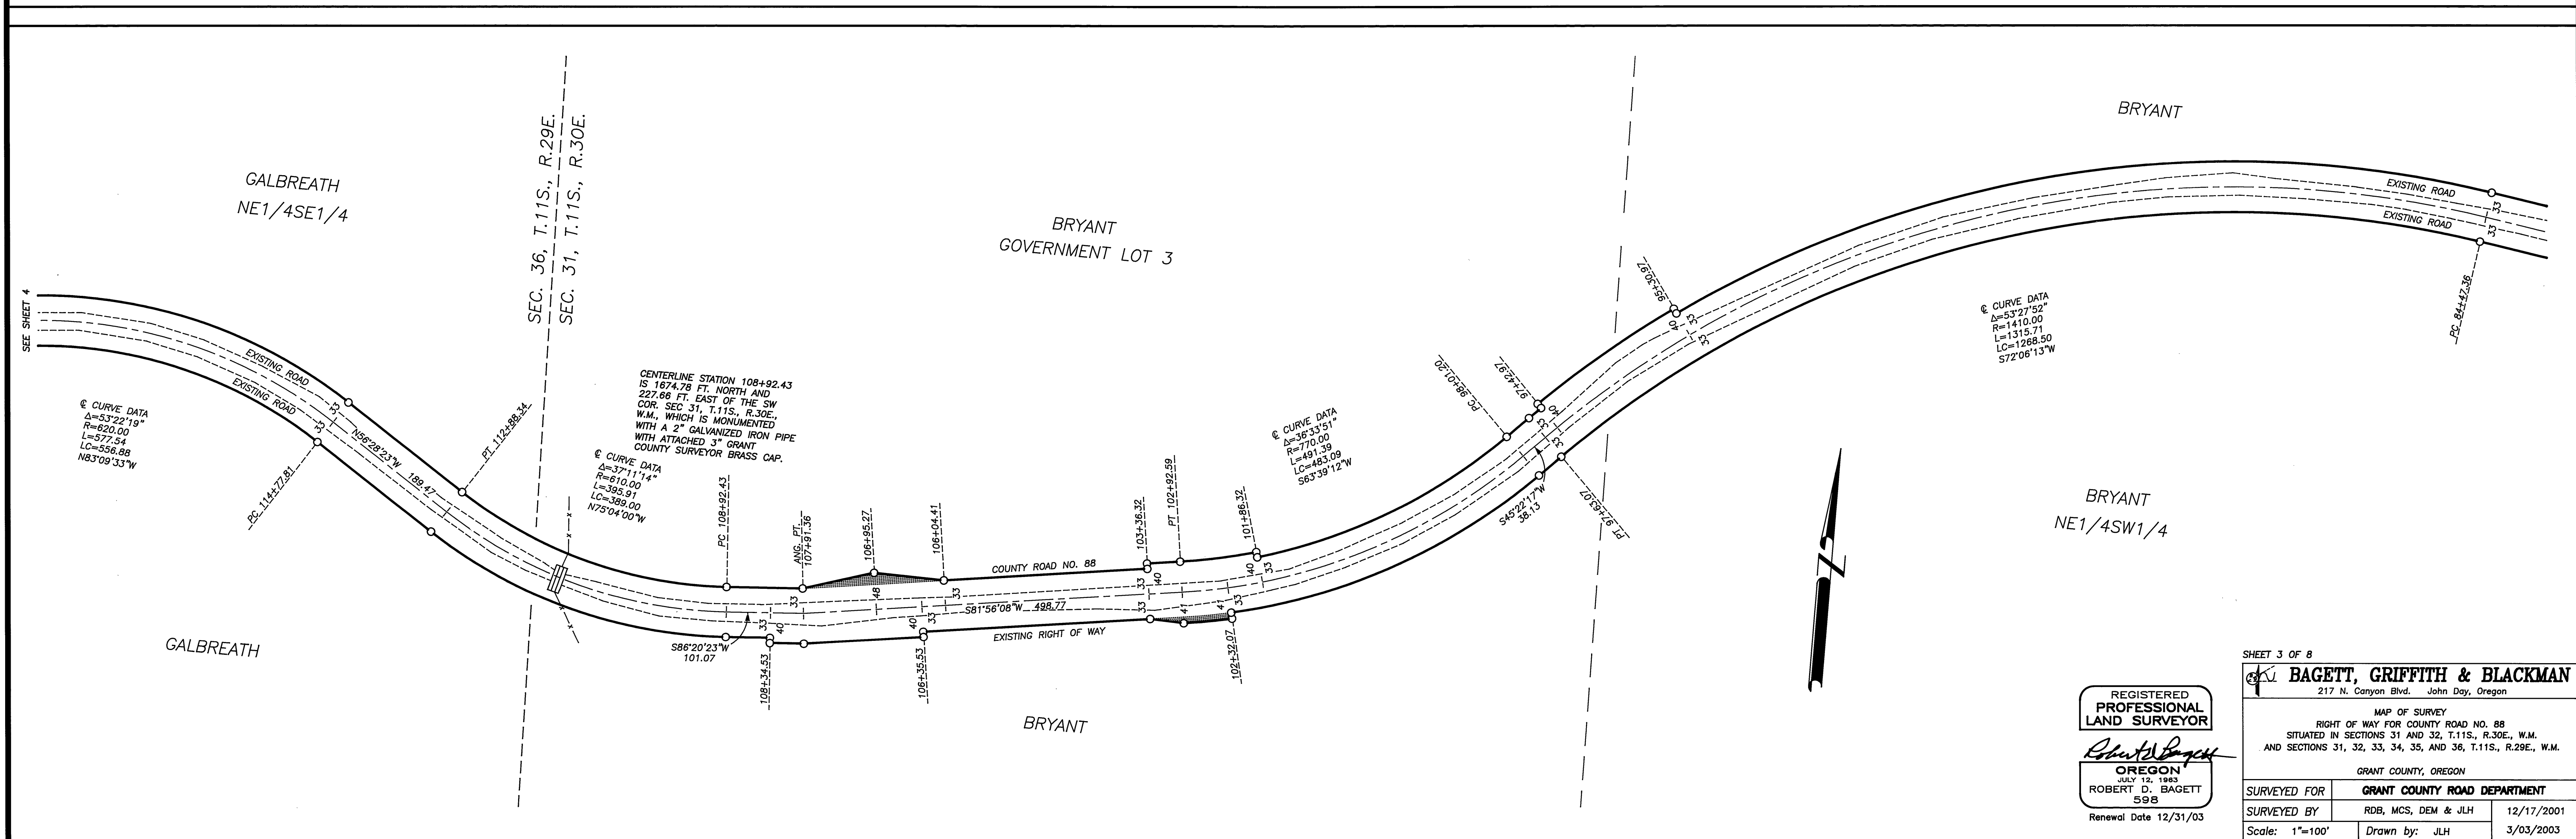


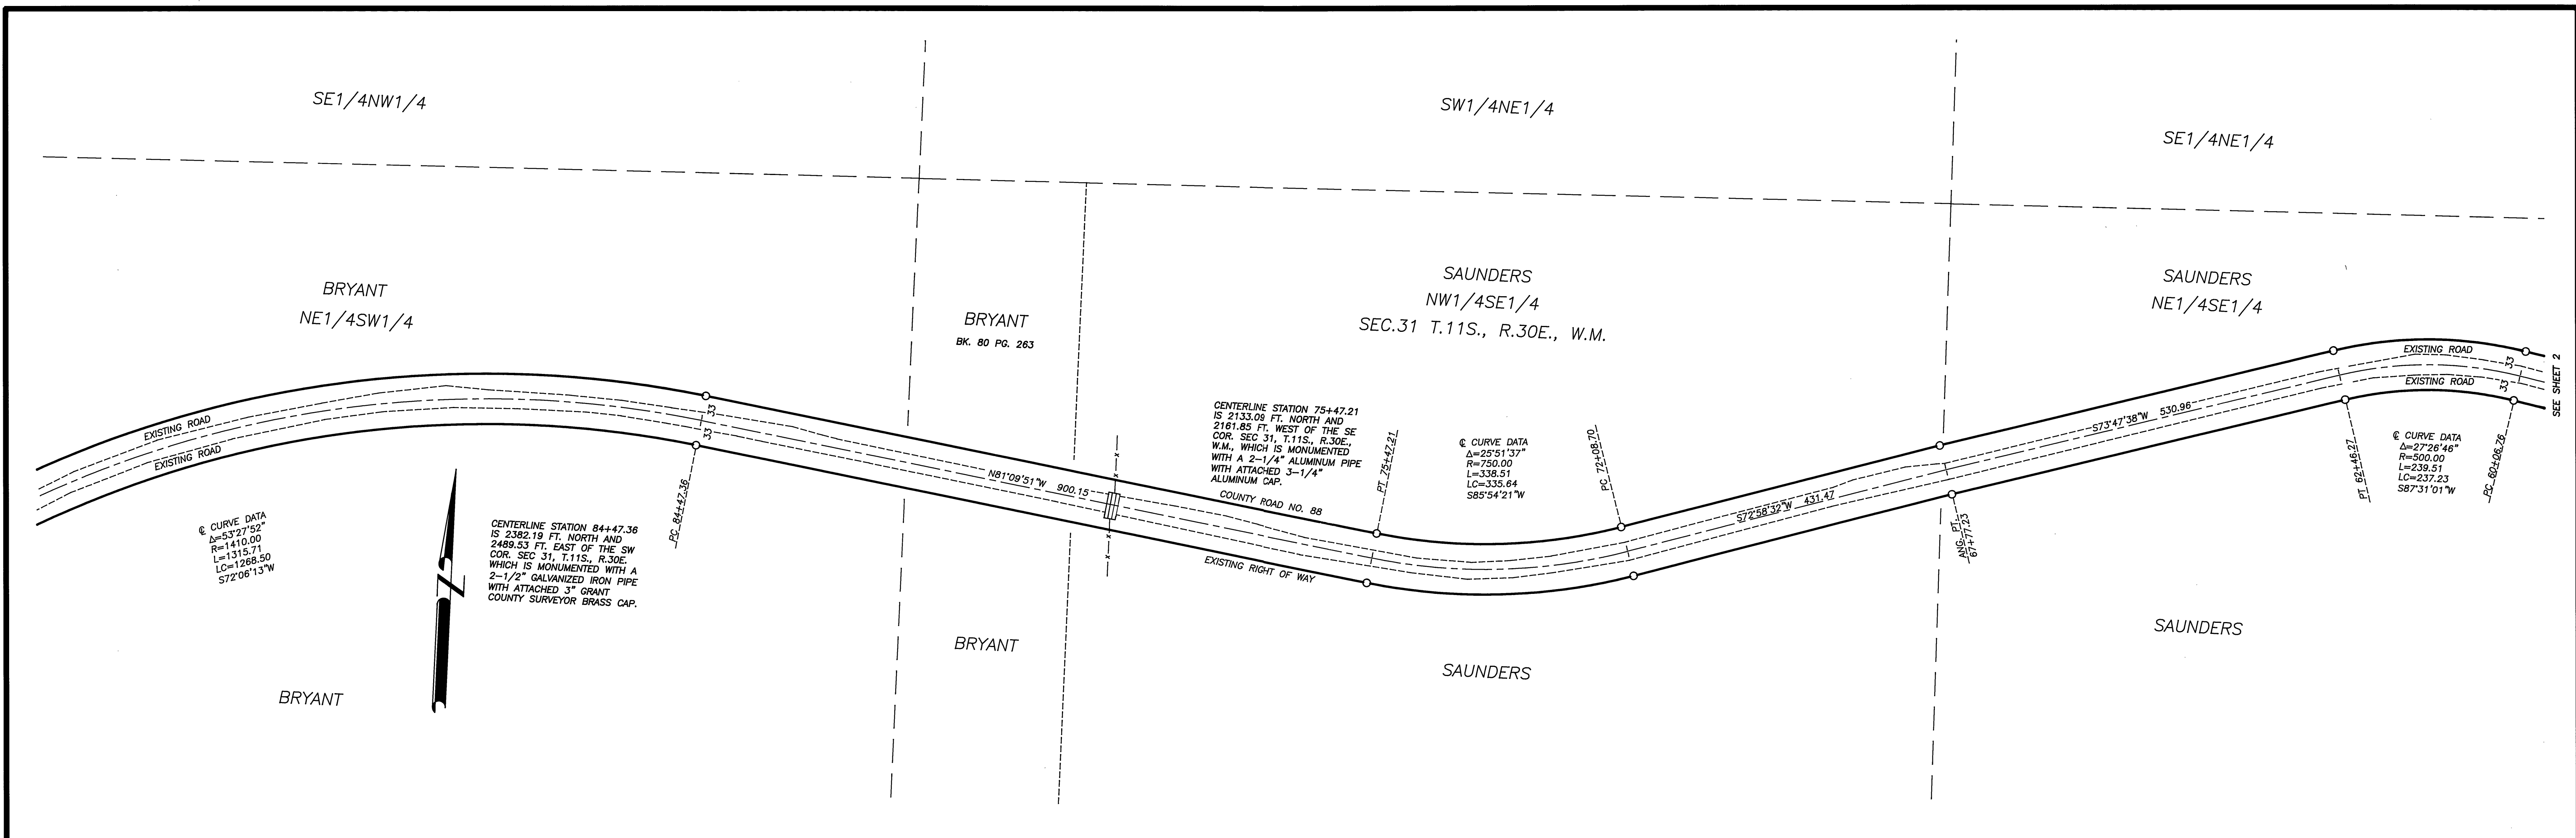

SHEET 3 OF 8

BAGETT, GRIFFITH & BLACKMAN
217 N. Canyon Blvd. John Day, Oregon

MAP OF SURVEY
RIGHT OF WAY FOR COUNTY ROAD NO. 88
SITUATED IN SECTIONS 31 AND 32, T.11S., R.30E., W.M.
AND SECTIONS 31, 32, 33, 34, 35, AND 36, T.11S., R.29E., W.M.

GRANT COUNTY, OREGON

SURVEYED FOR	GRANT COUNTY ROAD DEPARTMENT
SURVEYED BY	RDB, MCS, DEM & JLH
Scale: 1"=100'	Drawn by: JLH
12/17/2001	3/03/2003

RECORD MAP OF SURVEY NO. 1655