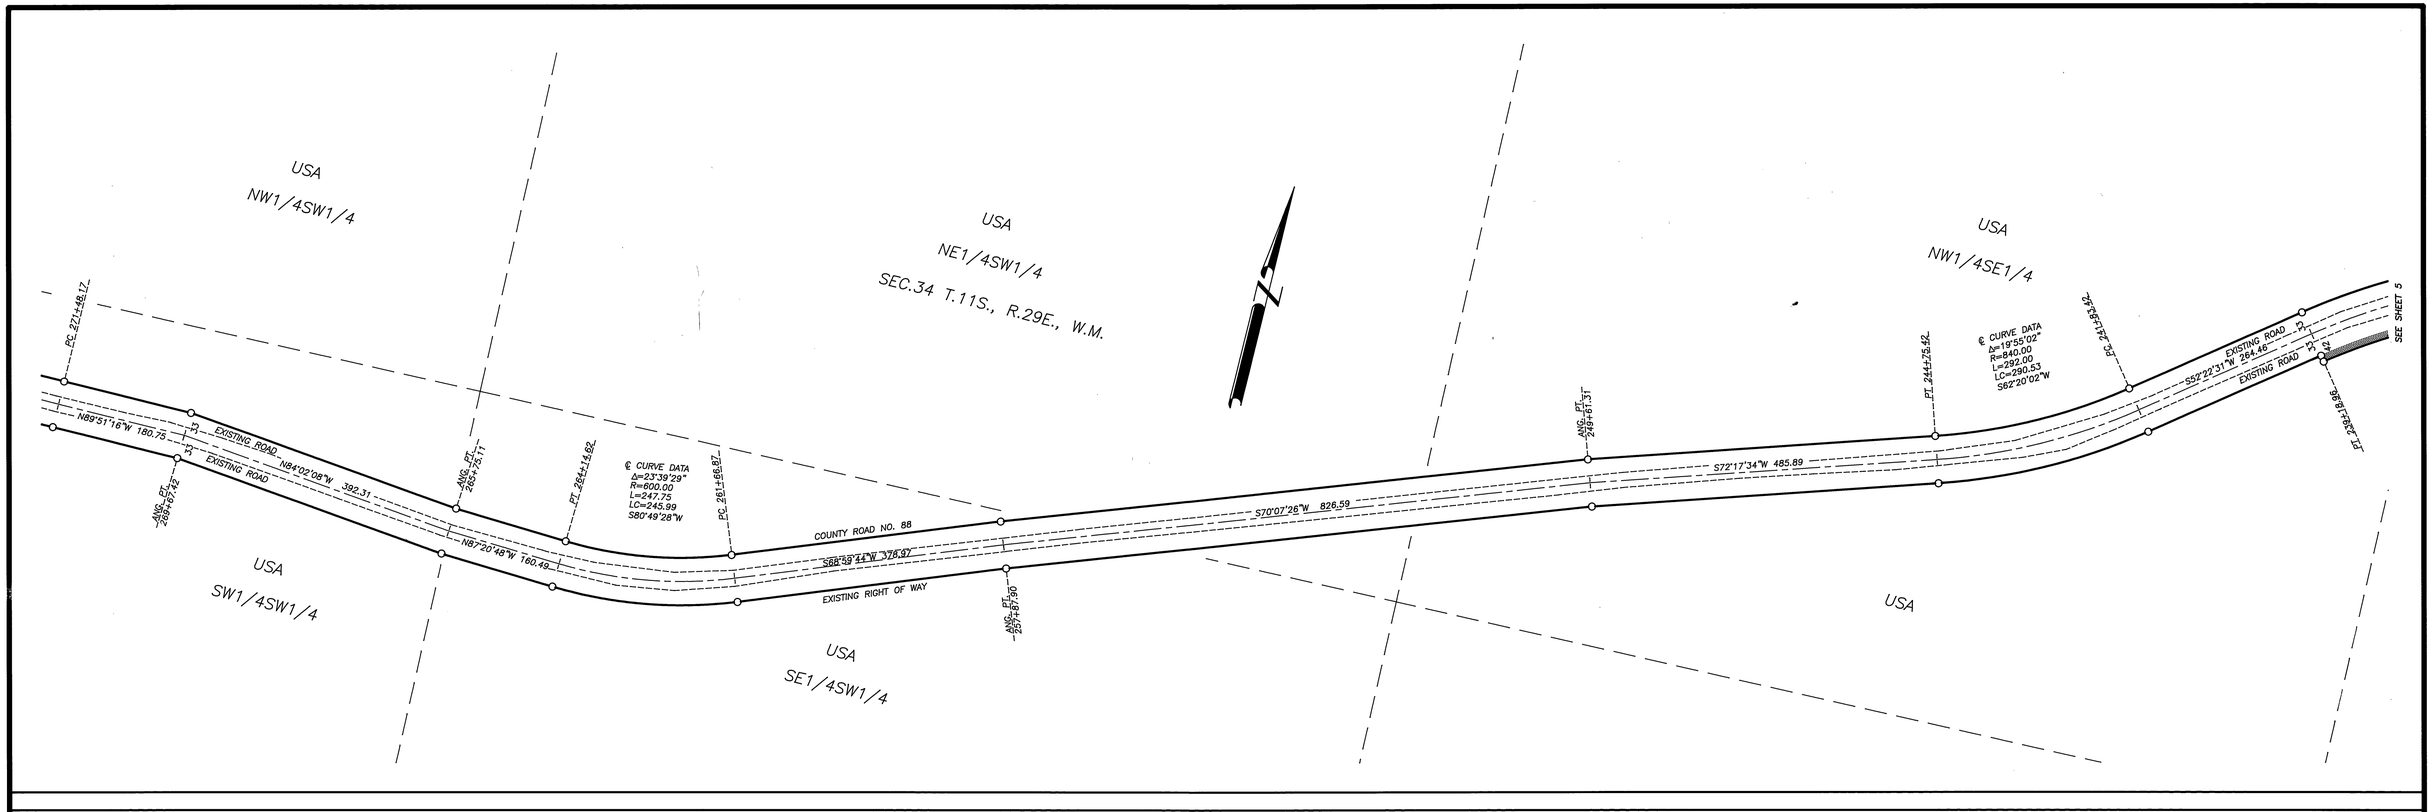

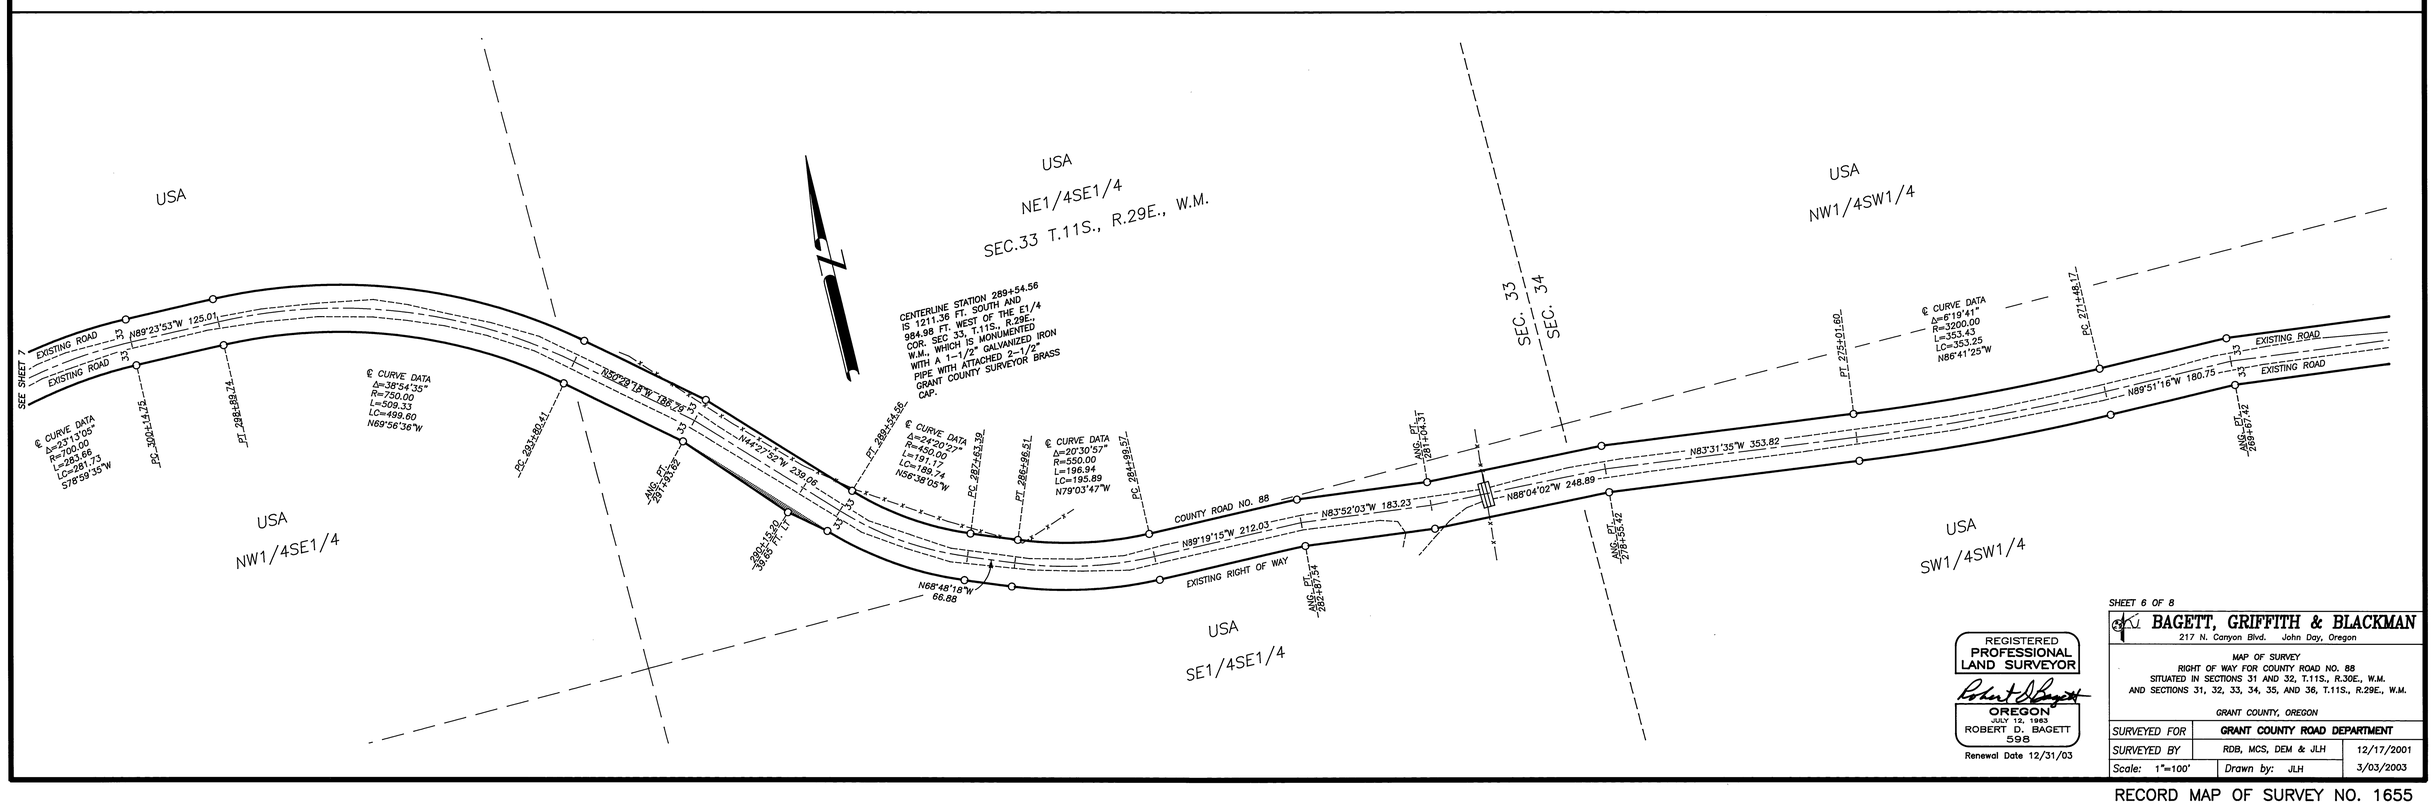

REGISTERED
PROFESSIONAL
LAND SURVEYOR

OREGON
JULY 12, 1983
ROBERT D. BAGETT
598

Renewal Date 12/31/03

SHEET 6 OF 8

BAGETT, GRIFFITH & BLACKMAN
217 N. Canyon Blvd. John Day, Oregon

MAP OF SURVEY
RIGHT OF WAY FOR COUNTY ROAD NO. 88
SITUATED IN SECTIONS 31 AND 32, T.11S., R.30E., W.M.
AND SECTIONS 31, 32, 33, 34, 35, AND 36, T.11S., R.29E., W.M.

GRANT COUNTY, OREGON

SURVEYED FOR	GRANT COUNTY ROAD DEPARTMENT	
SURVEYED BY	RDB, MCS, DEM & JLH	12/17/2001
Scale: 1"=100'	Drawn by: JLH	3/03/2003

RECORD MAP OF SURVEY NO. 1655