

Scale 1"=10'

BASIS OF BEARINGS

Survey No. 431

LEGEND


- Found railroad spike, see Survey No. 431.
- Found 5/8" iron pin, with no cap, see Survey No. 431.
- Set 5/8"x30" iron pin with attached red plastic cap marked CORNERSTONE SURVEYING, INC.
- () Record bearing and distance.

NARRATIVE

This survey was performed at the request of Janet Robertson. The purpose of this survey was to establish the adjusted boundary line as shown.

A search was made of the available records pertaining to this survey and for the appurtenant monuments on the boundary. I found the monuments from Survey No. 431 as shown and set the two new boundary monuments on line between the found monuments. The new boundary monuments are set at the positions approved by the adjoining landowners.

RECEIVED AND
FILED
MAY 2, 2002
JACK L. WATSON
JANET ROBERTSON

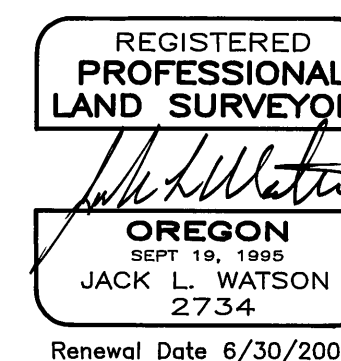

CORNERSTONE SURVEYING, Inc.
233 S. Canyon Blvd., John Day, Oregon 97845
(541) 575-1813

MAP OF SURVEY LOT LINE ADJUSTMENT SITUATED IN LOT 9, BLOCK 'E' CITY OF JOHN DAY NW1/4 OF SECTION 26, T13S,R31E,W.M. GRANT COUNTY, OREGON	
SURVEYED FOR: Janet Robertson	
SURVEYED BY : Jack Watson	Date: 04/21/2003
DRAWN BY : Jack Watson	

MAP OF SURVEY NO. 1661