

# **BASIS OF BEARINGS** SURVEY NO. 1656

## **LEGEND**


- Found monument as shown.
- Found 5/8" iron pin with attached red plastic cap, see Survey No. 1656.
- Set 5/8"x30" iron pin with attached red plastic cap marked CORNERSTONE SURVEYING, INC.
- X—X Fence Line
- ( ) Record bearing and distance.
- Found monument, see record map of survey number shown in box.

## **NARRATIVE**

This survey was performed at the request of Don Strong. The purpose of this survey was to locate the boundaries of the portion of Harris Ave. North which was vacated by the City of Prairie City and the proposed boundary adjustment lines shown hereon.

A search was made of the available records pertaining to this survey. Field measurements were made to locate the appurtenant monuments from Survey No.'s 581, 1366, 1579 and 1656. I held the bearing between the found monuments at the SW corner of Block 3, Lot 1, and the SW corner of Block 1, Lot 1 of McHaley's Addition. The NW corner of Block 1, Lot 1 was established perpendicular to this line and at plat record distance from the SW corner of the block. The south line of Fourth Street East was extended to the intersection of Amended Reservoir Addition as called for in the city vacation description.

The proposed boundary adjustment lines were monumented at the locations chosen by the land owners. The easterly line is intended to be 0.5 feet easterly of the garage eaves. The northerly line generally follows the fence line.

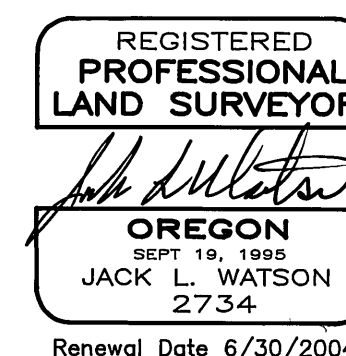

**CORNERSTONE SURVEYING, Inc.**  
 233 S. Canyon Blvd., John Day, Oregon 97845  
 (541) 575-1813

MAP OF SURVEY PARCELS IN LOT 5 OF AMENDED RESERVOIR ADDITION AND THE VACATED PORTION OF HARRIS AVE. NORTH CITY OF PRAIRIE CITY GRANT COUNTY, OREGON	
SURVEYED FOR:	Don Strong
SURVEYED BY:	Jack Watson
DATE:	Oct. 8, 2003
DRAWN BY:	Jack Watson

MAP OF SURVEY NO. 1677

RECEIVED AND  
 FILED

OCT. 20, 2003  
 OFFICE OF COUNTY SURVEYOR  
 PRAIRIE CITY, OREGON