

NARRATIVE

THIS SURVEY WAS PERFORMED AT THE REQUEST OF DWAIN ANDERSON. THE PURPOSE OF THIS SURVEY WAS TO LOCATE THE CORNERS OF THE SE1/4SW1/4 SECTION 1, TWP. 14 S., R. 32 E.; TO SUBDIVIDE SAID SE1/4SW1/4 BY SURVEY AND TO POST WITH LATH AND FLAGGING THE LINES SHOWN HEREON.

A SEARCH WAS MADE OF THE AVAILABLE RECORDS PERTAINING TO THIS SURVEY. FIELD MEASUREMENTS WERE MADE TO LOCATE EXISTING MONUMENTS AND CORNER EVIDENCE. NEW MONUMENTS WERE SET IN ACCORDANCE WITH THE EVIDENCE FOUND.

THE HISTORY OF SURVEYS PERTAINING TO THIS SURVEY ARE AS FOLLOWS: SECTION 1 WAS SUBDIVIDED BY MELVIN V. DAVENPORT IN JUNE OF 1976 DURING RECORD SURVEY NO. 406. RECORD MAP OF SURVEY NO. 406 IS A CORRECTION SURVEY FOR A PREVIOUS SURVEY OF THIS SECTION PREFORMED BY MR. DAVENPORT.

THE SOUTH LINE OF THE SE1/4SW1/4 WAS SURVEYED AND MONUMENTED BY ROBERT BAGETT IN OCTOBER 1975 DURING RECORD SURVEY NO. 384.

DURING THE COURSE OF THIS SURVEY I SEARCHED FOR, BUT DID NOT FIND THE MONUMENT FOR THE W1/16 CORNER BETWEEN SECTIONS 1 AND 12. I DID FIND THE TWO BEARING TREES TAKEN BY MR. BAGETT DURING RECORD SURVEY NO. 384. AFTER A DILIGENT SEARCH, I DETERMINED THIS CORNER MONUMENT TO BE OBLITERATED AND I PLACED A NEW MONUMENT AT RECORD POSITION FROM THE FOUND BEARING TREES. SEE THE CORNER RESTORATION RECORD FILED IN THE CORNER RESTORATION BOOK FOR DETAILS OF THE MONUMENT SET AND ACCESSORIES.

I ACCEPT THE MONUMENTS FROM THESE SURVEYS.

RECEIVED AND FILED


NOV.17,2003 OFFICE OF COUNTY SURVEYOR

Resert D. Bagett
ATTEST: Jam J. Harfieli

REGISTERED PROFESSIONAL LAND SURVEYOR

Michael C. Springer

OREGON
JULY 9, 2002
MICHAEL C. SPRINGER
#70918
EXPIRES: 6/30/2004

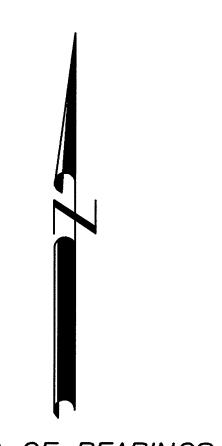

BASIS OF BEARINGS

RECORD MAP OF SURVEY NO. 406 AS SHOWN

REFERENCES

RECORD MAP OF SURVEY NO.'S 406 & 384
DEED RECORD INSTRUMENT NO. 032554

LEGEND

- FOUND 1½" GALV. IRON PIPE WITH ATTACHED GRANT COUNTY SURVEYOR BRASS CAP
- FOUND 2¼" IRON PIPE WITH ATTACHED 2½" BRASS CAP MARKED M.V.D. P.E. 3319 AND FOR 1/16 CORNER
- O SET 5/8"X30" IRON PIN WITH ATTACHED 1½" ALUMINUM CAP MARKED BGB SURVEY MARKER AND FOR 1/16 OR 1/256 CORNER
- () RECORD BEARING AND DISTANCE FROM RECORD MAP OF SURVEY NO. 406
- (()) RECORD BEARING AND DISTANCE FROM RECORD MAP OF SURVEY NO. 384
- FOUND MONUMENT FROM RECORDED SURVEY NO. SURVEY NO. APPEARS IN BOX
- X-X FENCE LINE
- --- POSTED LINE

	TT, GRIFFITH &	
	MAP OF SURVEY	
	A DEPENDENT RESURVEY OF THE SE1/4SW1/4 SEC. T.14S., R.32E., W.M.,	1,
	GRANT COUNTY, OREGON	
SURVEYED FOR	DWAIN AND KATIE A	NDERSON
SURVEYED BY	MCS & JLH	11/14/2003
Scale: 1"=200'	Drawn by: MCS	