

**CERTIFIED RECORD OF LAND CORNER MONUMENTATION**


**HISTORY OF ORIGINAL CORNER ESTABLISHMENT:**

NORTHEAST CORNER OF BLOCK A, HERBERGER  
ADDITION TO JOHN DAY.

REFER OF GRANT COUNTY SURVEY NO. 1008 (1987)

Survey No. 1008 states Found 5/8" Iron Pin with reference to Grant County  
Survey 125.

For History of this monument prior to Survey No. 125, refer to records of  
Grant County.

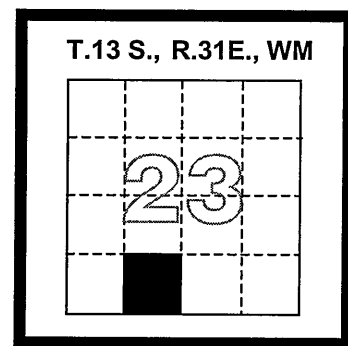

DIAGRAM

**DESCRIPTION OF CORNER EVIDENCE FOUND:**

On January 14, 2004, found a 5/8" diameter iron rod (Concrete reinforcing rod), buried 0.2' in asphalt  
pavement, unmarked.

As part of a mapping survey in progress on this day for the purpose of street improvement design, survey  
measurements were made to the existing location of this found survey monument.

Witnesses: Jeffrey Madsen, LSIT  
Gary Langlitz

**DESCRIPTION OF MONUMENT AND ACCESSORIES I ESTABLISHED TO PERPETUATE THE  
ORIGINAL LOCATION OF THIS CORNER:**

The monument found on Jan. 14, 2004 was removed by street  
construction activities during the summer of 2004.

On October 26, 2004, set a 5/8" diameter by 30" long Iron Rod  
(Concrete reinforcing rod), flush in new asphalt pavement, with yellow  
plastic cap attached, marked "APA". This monument was placed at the  
location of the monument found and tied on Jan. 14, 2004 as described  
above.

The purpose of this Certified Record of Land Corner Monumentation is  
to continue the chain of history of the location and nature of the  
monument described herein, and to comply with Oregon Revised  
Statutes, Chapter 209.150.

This survey was performed on the dates noted, for the benefit of the  
City of John Day, Oregon.

Survey performed by: Anderson Perry & Assoc., Inc.  
Post Office Box 1107  
La Grande, Oregon 97850  
(541) 963-8309

**SPCS OREGON NORTH (International Feet)**  
Oregon State Plane Coordinate position not determined.


I hereby certify that the above corner position was  
perpetuated as hereon described on October 26, 2004.

Witnesses: Gary Langlitz  
Roy Nelson

Q:\JohnDay\Remon04\NEBlkAHerberger.doc

RECEIVED AND  
FILED

NOV. 24, 2004  
OFFICE OF COUNTY SURVEYOR  
Attest: *[Signature]*

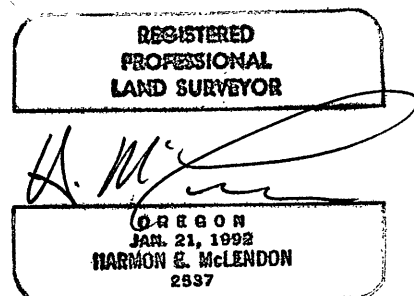

Renews 12/31/04

MAP OF SURVEY NO. 1721