


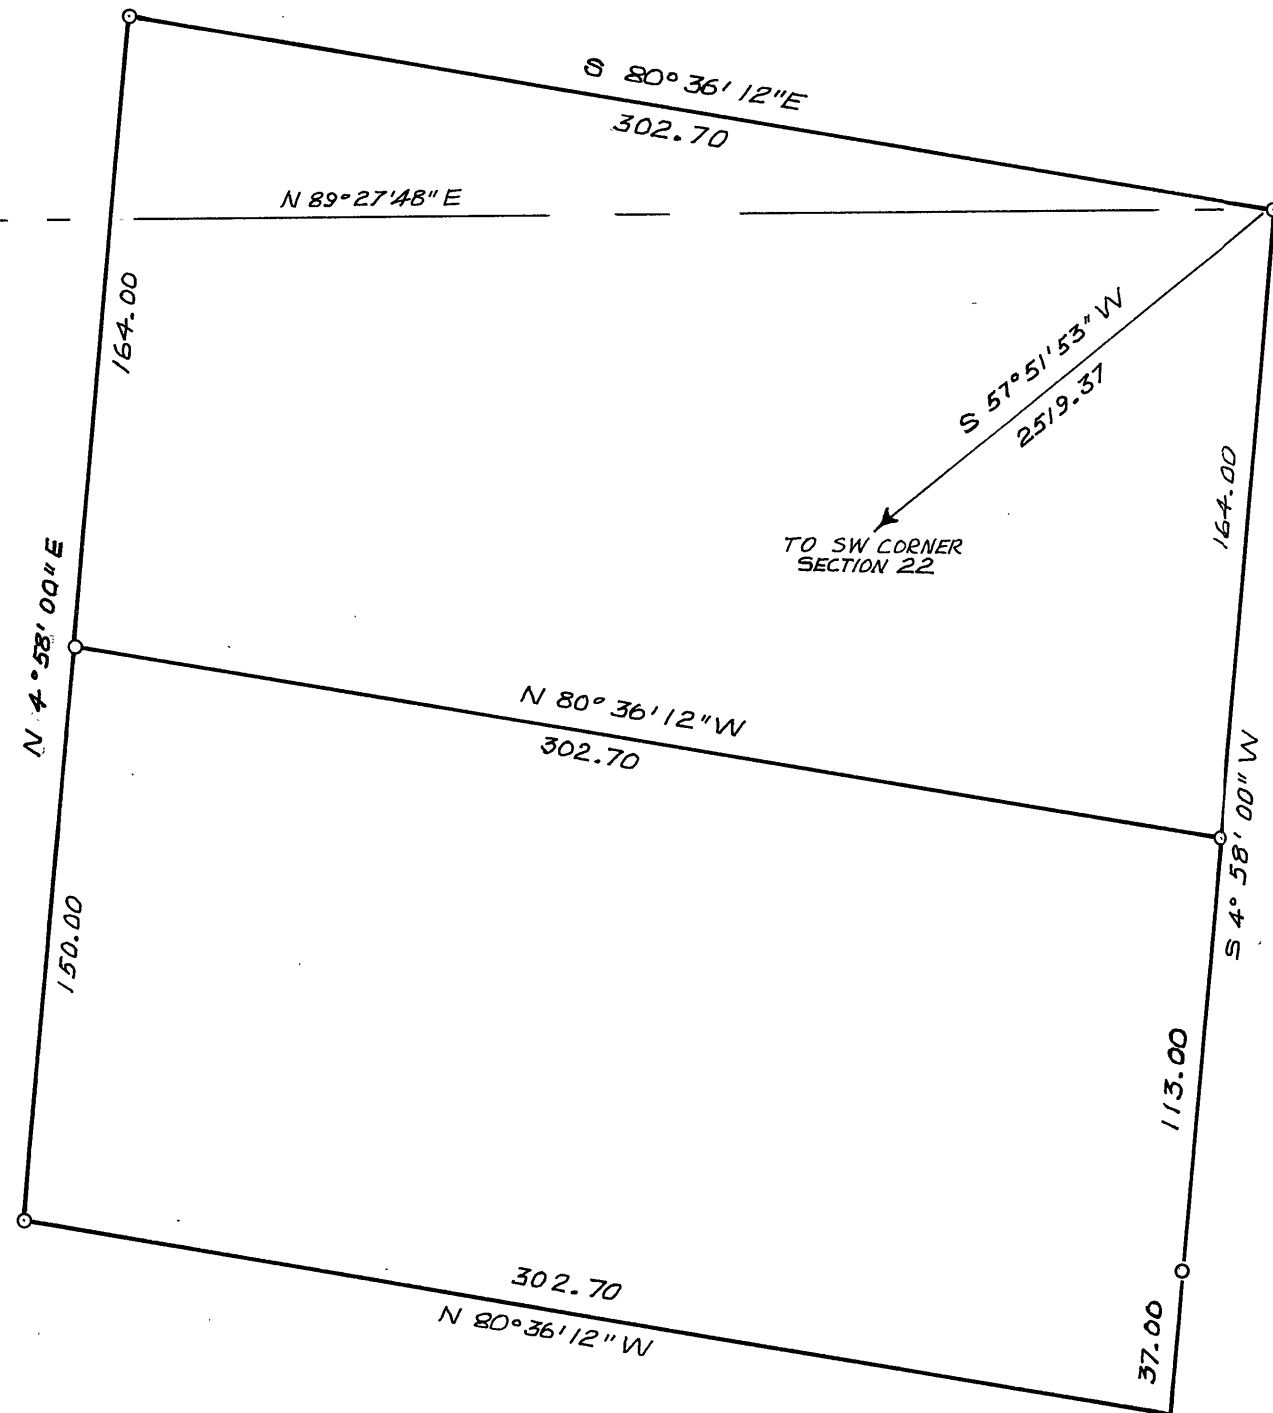

o Set 5/8"x30" iron pin

N. LINE SE-SW

RECEIVED AND
FILED

APR 2 1970
JOHN LIVEIRA, County Clerk

Deputy



Basis of Bearings
Survey no. 160

REGISTERED
OREGON
LAND SURVEYOR

Duane I. Griffith
JULY 10, 1964
DUANE I. GRIFFITH
644

BAGETT & GRIFFITH SURVEYING

John Day, Oregon

MAP OF SURVEY

RESURVEY OF PARCELS IN

SW 1/4 SECTION 22

T13S R31E WM

GRANT COUNTY, OREGON

SURVEYED FOR

BEN TEMPLE

SURVEYED BY

D. I. G.

MARCH, 1970

Scale: 1" = 50'

Drawn by: T. D. G.

MARCH, 1970

Map of Survey no. 173