


THIS SURVEY WAS PERFORMED AT THE REQUEST OF DAVE LUNDY AND MEL PLEMMONS. THE PURPOSE OF THIS SURVEY WAS TO SUBDIVIDE THE SW1/4 SECTION 35 AND MONUMENT THE CORNERS OF THE LAND DESCRIBED IN DEED INSTRUMENT NO. 051064.

A SEARCH WAS MADE OF THE AVAILABLE RECORDS PERTAINING TO THIS SURVEY. WE MADE FIELD MEASUREMENTS TO LOCATE THE EXISTING APPURTENANT MONUMENTS FROM RECORD SURVEY NO.'S 286, 361, 1470, 1548 AND 1593, AS SHOWN HEREON. I ACCEPT THE MON-UMENTS SHOWN HEREON, FROM THESE SURVEYS.

I SUBDIVIDED THE SW1/4 SECTION 35 IN THE USUAL MANNER AND SET NEW MONUMENTS ACCORDING TO THE EVIDENCE FOUND.

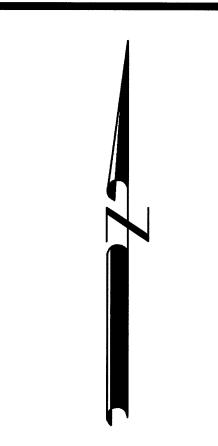

# BASIS OF BEARINGS

RECORD MAP OF SURVEY NO. 1593 AS SHOWN

## REFERENCES

RECORD MAP OF SURVEY NO.'S 286, 361, 1470, DEED RECORD INSTRUMENT NO.'S 212394, 212566, 212569 & 051064

### LEGEND

- FOUND 1½" GALV. IRON PIPE WITH ATTACHED GRANT COUNTY SURVEYOR BRASS CAP
- FOUND 21/2" ALUMINUM PIPE WITH ATTACHED
- FOUND 21/2" GALV. IRON PIPE WITH ATTACHED 3" BLM BRASS CAP
- FOUND 5/8" IRON PIN WITH ATTACHED RED PLASTIC CAP MARKED CORNERSTONE SURVEYING INC
- SET 5/8"X30" IRON PIN WITH ATTACHED ALUMINUM CAP MARKED BGB SURVEY MARKER, AND WITH APPROPRIATE 1\64 AND 1\256 CORNER DESIGNATIONS
- SET 5/8"X30" IRON PIN WITH ATTACHED YELLOW PLASTIC CAP MARKED BGB SURVEY MARKER
- RECORD BEARING AND DISTANCE PER MOS 1593
- RECORD BEARING AND DISTANCE PER MOS 1548
- RECORD BEARING AND DISTANCE PER MOS 286
- RECORD BEARING AND DISTANCE PER MOS 1470
- DEED RECORD BEARING AND DISTANCE
- FOUND MONUMENT FROM RECORDED SURVEY NO. SURVEY NO. APPEARS IN BOX

RECEIVED AND FILED MAY 31,2005 OFFICE OF COUNTY SURVEYOR

REGISTERED **PROFESSIONAL** LAND SURVEYOR

Michael C Spring OREGON JULY 9, 2002 MICHAEL C. SPRINGER

#70918 EXPIRES: 6/30/2006

#### BAGETT, GRIFFITH & BLACKMAN 217 N. Canyon Blvd. John Day, Oregon

MAP OF SURVEY
DEPENDENT RESURVEY AND SUBDIVISION
SITUATED IN THE SW1/4 SECTION 35,
T.13S., R.31E., W.M.,

GRANT COUNTY, OREGON

SURVEYED FOR DAVID LUNDY & MEL PLEMMONS SURVEYED BY MCS & JLH 5/17/2005 Drawn by: MCS Scale: 1"=300'