

Scale 1"=50'

BASIS OF BEARINGS

Survey No. 354

LEGEND

- Found 5/8" iron pin with attached red plastic cap, See Survey No. 1699.
- Found 5/8" iron pin, See Survey No. 354.
- Set 5/8"x30" iron pin with attached red plastic cap marked CORNERSTONE SURVEYING, INC.
- X—X Fence Line
- () Record bearing and distance.


NARRATIVE

This survey was performed at the request of Philip Merricks. The purpose of this survey was to locate selected corners of Mr. Merricks property as described in Instrument No. 050381, deeds of Grant County.

The corners of this property were previously established in Survey No. 354. I found the monuments shown on this plat and accepted them. The iron pin at the SW corner was found badly bent. I straightened the pin and re-placed it where it was found. The SE corner was missing. I held the record bearing from the SW corner and intersected the easterly boundary line to re-established the position.

RECEIVED AND
FILED

JUNE 8, 2005
OFFICE OF COUNTY SURVEYOR
Attest: *Michael C. Springer*

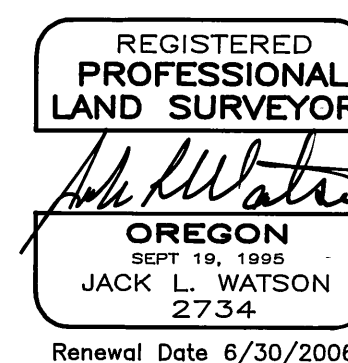

CORNERSTONE SURVEYING, Inc.
233 S. Canyon Blvd., John Day, Oregon 97845
(541) 575-1813

MAP OF SURVEY SITUATED IN THE NE1/4 AND SE1/4 OF SECTION 1, T9S, R27E, W.M. IN COCHRAN'S 1ST AND 2ND ADDITION TO THE TOWN OF MONUMENT	
GRANT COUNTY, OREGON	
SURVEYED FOR: Philip Merricks	
SURVEYED BY : Jack Watson	Date: 5/31/2005
DRAWN BY : Jack Watson	

MAP OF SURVEY NO. 1734