


Right of Way
Curve Data
 $\Delta=00^{\circ}09'34''$
 $R=766.20$
 $L=2.13$
 $LC=2.13$
 $N52^{\circ}40'42''E$

Highway No. 26



Point being $S00^{\circ}32'30''E$ 1006.00' and $S89^{\circ}27'30''W$ 481.90', record is 1006.0' south and 481.90' west, from the NE corner of Section 30. The section corner is monumented with a $1\frac{1}{2}''$ iron pipe and Grant County Surveyor brass cap.

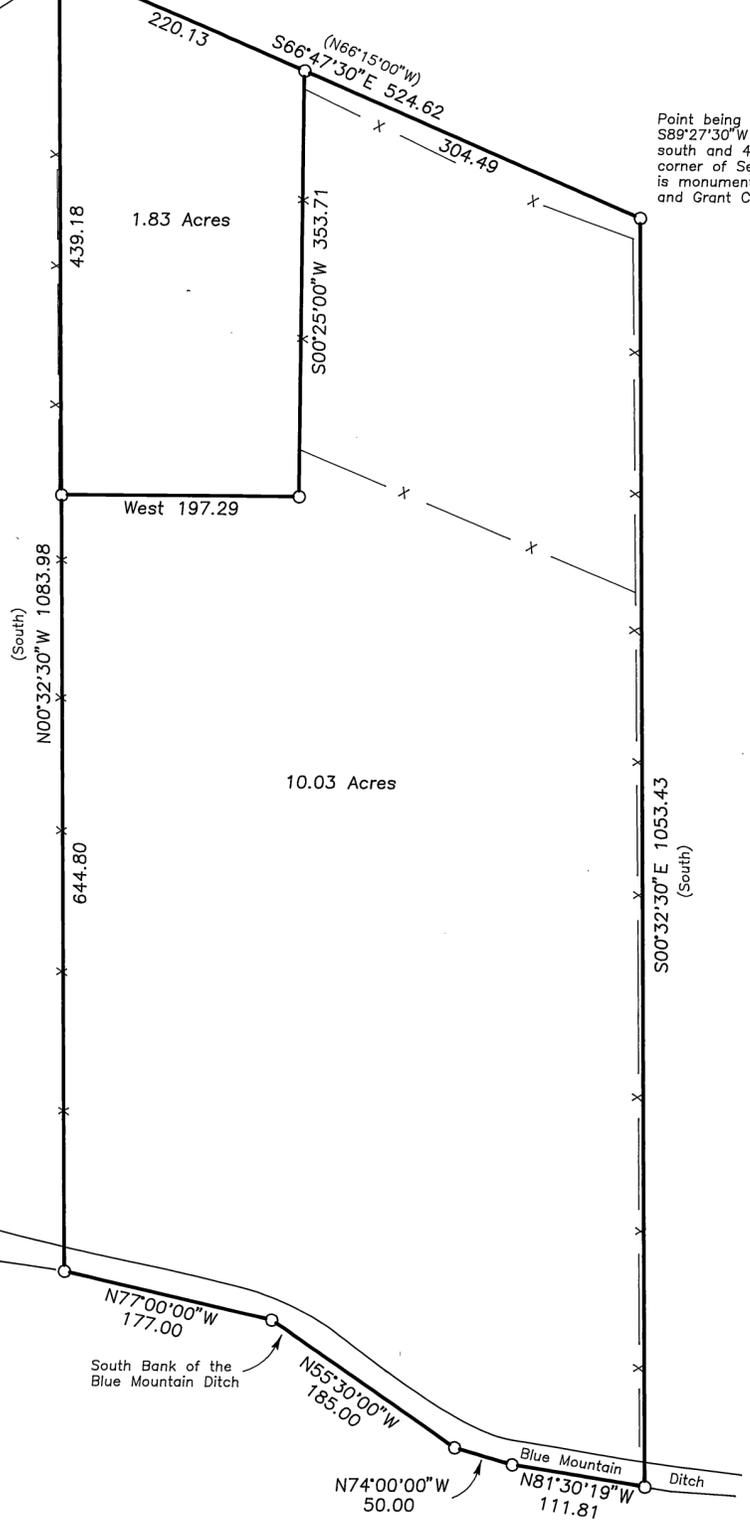

Scale 1"=100'

LEGEND

- \circ Set $5/8'' \times 30''$ iron pin with attached red plastic cap marked CORNERSTONE SURVEYING, INC.
- X—X Fence Line
- () Record bearing and distance.

NARRATIVE

This survey was performed at the request of Robert Pugh. The purpose of this survey was a boundary adjustment with Gilda McKinney.

This survey was performed using static GPS receivers and Electronic Total Station. The bearings for this survey are based on the GPS survey. The GPS survey was made in NAD 83 State Plane Coordinates, Oregon North Zone. The State Plane bearings were rotated clockwise $00^{\circ}57'42''$ to true north at the NE corner of Section 30, T13S, R30E. All Bearings are relative to this local north meridian.

A search was made of the available records pertaining to this survey. Field measurements were made to locate the existing improvements and to establish the new boundaries. The deed record bearings were rotated counterclockwise $00^{\circ}32'30''$. The highway center line was located and the centerline data from highway drawing 7B-20-6 was rotated clockwise $00^{\circ}08'17''$. I held the deed record distances to position the boundaries of these two tracts. The new boundaries are at positions which both parties have agreed upon.

RECEIVED AND FILED

JUNE 17, 2005
 OFFICE OF COUNTY SURVEYOR
 Grant County, Oregon
 Robert P. [Signature]

REGISTERED
 PROFESSIONAL
 LAND SURVEYOR
 [Signature]
 OREGON
 SEPT 19, 1995
 JACK L. WATSON
 2734
 Renewal Date 6/30/2006



CORNERSTONE SURVEYING, Inc.
 233 S. Canyon Blvd., John Day, Oregon 97845
 (541) 575-1813

MAP OF SURVEY BOUNDARY ADJUSTMENT SITUATED IN THE NE1/4 OF SECTION 30 T13S, R30E, W.M. GRANT COUNTY, OREGON	
SURVEYED FOR: Robert Pugh	
SURVEYED BY : Jack Watson	Date: 6/9/2005
DRAWN BY : Jack Watson	

MAP of Survey No. 1735