

REFERENCES

RECORD MAP OF SURVEY NO.'S 272, 286 AND 1730

RECORD LAND PARTITION NO.'S 96-19 & 2005-09
DEED RECORD INSTRUMENT NO.'S 921442 & 043062

NARRATIVE

THIS SURVEY WAS PERFORMED AT THE REQUEST OF SUSAN GARRISON. THE PURPOSE OF THIS SURVEY WAS TO LOCATE AND MONUMENT THE PROPOSED PROPERTY LINE ADJUSTMENT BETWEEN PARCEL 2 AND PARCEL 3 OF LAND PARTITION PLAT NO. 96–19 AS SHOWN HEREON.

A SEARCH WAS MADE OF THE AVAILABLE RECORDS PERTAINING TO THIS SURVEY. I MADE FIELD MEASUREMENTS TO LOCATE APPURTENANT MONUMENTS SHOWN ON RECORD MAP OF SURVEY NO. 1730 AND RECORD LAND PARTITION PLAT NO. 96-19, AS SHOWN HEREON.

I SET NEW MONUMENTS AT POSITIONS APPROVED BY THE GARRISON'S AND ACCORDING TO THE EVIDENCE FOUND, AS SHOWN HEREON.




EXPIRES: 6/30/2006

RECEIVED AND FILED

JAN 27,2006 OFFICE OF COUNTY SURVEYOR

ATTEST: Jacon 2 Halfun

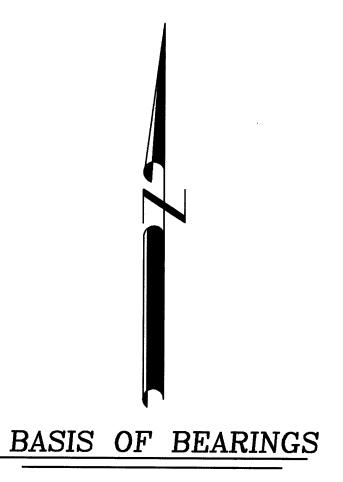

RECORD MAP OF SURVEY NO. 1730 AS SHOWN

LEGENI

- FOUND 2½" ALUMINUM PIPE WITH ATTACHED 2½"
 ALUMINUM CAP FROM RECORD LAND PARTITION
 PLAT NO. 96-19
- FOUND 5/8" IRON PIN WITH ATTACHED ALUMINUM CAP MARKED BGB SURVEY MARKER FROM RECORD MAP OF SURVEY NO. 1730
- FOUND 5/8" IRON PIN WITH ATTACHED RED PLASTIC CAP MARKED CORNERSTONE SURVEYING FROM RECORD LAND PARTITION PLAT NO. 96–19
- O SET 5/8"X30" IRON PIN WITH ATTACHED YELLOW PLASTIC CAP MARKED BGB SURVEY MARKER
- () RECORD BEARING AND DISTANCE FROM MAP OF SURVYEY NO. 1730
- 1() RECORD BEARING AND DISTANCE FROM MAP OF SURVEY NO. 272
- 3() RECORD BEARING AND DISTANCE FROM LAND PARTITION PLAT NO. 96-19
- 4() RECORD BEARING AND DISTANCE FROM LAND PARTITION PLAT NO. 2005-09

