


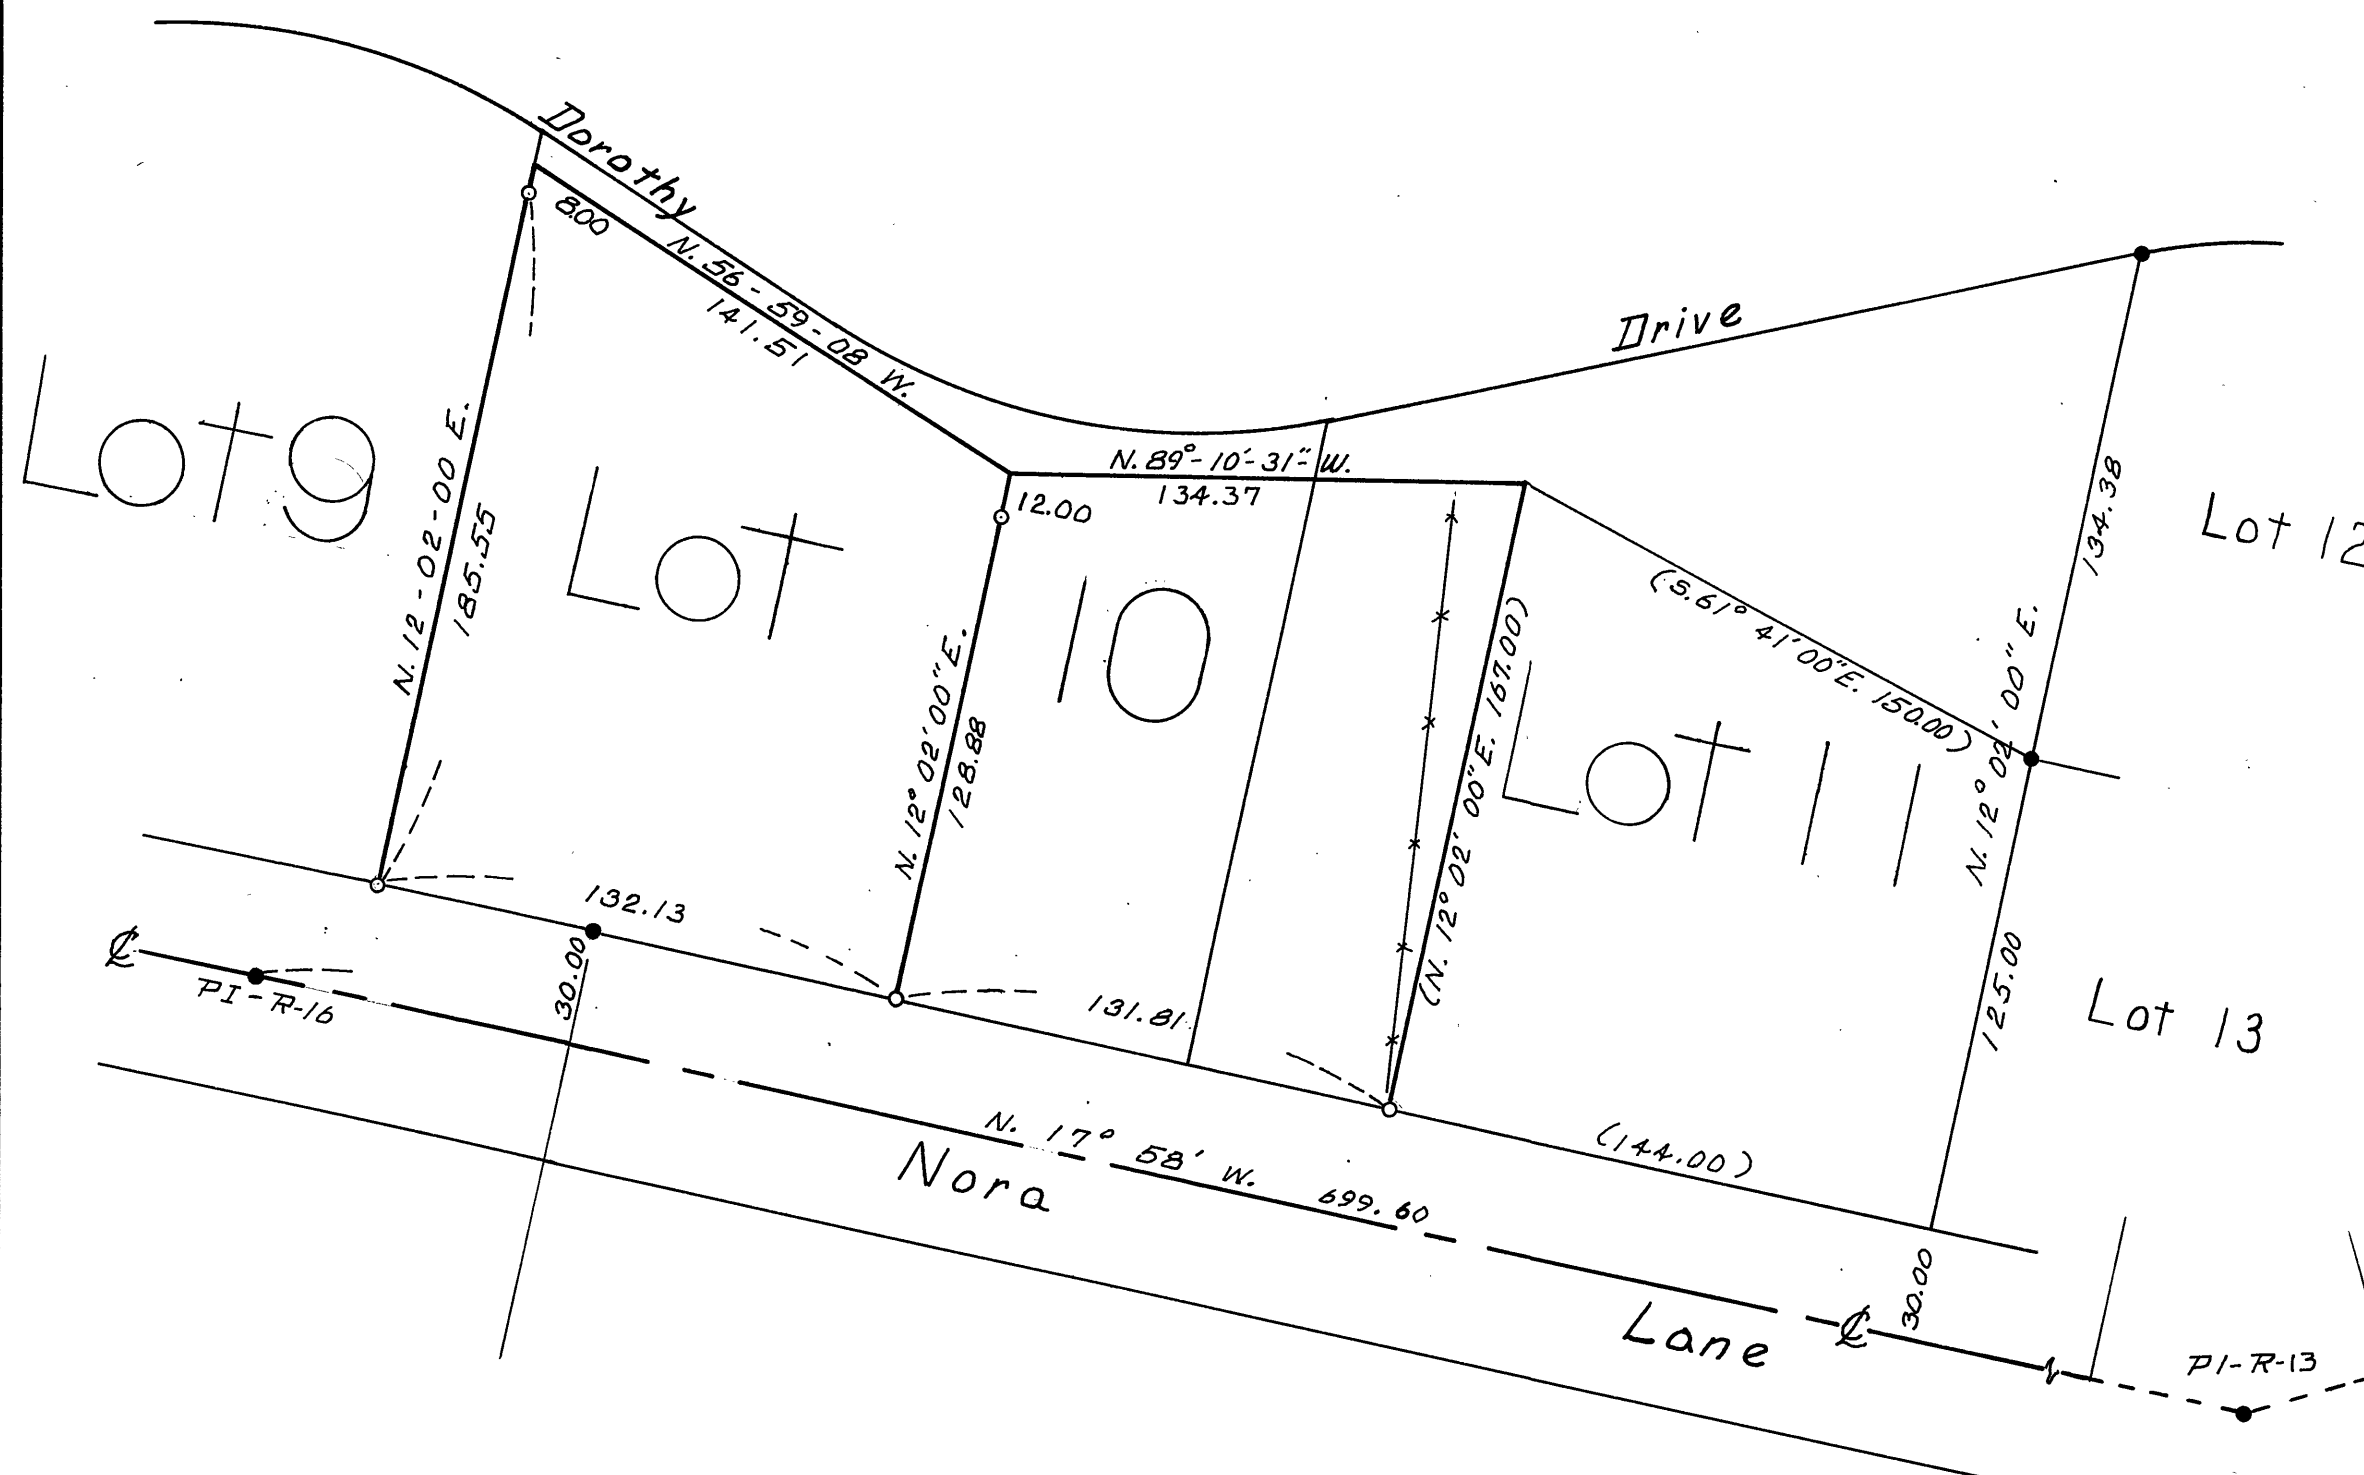

RECEIVED AND
FILED
APR 2 1970
JOHN LIVEIRA, County Clerk
By _____ Deputy

Basis of Bearings
Nora Lane from
R-13 to R-14

Legend

- o Fd. Monuments of Record
- o 1/2 x 24 Iron Pins Set this Survey
- xx Fence
- () Records Bearings and Distance

REGISTERED
OREGON
LAND SURVEYOR
Duane J. Griffith
JULY 10, 1964
DUANE J. GRIFFITH
644

BAGETT & GRIFFITH SURVEYING		
John Day, Oregon		
Map of Survey		
Portions of lots 10+11		
Block 2		
Hall Acres Subdivision		
Grant County, Oregon		
SURVEYED FOR	Bill Zickler	
SURVEYED BY	J.I.G.	Mar. 1970
Scale: 1"=50'	Drawn by: J.I.G.	Mar. 1970

Map of Survey no. 177