


BASIS OF BEARINGS
SOLAR OBSERVATIONS

REGISTERED
OREGON
LAND SURVEYOR

Duane I. Griffith

JULY 10, 1964
DUANE I. GRIFFITH
644

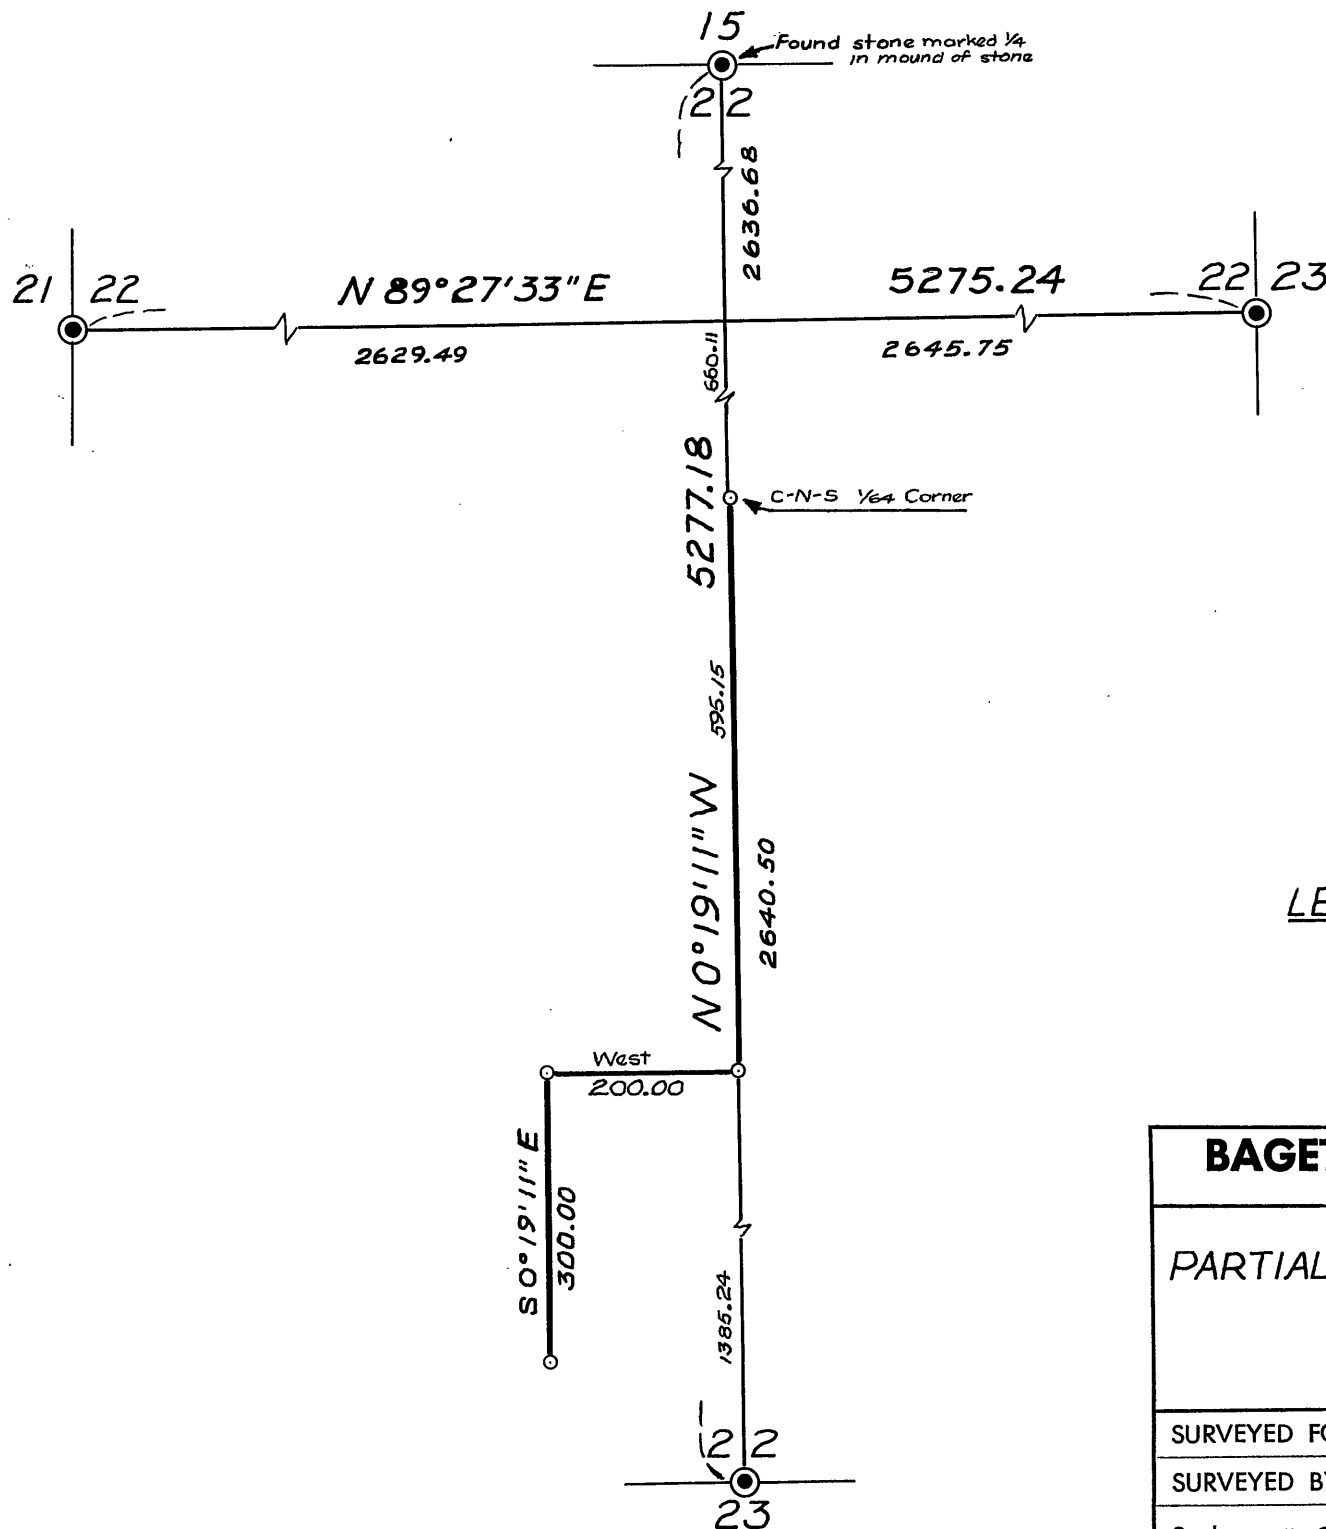

LEGEND

● FOUND MONUMENT

○ SET 5/8" x 30'

BAGETT & GRIFFITH

John Day, Ore

Map of Survey

PARTIAL SUBDIVISION
T13S R31E

GRANT COUNTY

SURVEYED FOR	HINES
SURVEYED BY	D.I.G. - A

Scale: 1" = 200'

Drawn by:

Map of Survey #